



Undirritun samræmingarhönnuðar:

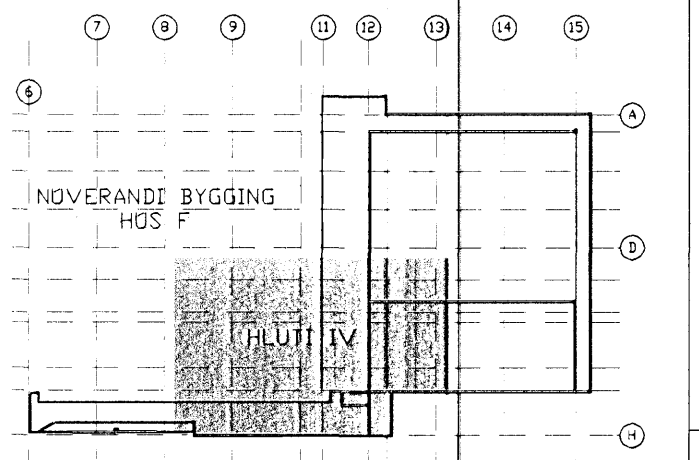

LYKILMYND


A	Raunteikning	22.09.2005
Nr.	Lýsing á breytingu	Dagur

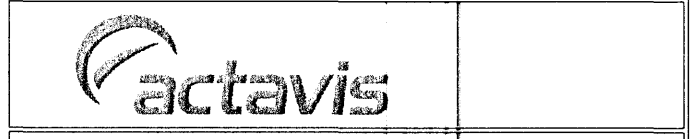

Reykjavíkurvegur 78, Hafnarfirði
 F-Verksmiðja - Stækun
 Loftfræstikerfi
 Grunnmynd - 2.Hæð - Hluti IV

Teikning nr. ISIF-M07/08/09/10-02-214-A

Dagur	12.04.2005	Kvarði	1:50	Blátt	Blátt	Verk nr.
Skjalnúmer	379-2H-Loftfræstikerfi.dwg					379

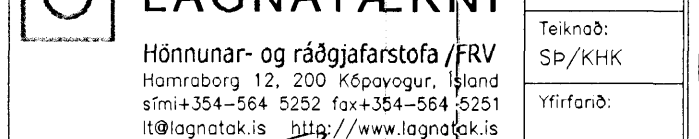

Hönnunar- og ráðgjafarstofa / FRV

Samp: *[Signature]*
 Kennitala: 200149-2749