



ASÝND C - C 1:20

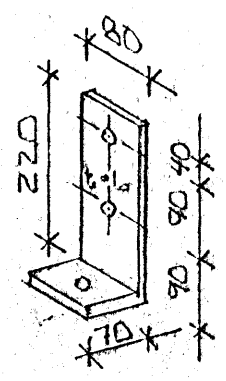

ÁSKILIÐ, ELÐRI  
SKÝRINGAR: TEIKNING ÓGILD

ALMENNAR SKÝRINGAR SJÁ BL.NR. 1-01.  
GRUNNMÝND PAKVÆKIS SJÁ BL.NR. 1-09

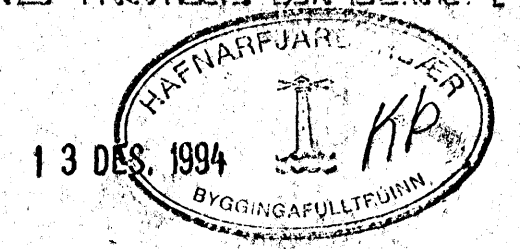

02	DES	VINKLAR A YFIRSTYKKI GLUGGA	EP
01	JAN'93	GLUGGA MÁSETNI BE	GH
BR.NR.	DAGS	EDLI BREVINGAR	SIGN.
BEJARHRAUN 18 HAFNARFJARÐAR			DAGS. FEBR. '90
ASÝND C - C A. SVÖLUM			HANNAÐ 7/7
MÆLIKV. 1:20			TEIKNAD 30
SIGURDUR ÞORLEIFSSON			VEKIS NR. 8829
STRANDGÖTU 11 HAFNARFJARÐAR SÍMI 54151			GLAÐNR. 1-10