


31/3 '10


TEIKNING Í SAMHÆMI V/H
 ARKITEKTATEIKNINGAR
 dags: 28.04.06
 undirskrift: *Ragnar Klau*
 kt: 240448-2469

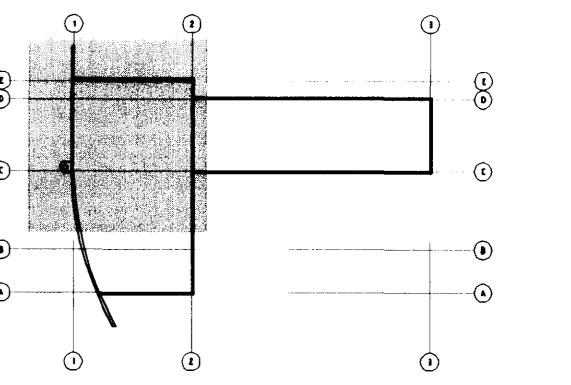

ÚTGÁFUFRILL					
NR:	DAGS:	SKÝRINGAR:	HA:	YF:	SP:
A	30.10.09	REYNDARTEIKNING	HaM	KS	
DAGS. UNDIRSKRIFTAR:		NAFN OG KT. SAMRÆMINGARHÖNNUDAR:			


MANNVIT
 VERKFRÆDISTOFA
 GREINÁSASVEGI 1, 108 REYKJAVÍK, Sími: 422 3000, FAX: 422 3001
 VEFANG: www.mannvit.is NETFANG: mannvit@mannvit.is

HEITI VERKS:
DÆLU- OG HREINSISTÖÐ
 HRAUNAVÍK,
 HAFNAFIRÐI
 HEITI TEIKNINGAR:
 LAMPAR OG STRENGSTIGAR
 SÍUR OG DÆLUR
 GRUNNMYND KJALLARI HLUTI 2

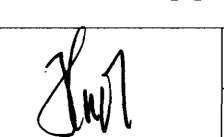DAGS:	28.04.06	HANNAÐ / TEIKNAD:	HaM	TEIKNINGANÚMÉR:	
MKV:	1:50	YFIRFARID:	A1	R-502	
SAMÞYKKT / KT:	<i>Ragnar Klau</i> Kt: 220761-3370			VERKNÚMÉR:	2.041.130
				ÚTGÁFA:	A