


30/3 '10

TEIKNING I SAMHAFIN
 ARKITEKTATEIKNINGAR
 dags: 2.10.10
 undirskrift: *Þórunn Halldóttir*
 kt: 240448-2469

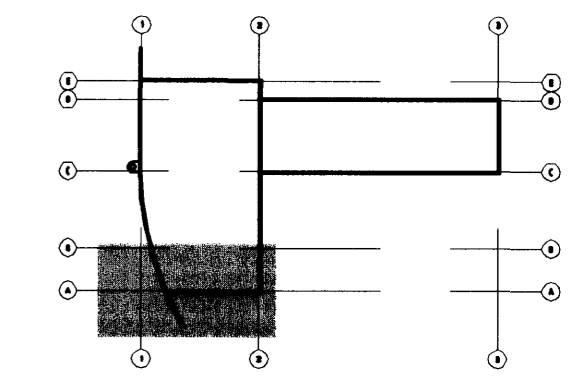

NR:	DAGS:	SKÝRINGAR:	HA:	YF:	SP:
A	28.02.08	ALM. BREYTING	HaM	KS	
B	30.10.09	REYNDARTEIKNING	HaM	KS	

DAGS. UNDIRSKRIFTAR: NAFN OG KT. SAMRÆMINGARHÖNNUÐAR:



GRENASVEGI 1, 108 REYKJAVÍK, Sími: 422 3000, FAX: 422 3001
 VEFANG: www.mannvit.is NETFANG: mannvit@mannvit.is

HEITI VERKS:
DÆLU- OG HREINSISTÖÐ
 HRAUNAVÍK,
 HAFNAFIRÐI

HEITI TEIKNINGAR:
 TÆKJASTADSETNING
 TÖFLURÝMI, STARFSMANNAADSTADA
 GRUNNM. JARD- OG 1.HÆÐ HLUTI 3

DAGS:	28.04.06	HANNAÐ / TEIKNAD:	KS	TEIKNINGANÚMÉR:	R-413
MKV:	1:50	YFIRFARÐ:	A1	VERKUNÚMÉR:	2.04.1.130
SAMPRYKT / KT:				ÚTGÁFA:	B

Þórunn Halldóttir
 2.10.10