


30/3 '10 *HL*

TEIKNING I SAMHÆMI VIT  
ARKITEKTATEIKNINGAR  
dags: 2.2.10  
undirskrift: *Ragnir Adami*  
kt: 240448-2469

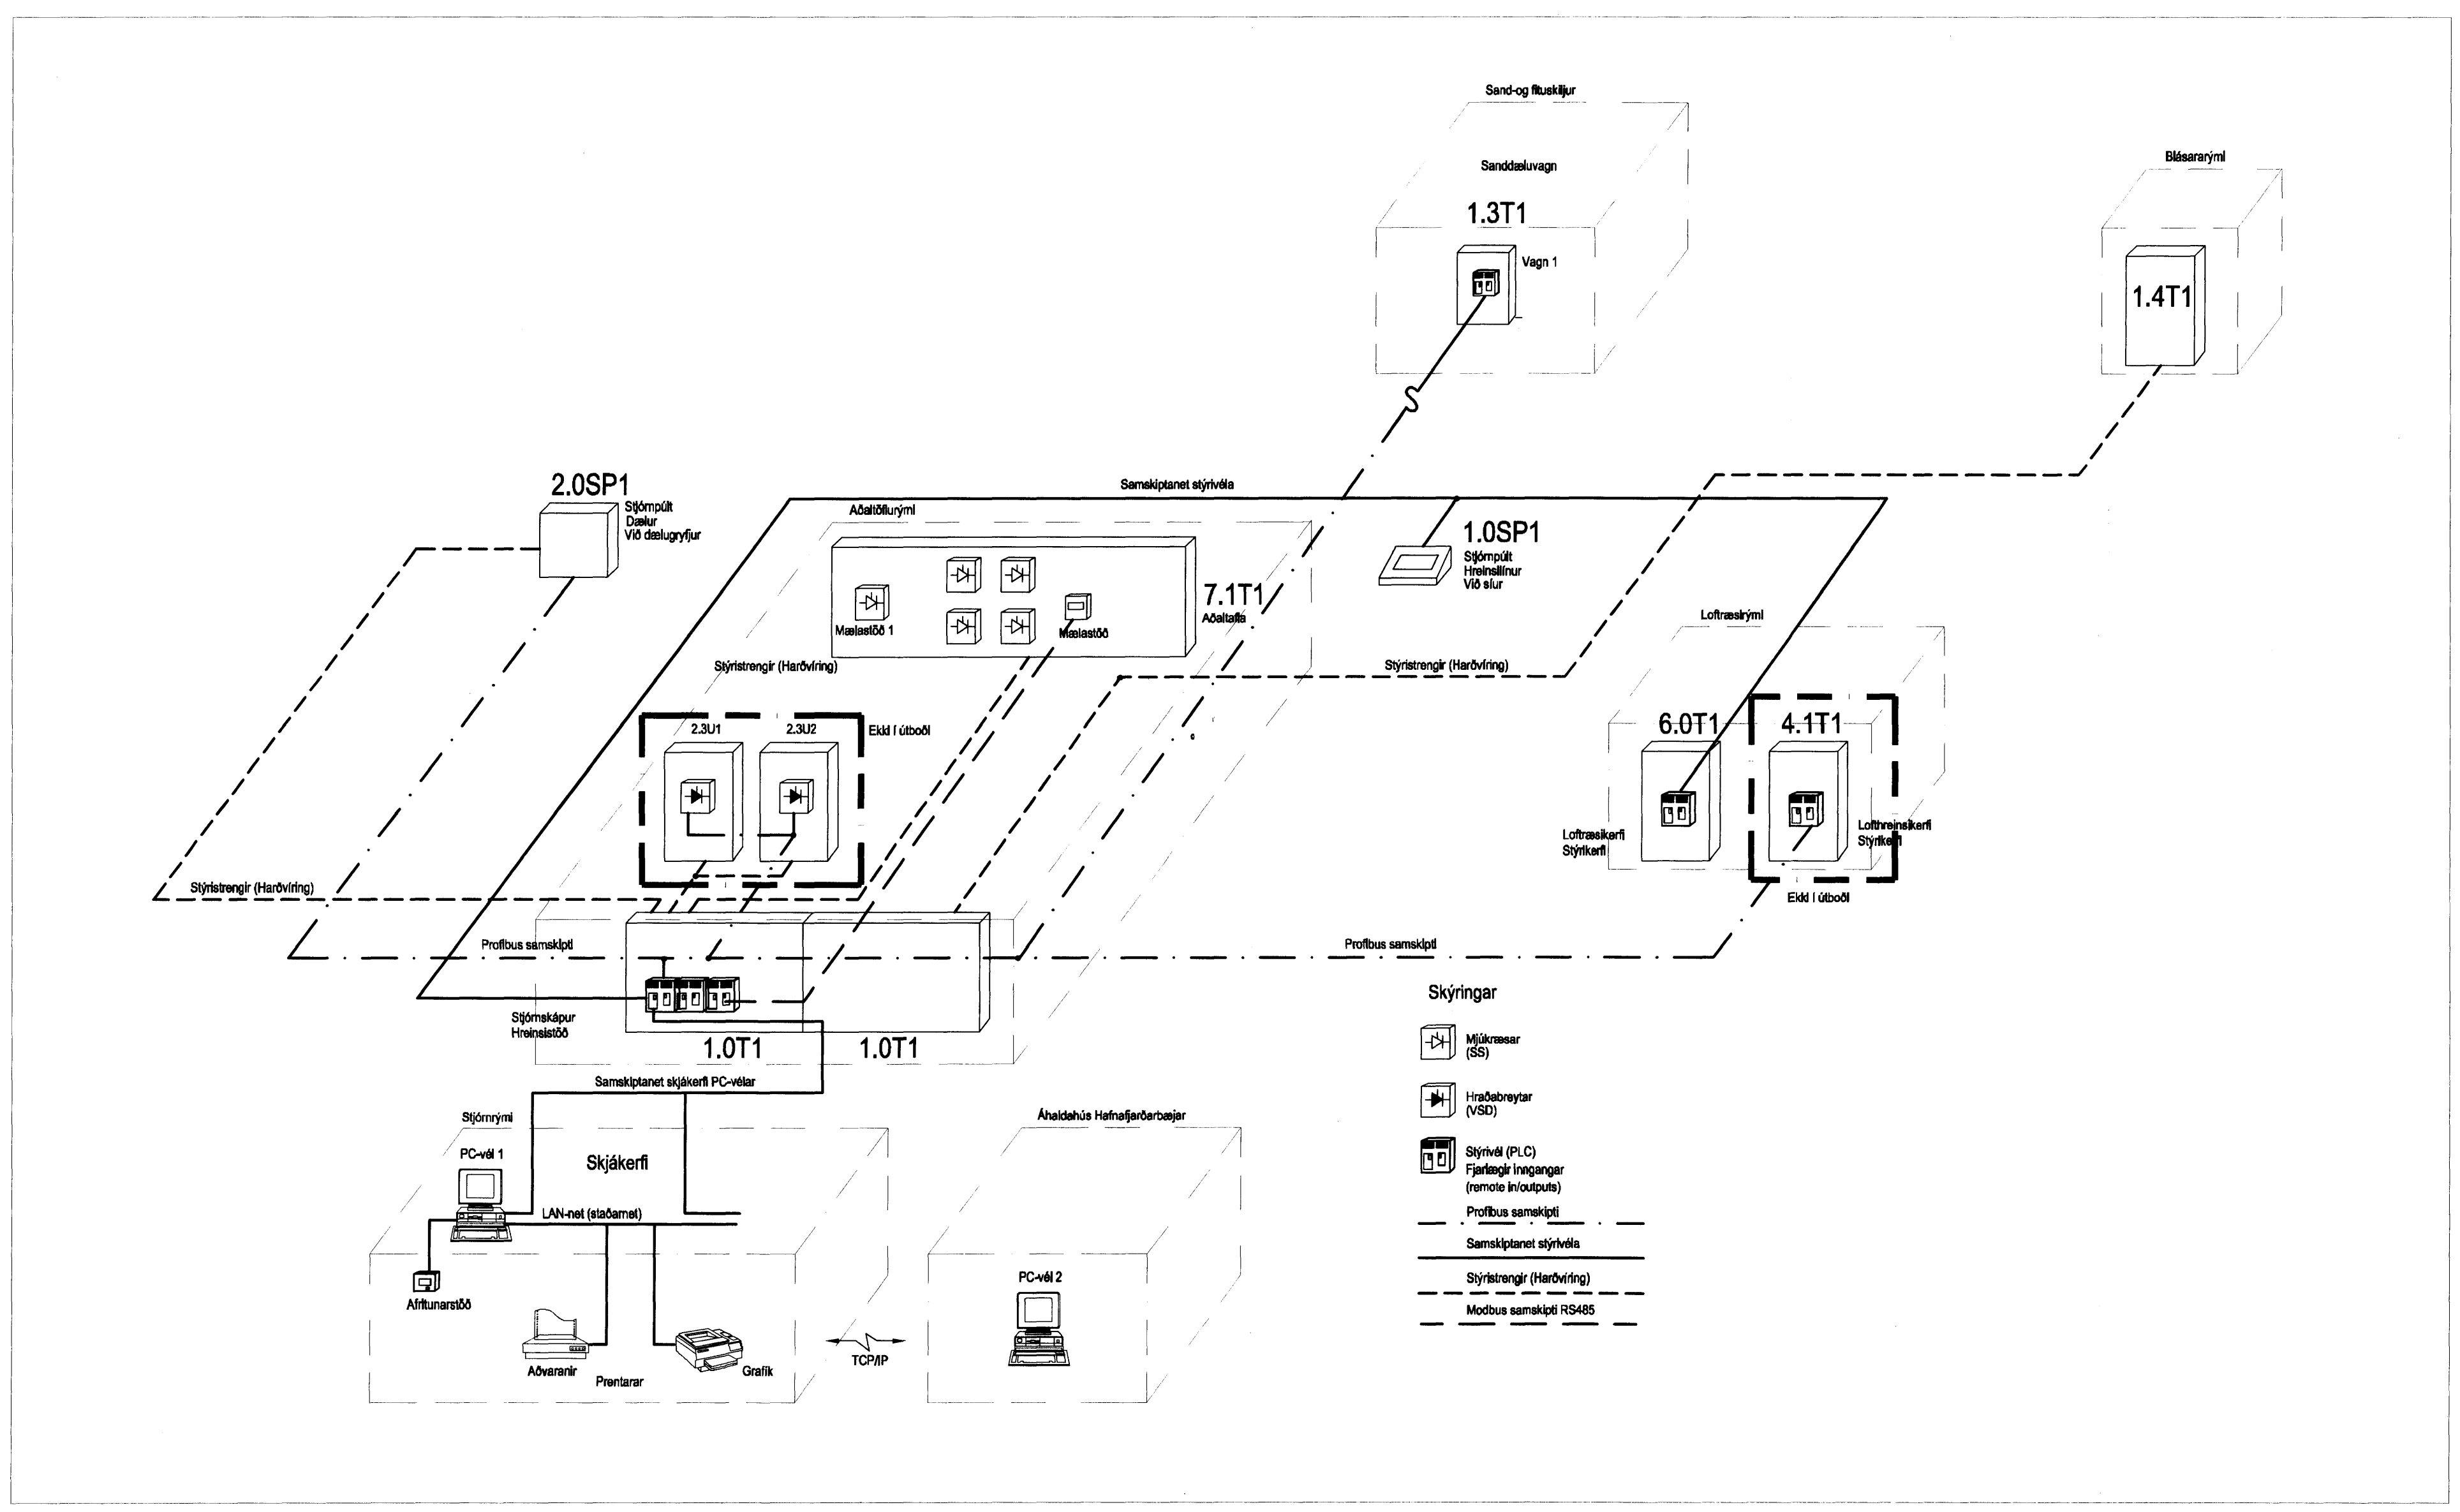

NR:	DAGS:	SKÝRINGAR:	ÚTGÁFUERILL	HA:	YF:	SR:
A	30.10.09	REYNDARTEIKNING		HaM	KS	

DAGS. UNDIRSKRIFTAR:      NAFN OG KT. SAMRÆMINGARHÖNNUNAR:



**MANNVIT**  
VERKFRÆDISTOFA

GREINÁSVEGI 1, 108 REYKJAVÍK, Sími: 422 3000, FAX: 422 3001  
VEFFANG: www.mannvit.is NETFANG: mannvit@mennvit.is

HEITI VERKS:  
**DÆLU- OG HREINSISTÖÐ**  
HRAUNAVÍK,  
HAFNAFIRÐI

HEITI TEIKNINGAR:  
KERFISMYND  
STJÓRNKERFI OG SKÁPAR

DAGS:	28.04.06	HANNAÐ/TEIKNAD:	TEIKNINGANÚMÉR:
MIKV:	A1	YFIRFARID:	HaM/KS GRB
SAMÞYKKT/KT:	<i>Ragnir Adami</i>		VERKUNUMÉR: 2.041.130
			UTGÁFA: A