
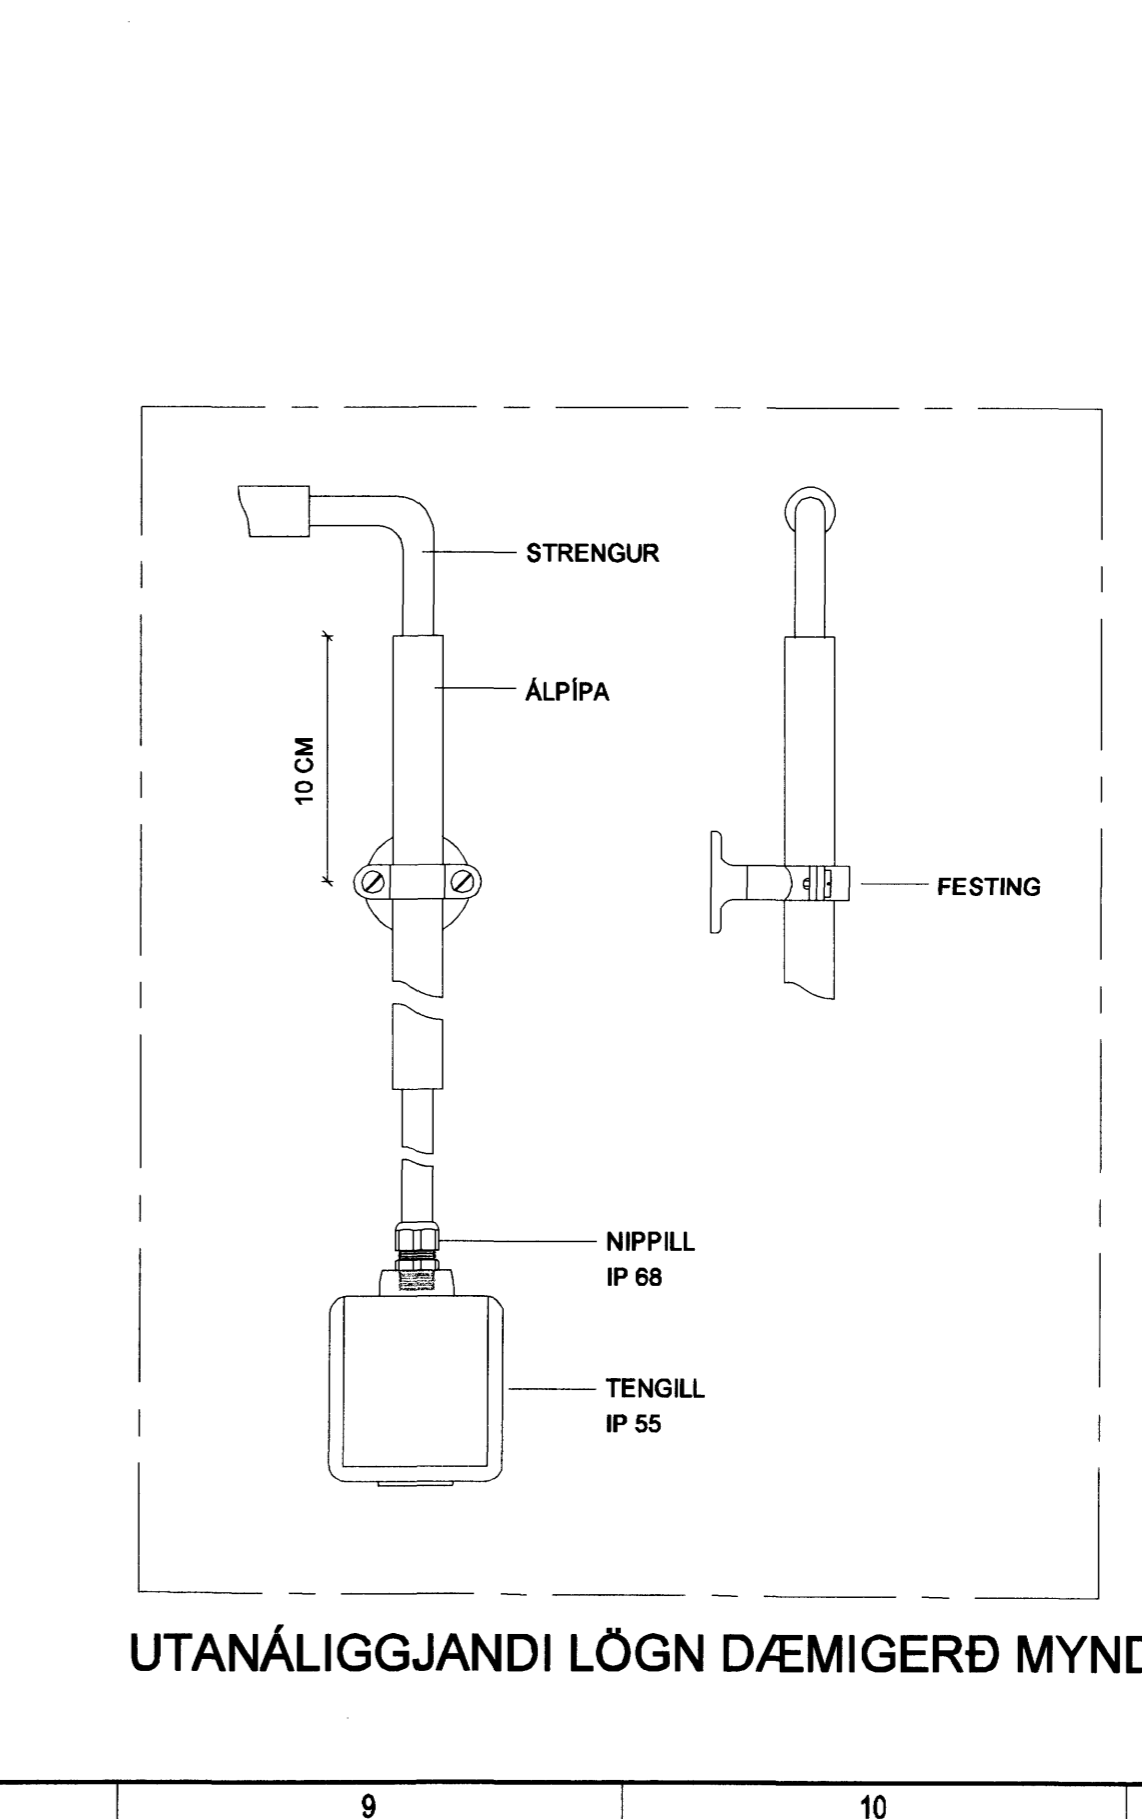
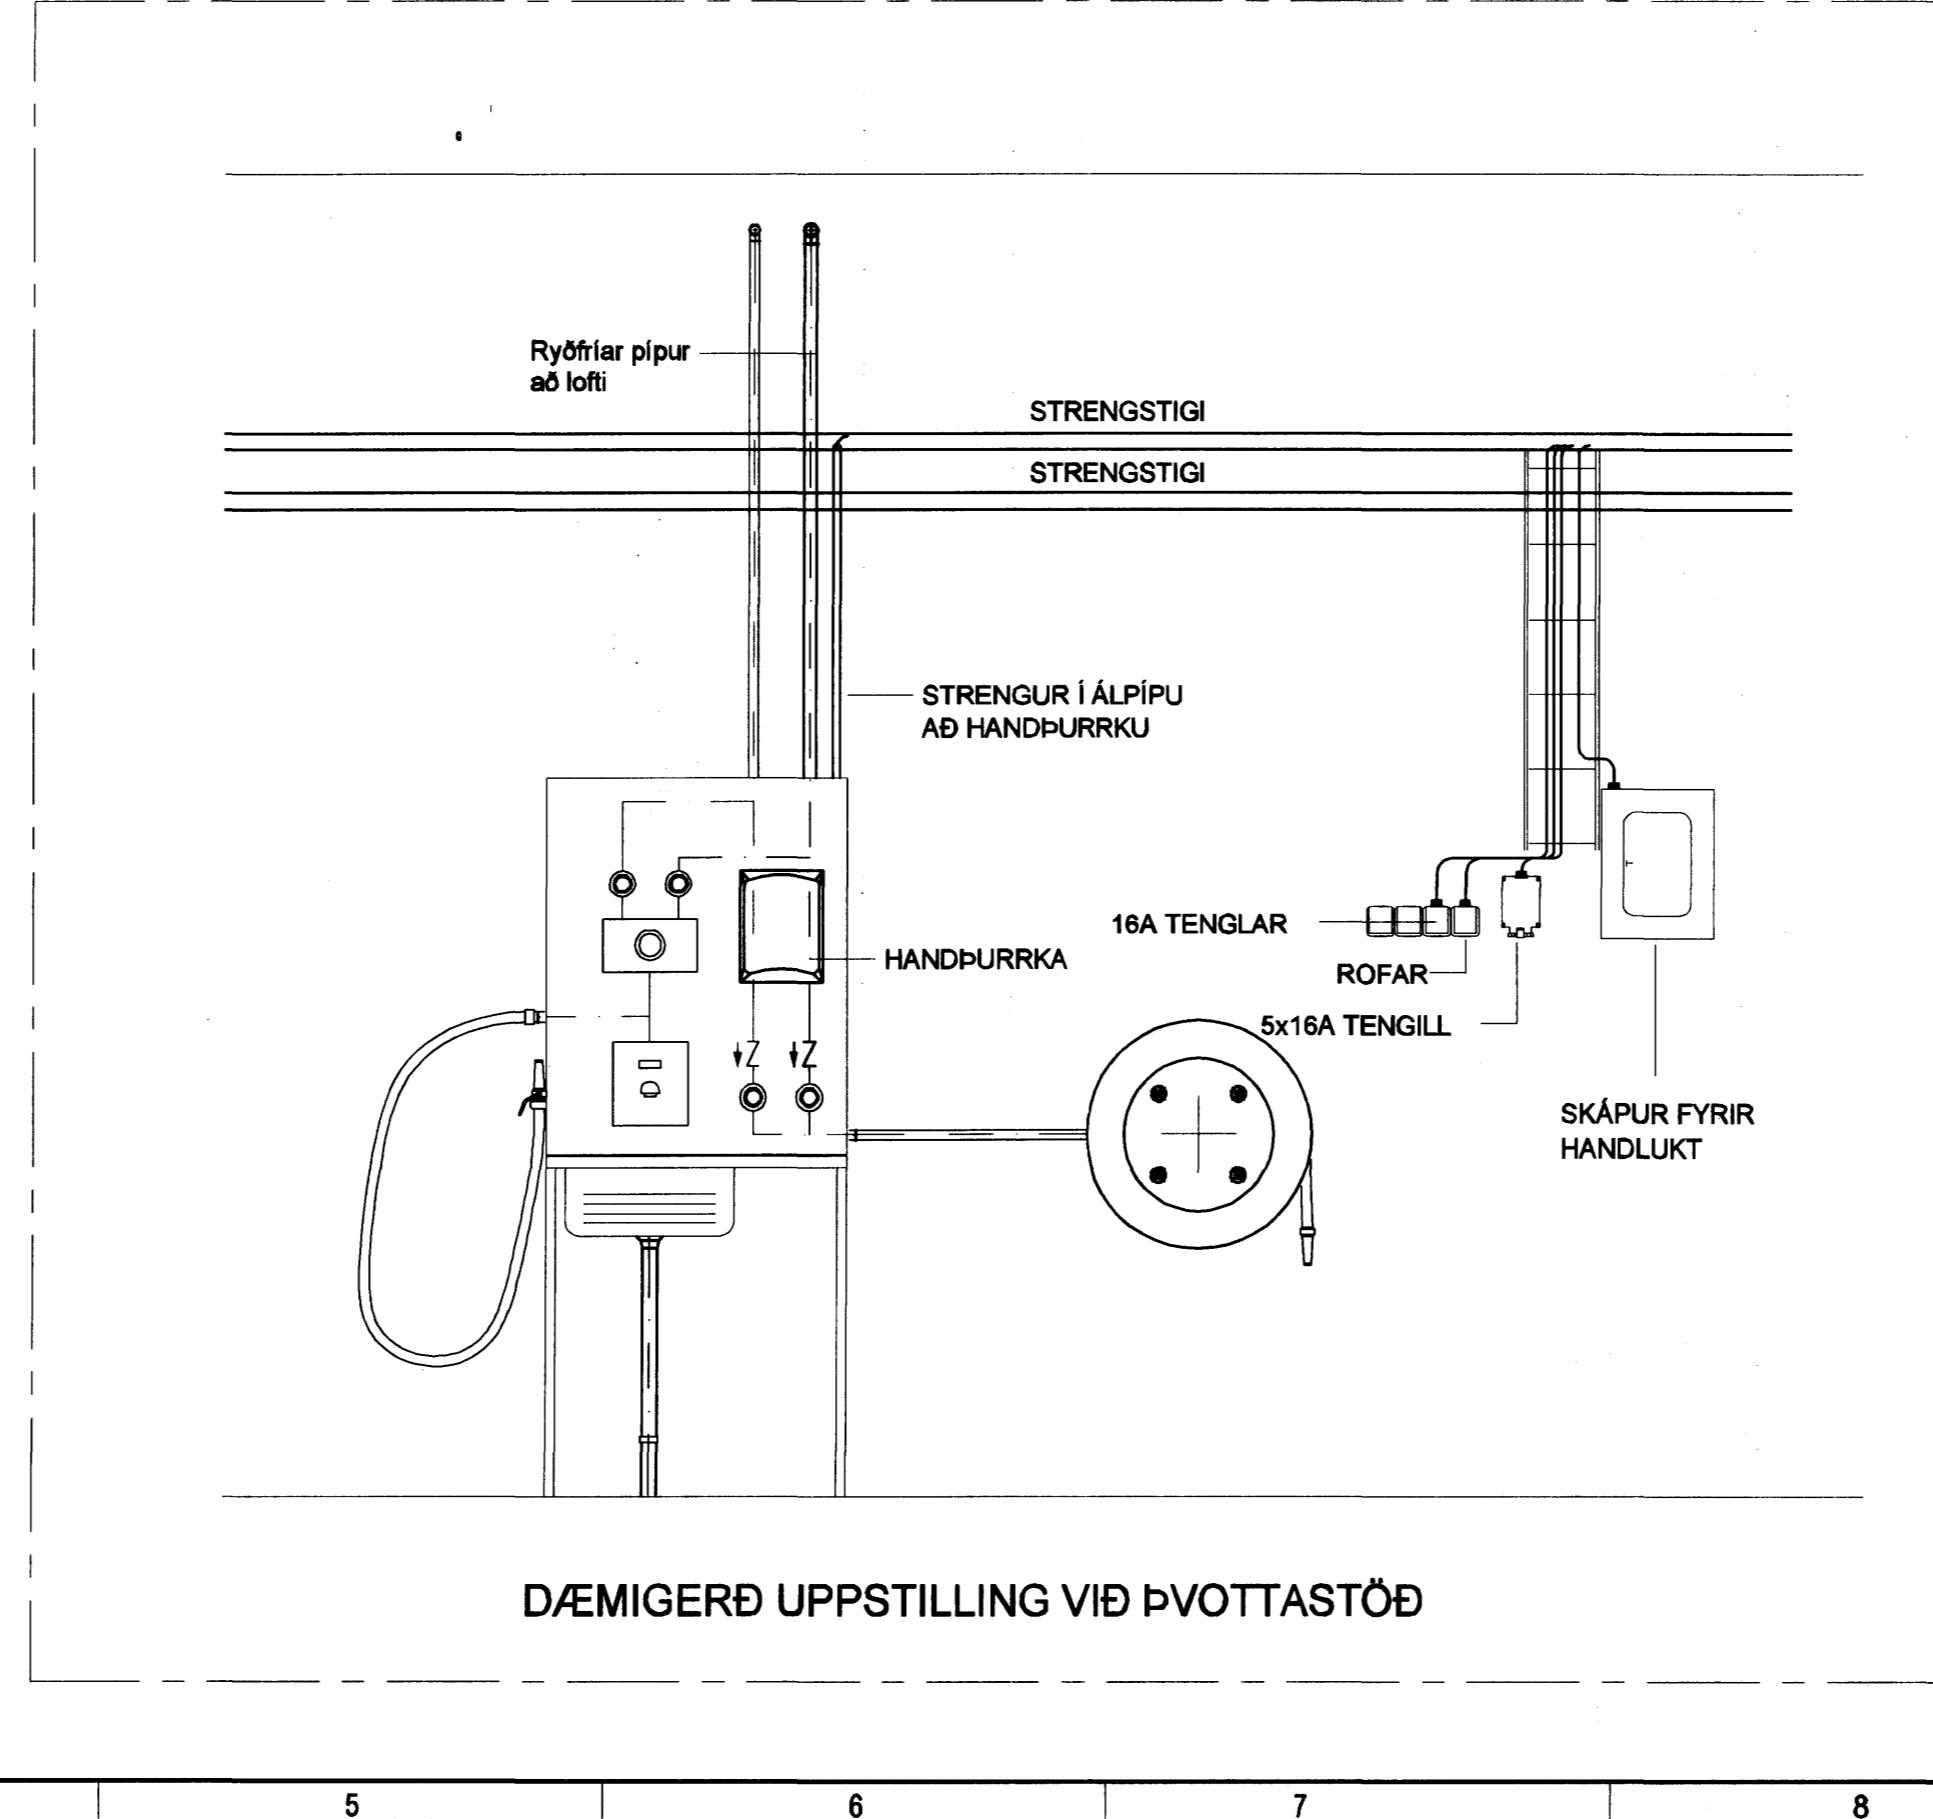
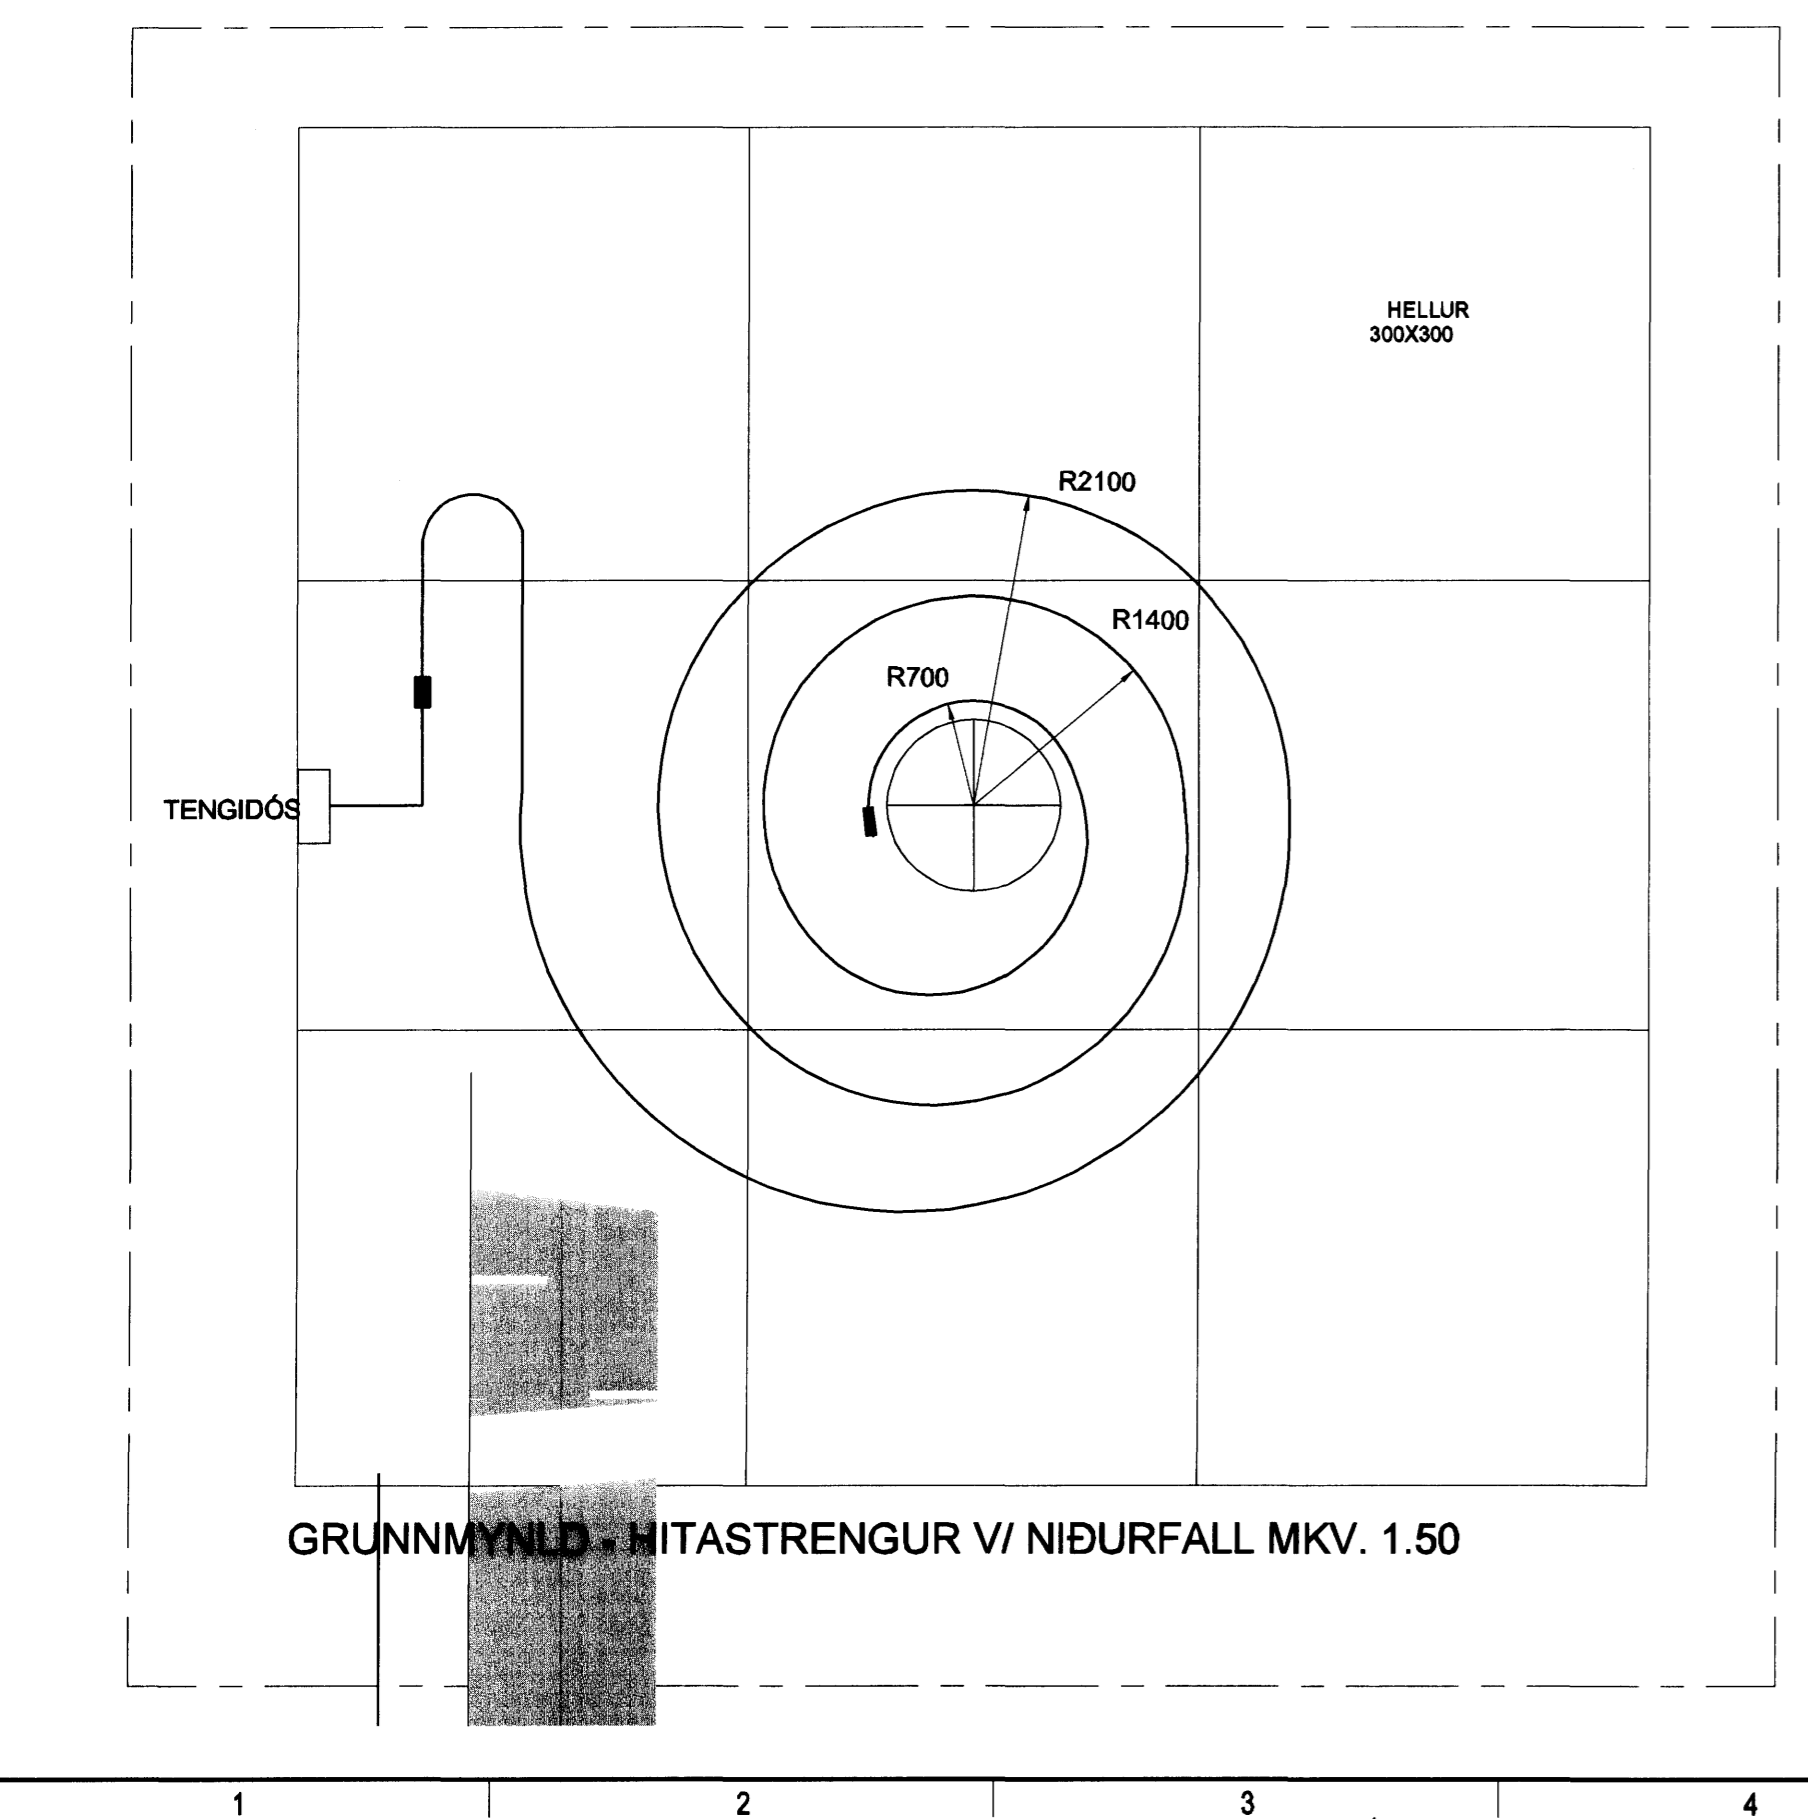
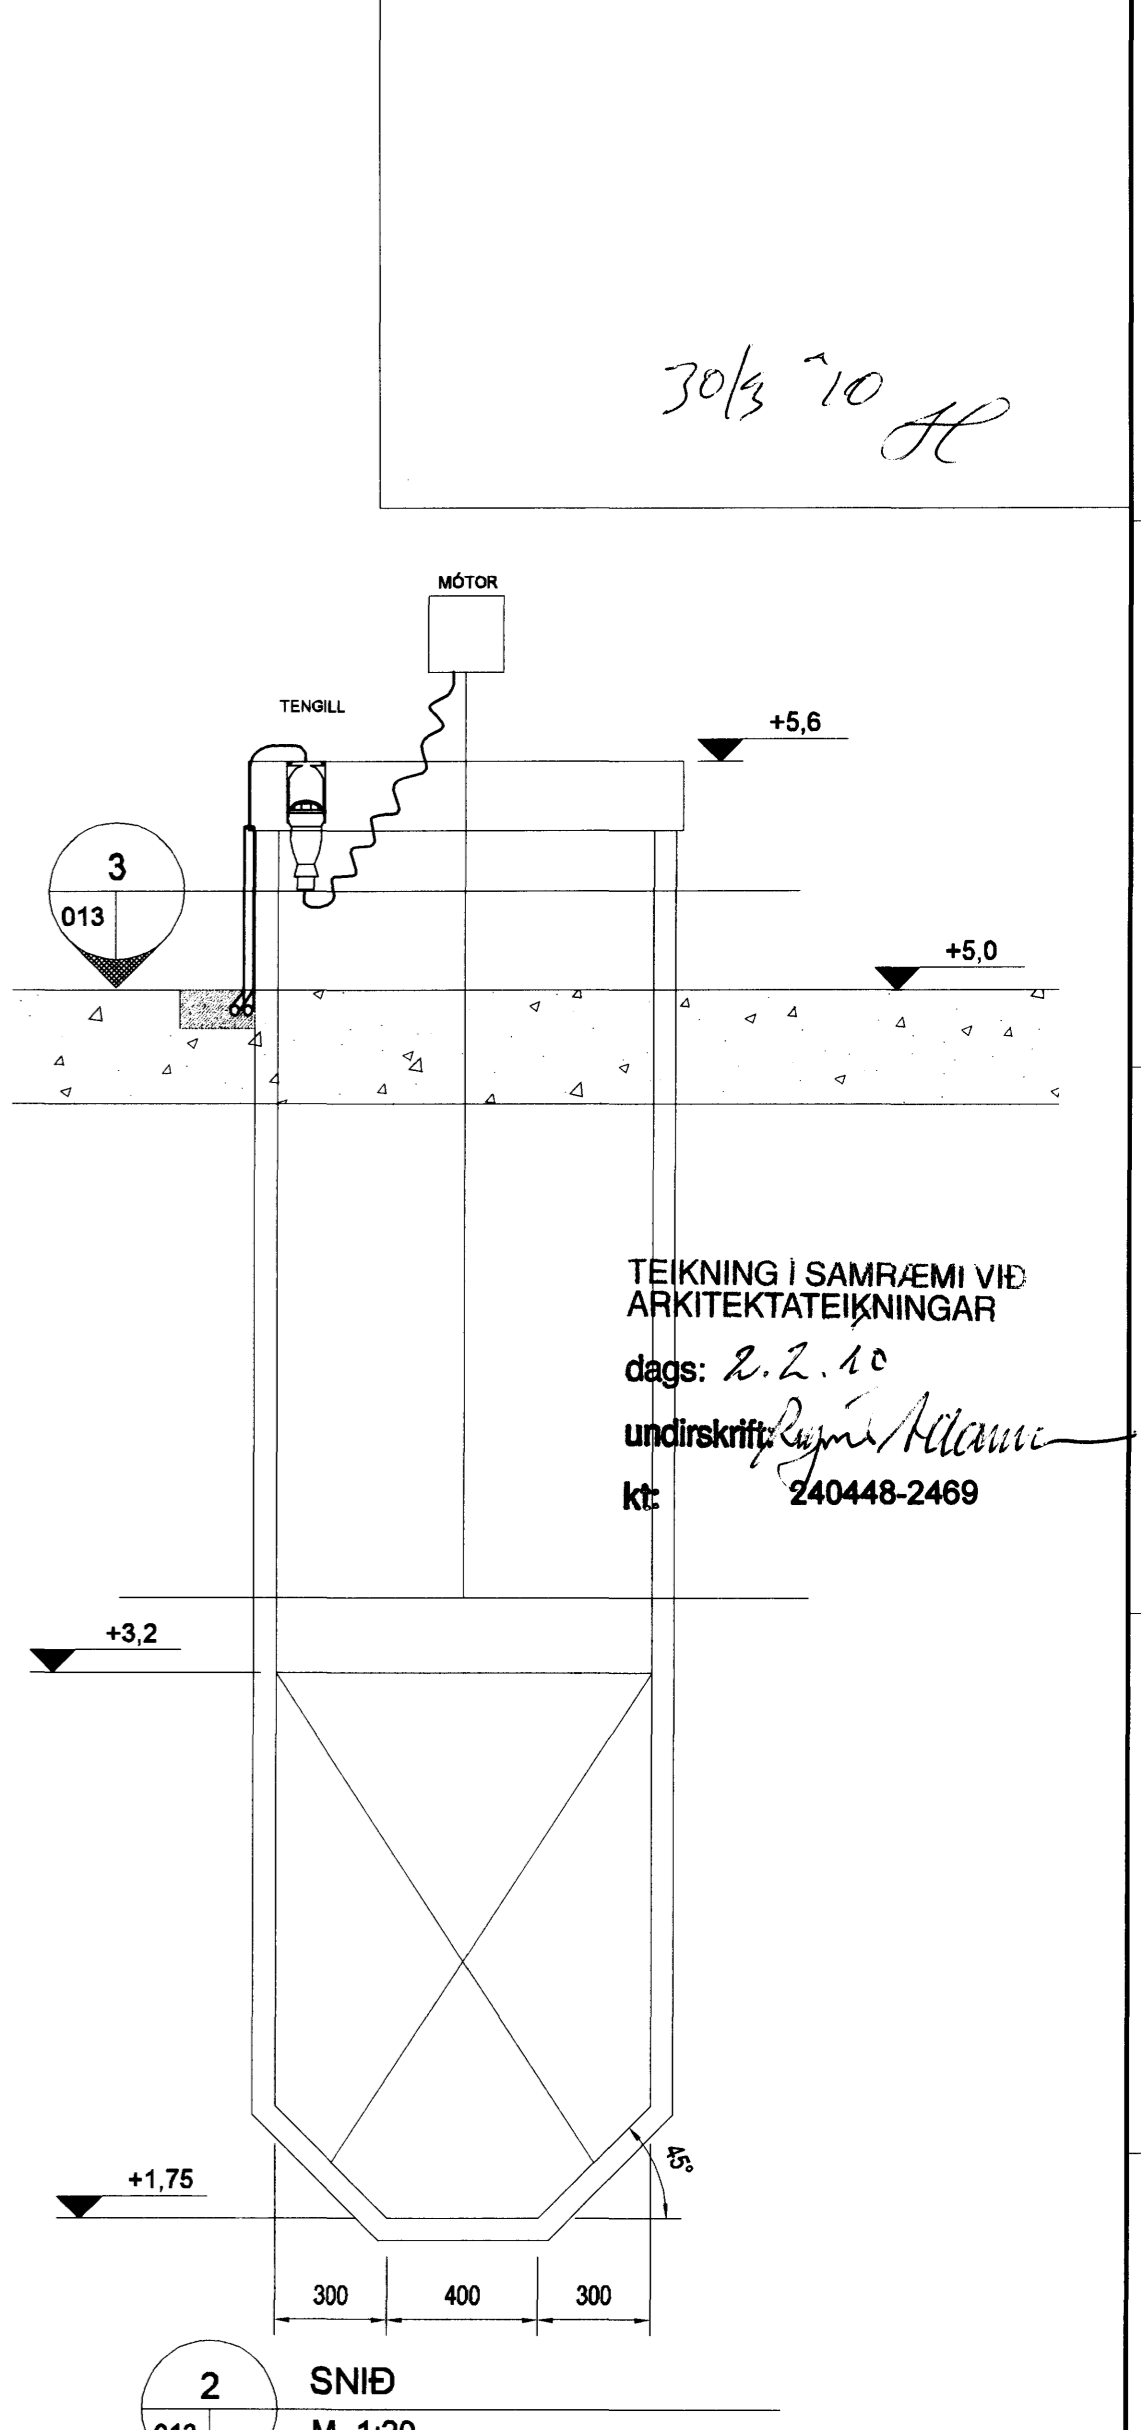
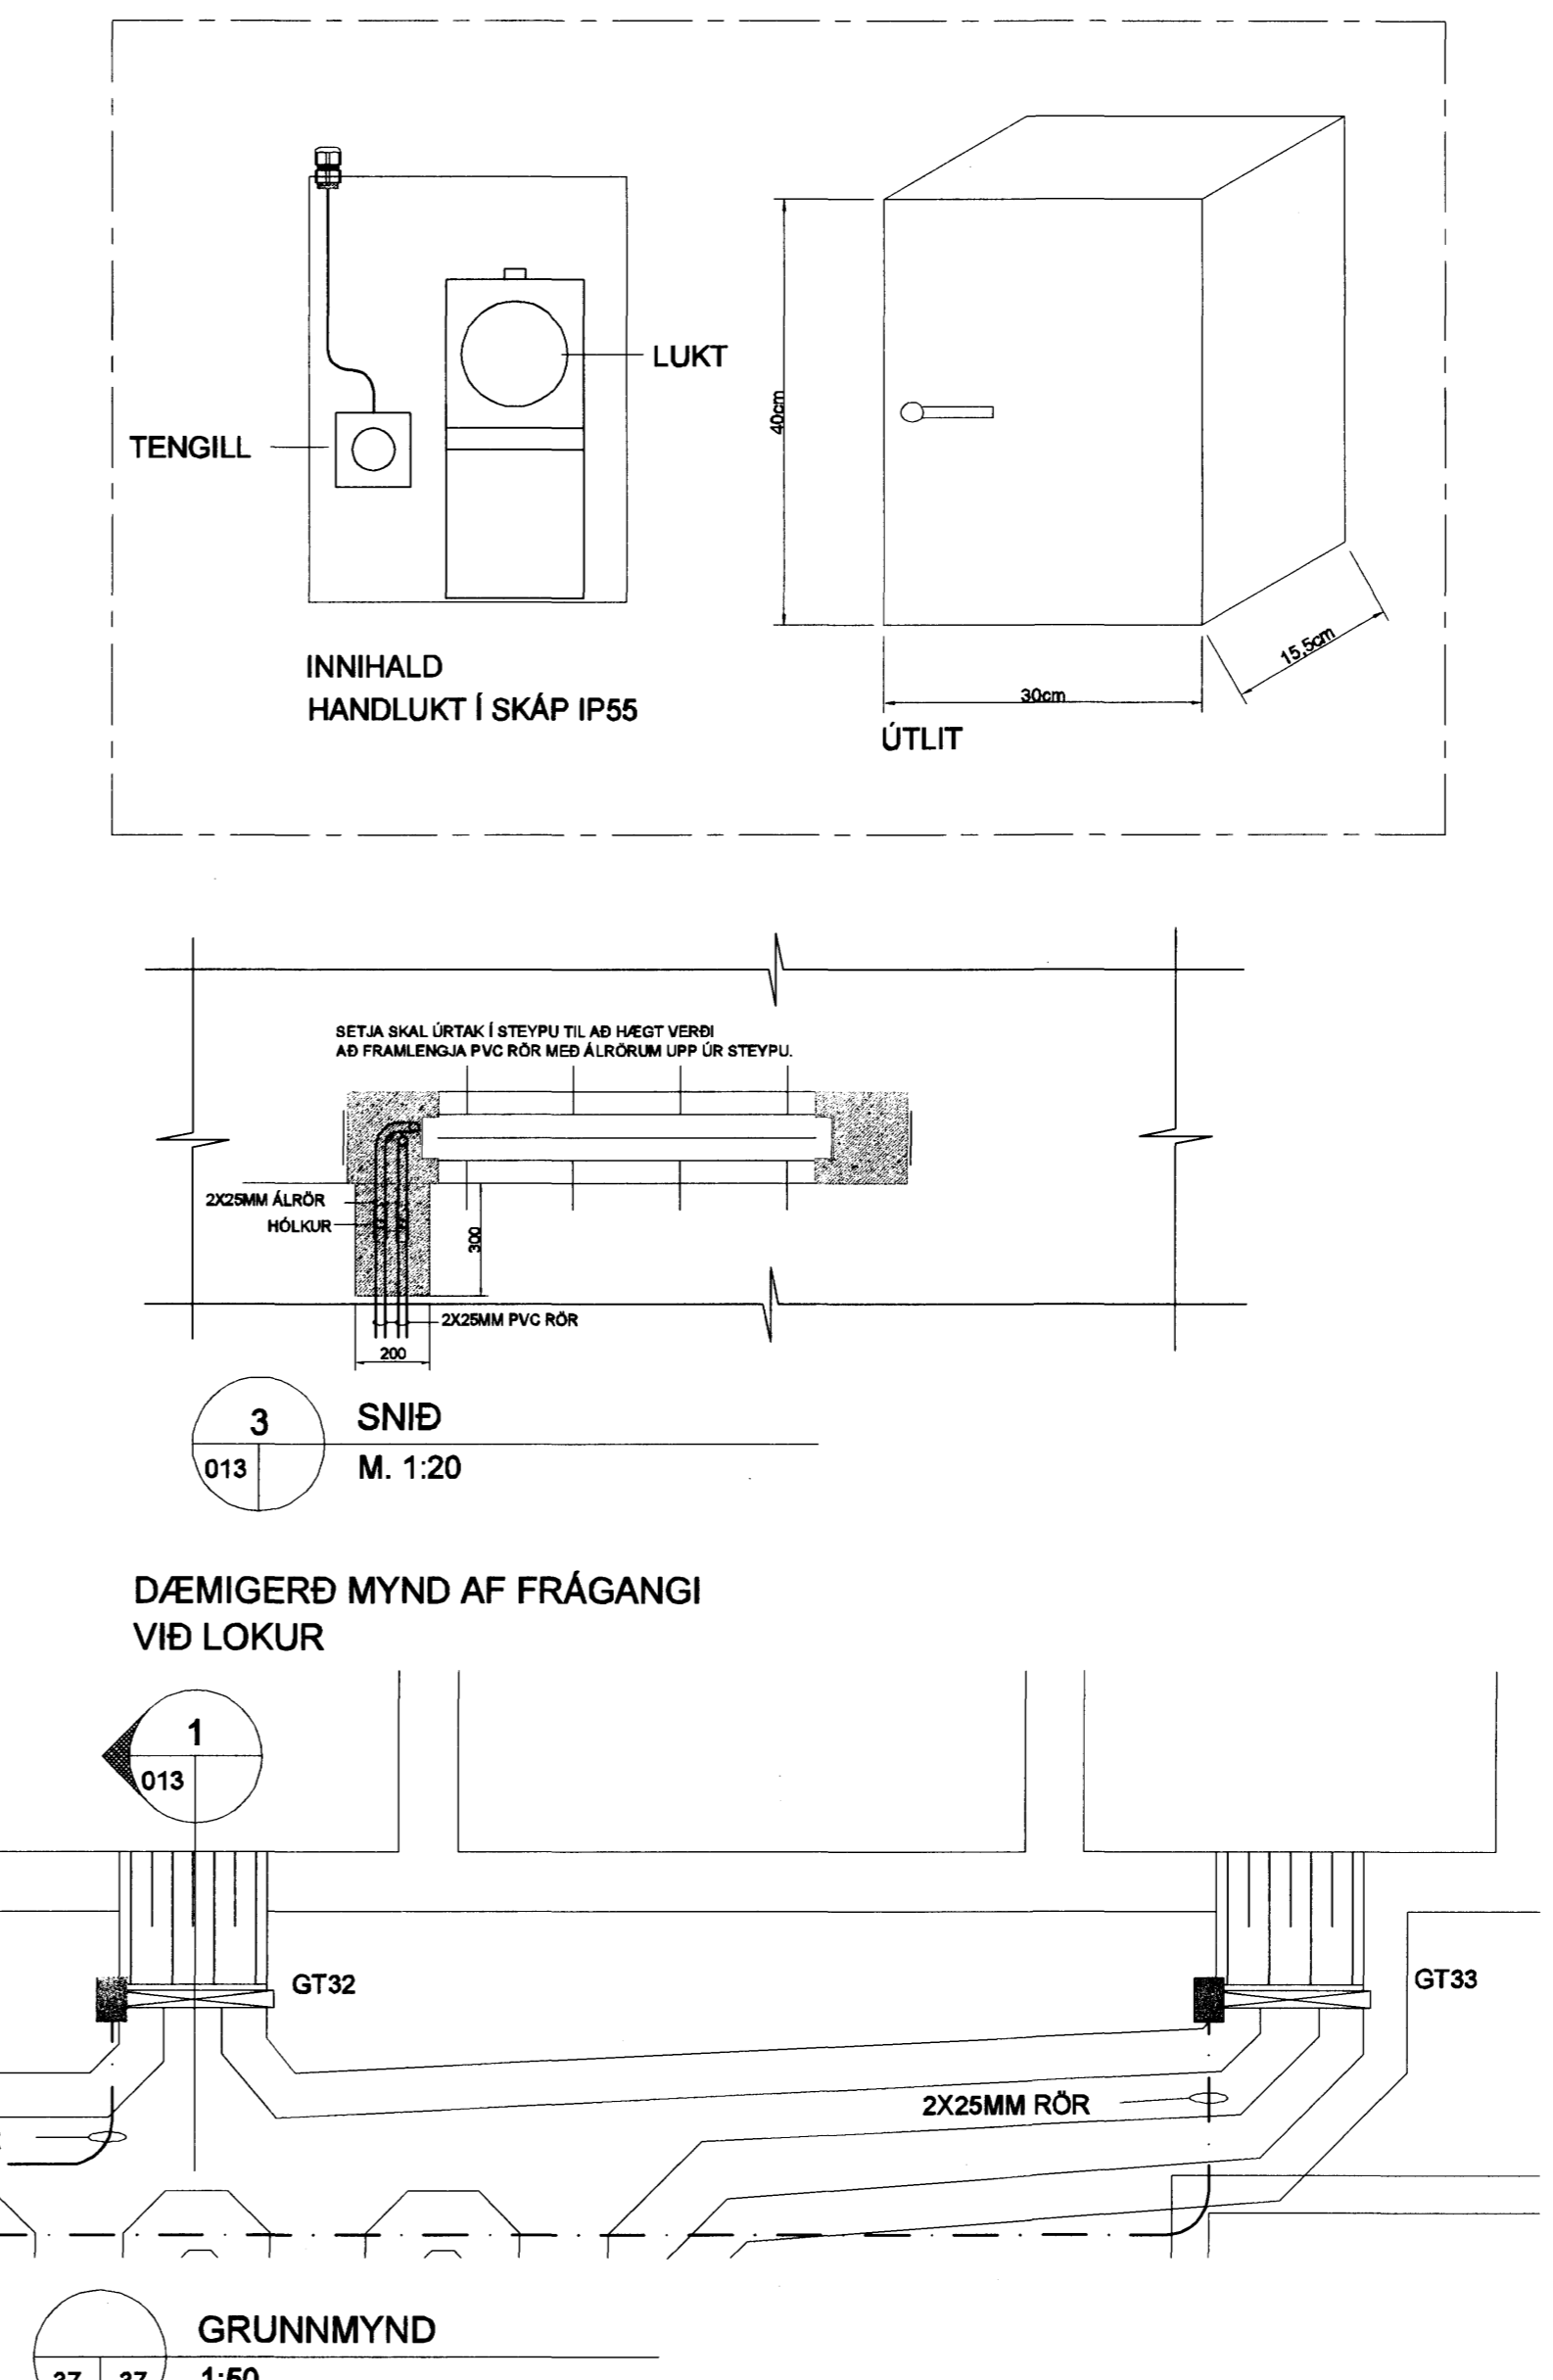
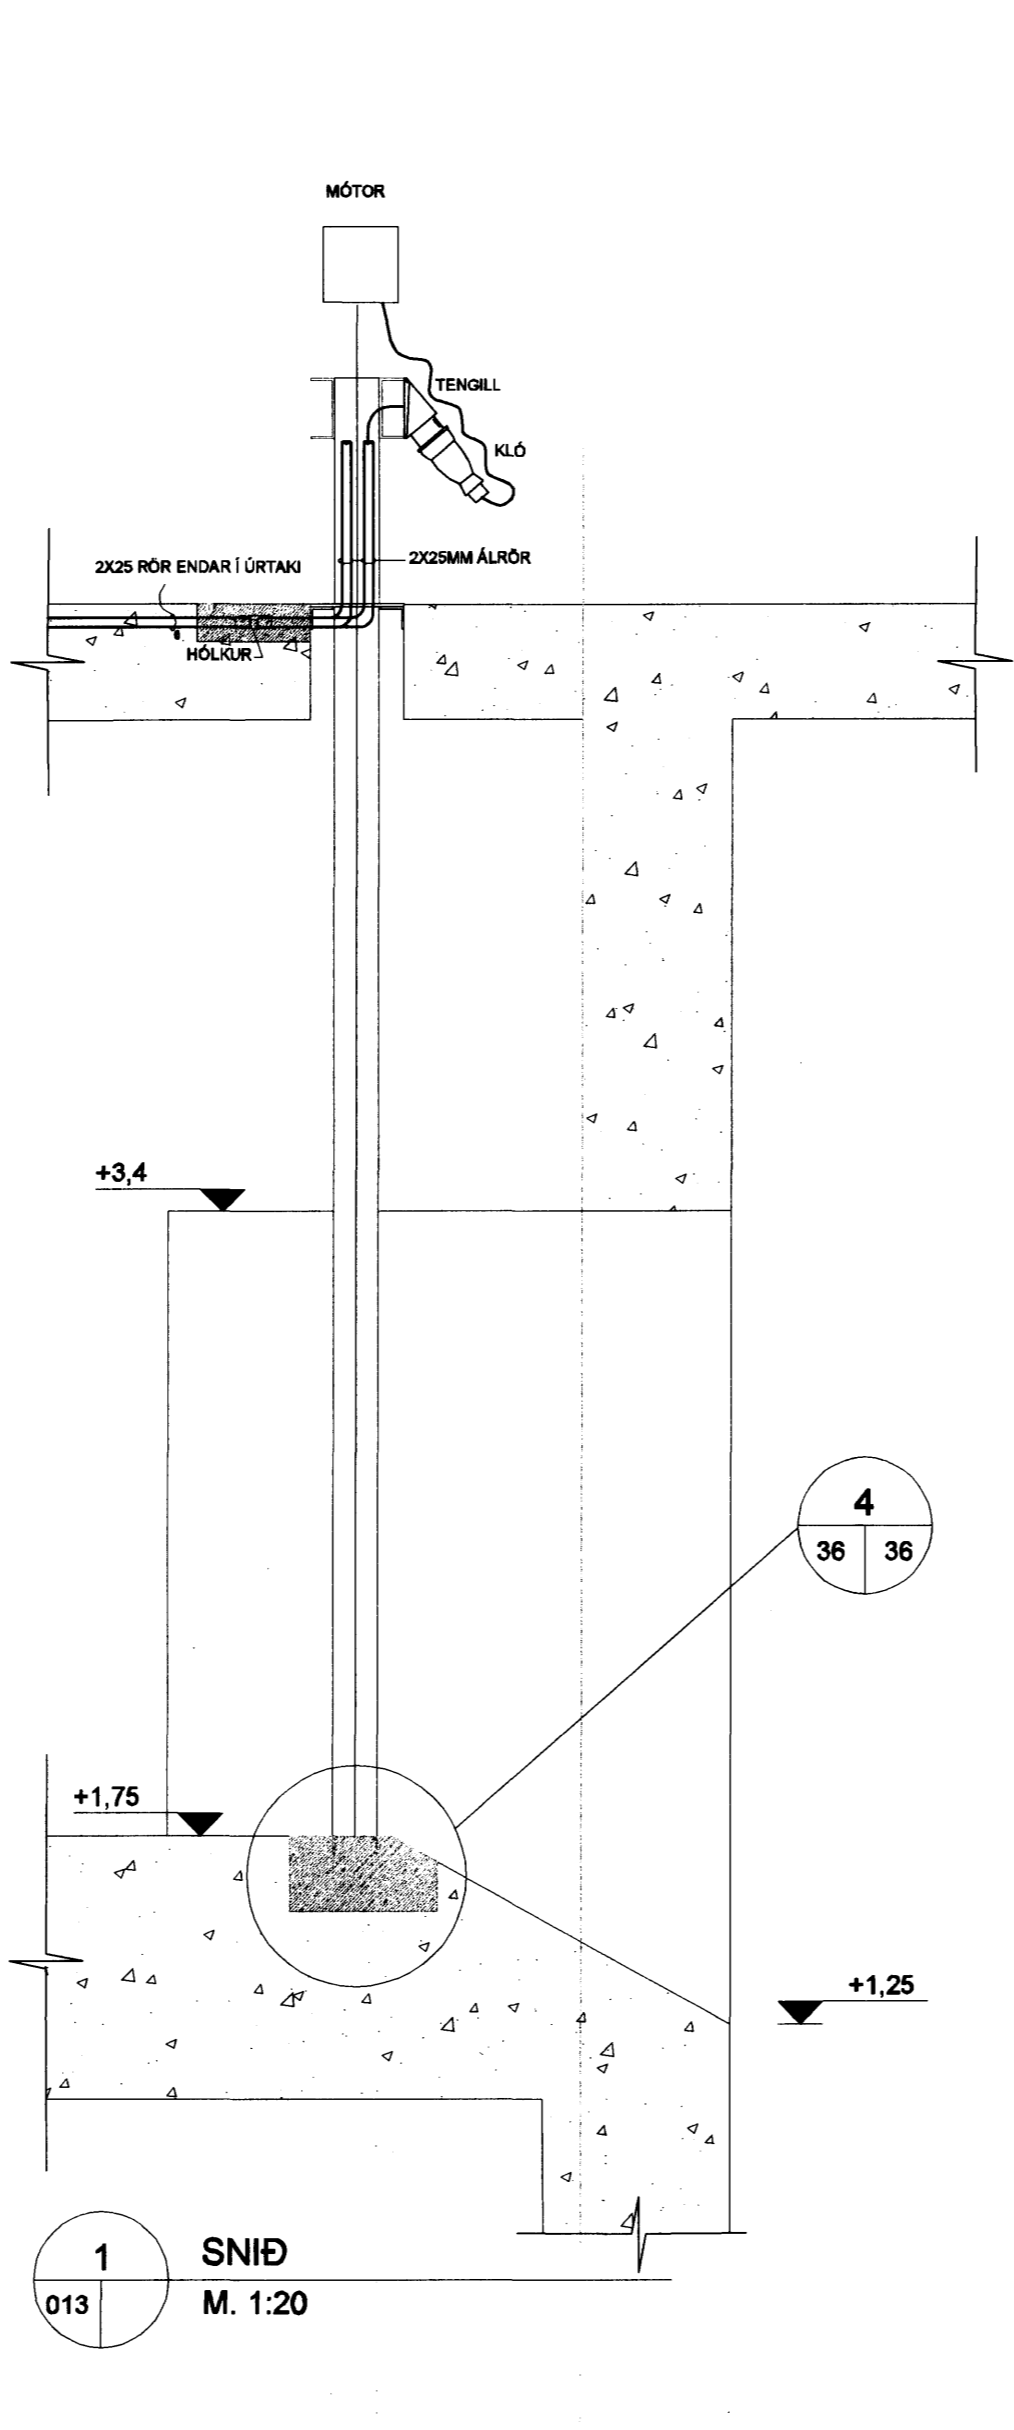


PRENTAD: 4. desember 2009 13:26:11

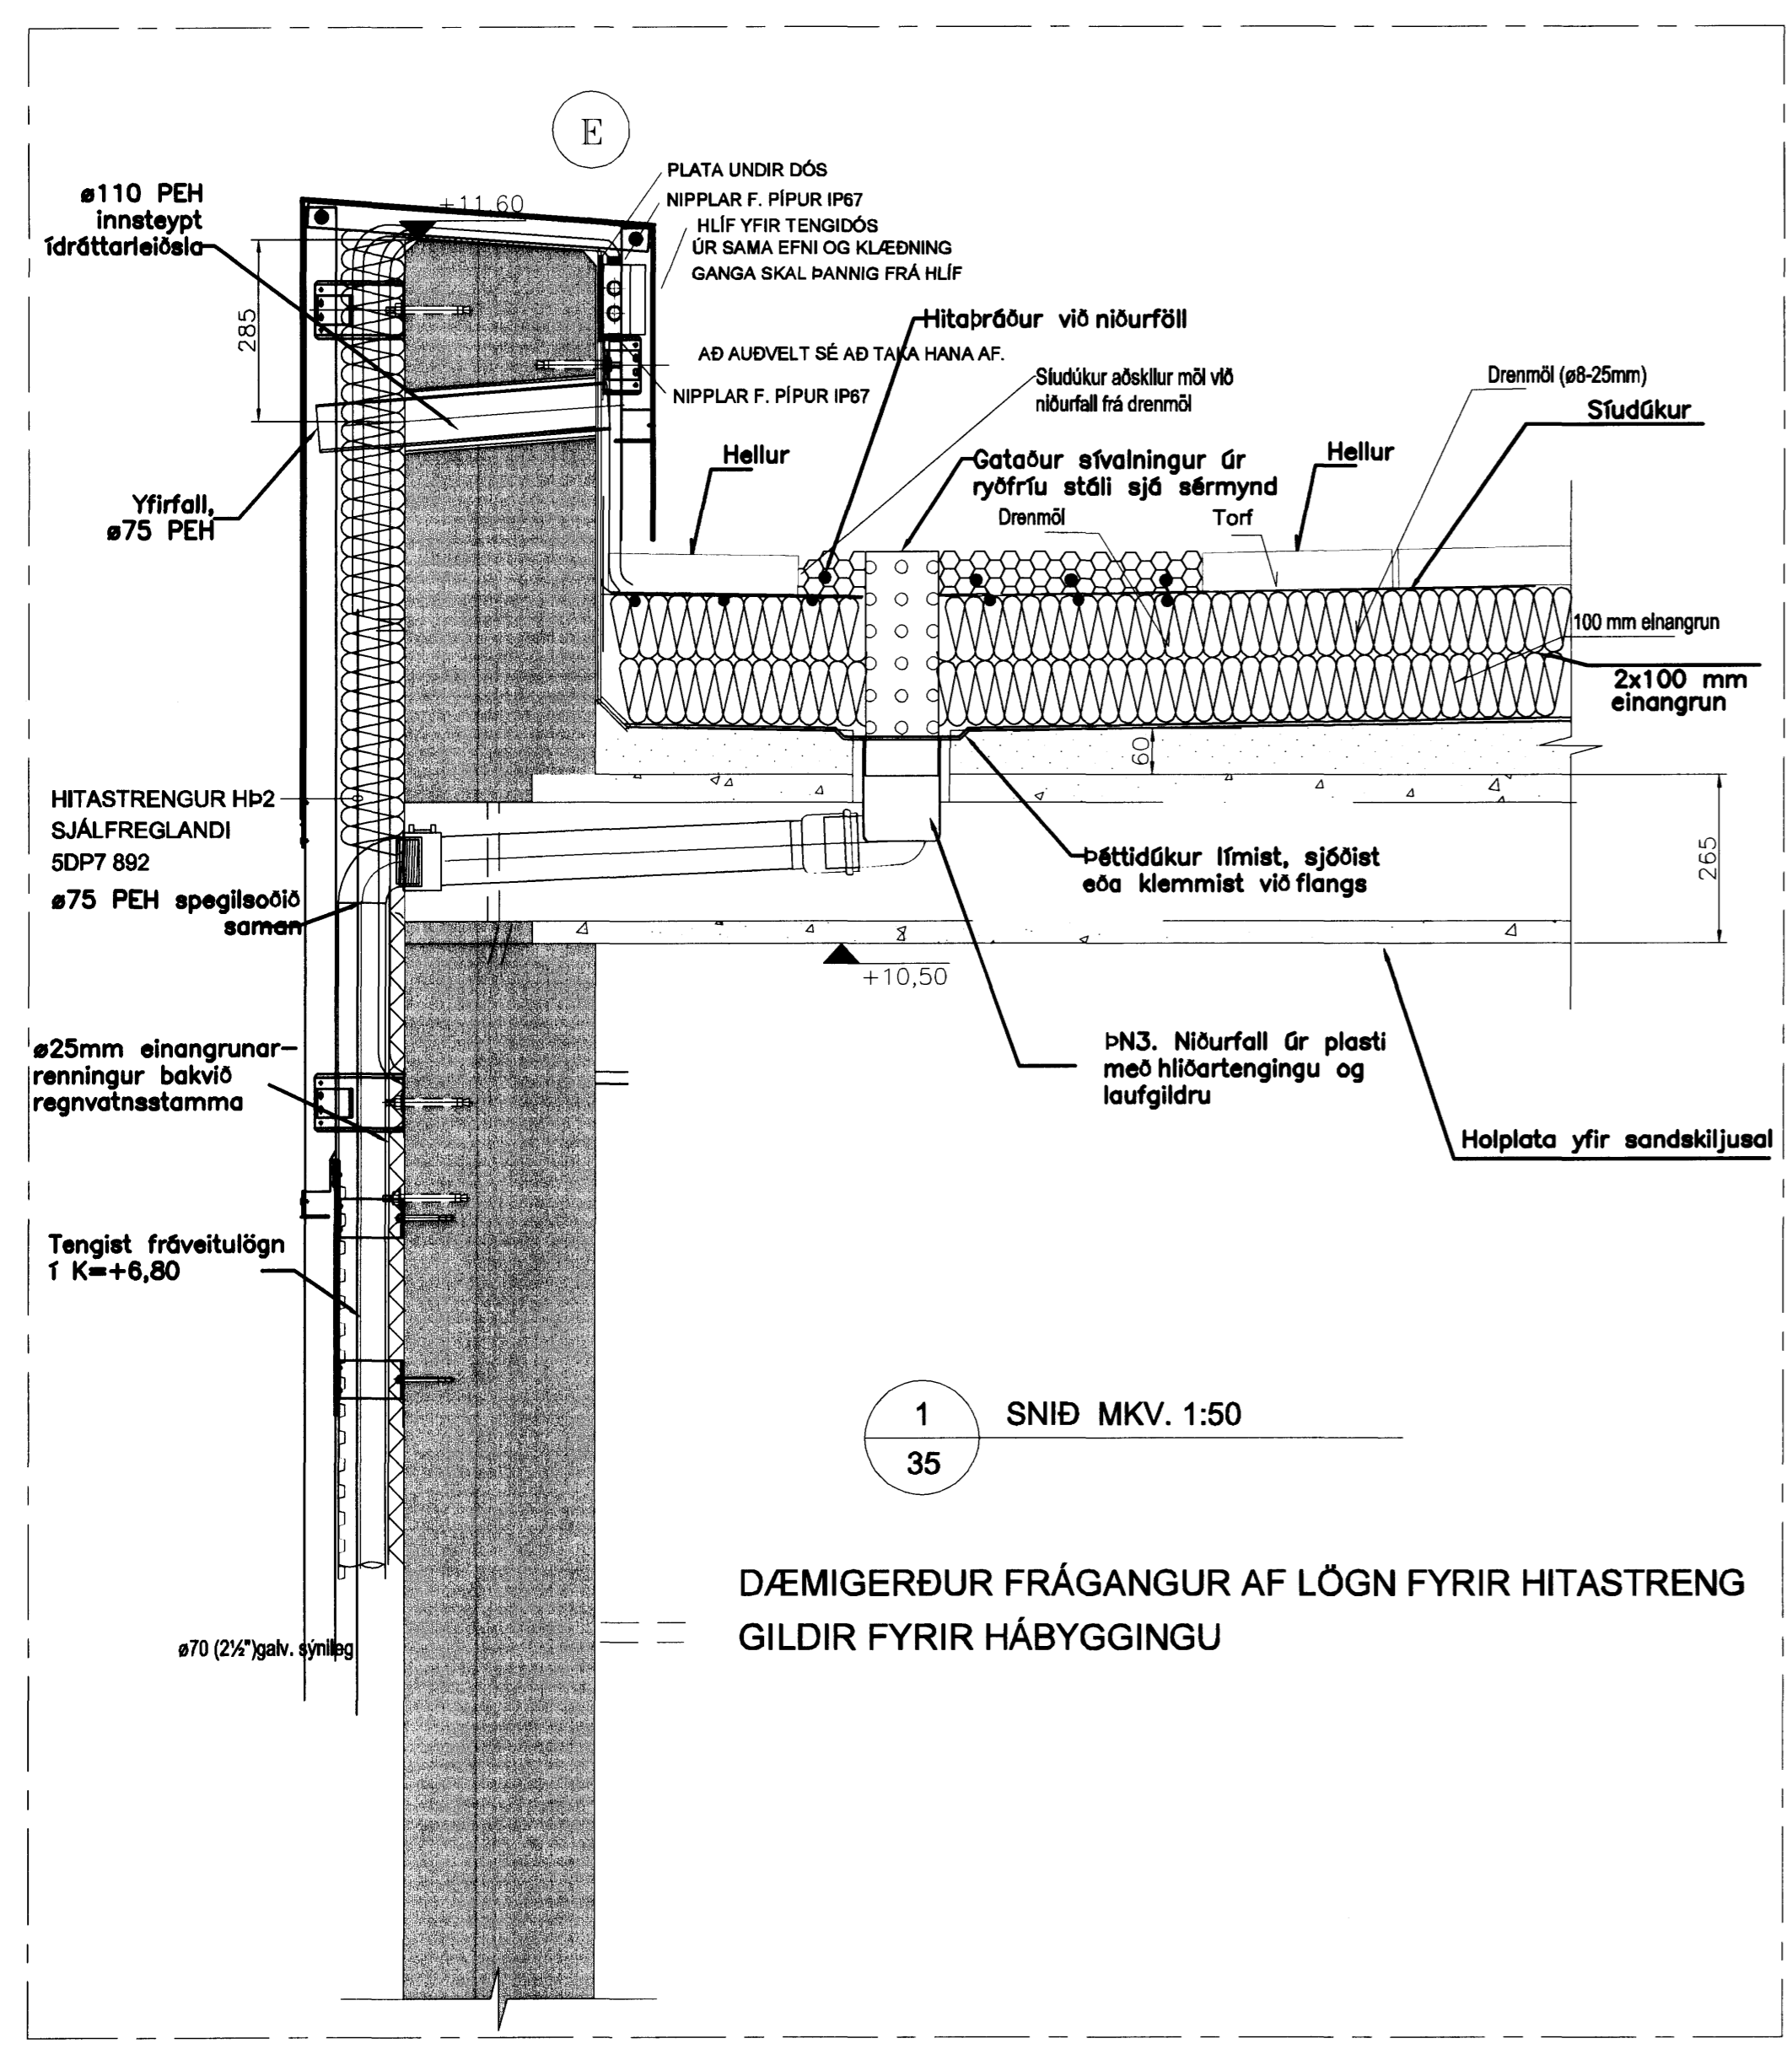

ÚTGÁFUFRILL					
NR.	DAGS.	SKÝRINGAR	HA.	YF.	SR.
A	30.10.09	REYNDARTEIKNING	KS	HaM	
DAGS. UNDIRSKRIFTAR: HAFN OG KT. SAMRÆMINGARHÖNNUNAR:					
GRENSÁSVEGI 1, 108 REYKJAVÍK. Sími: 422 3000, Fax: 422 3001 VEFANG: www.mannvit.is NETFANG: mannvit@mannvit.is					
HEITI VERKS:					
DÆLU- OG HREINSISTÖÐ HRAUNAVÍK, HAFNAFIRÐI					
HEITI TEIKNINGAR:					
LÁGSPENNULAGNIR SÉRMYNDIR OG FYRIRKOMULAG					
DAGS:	28.04.06	HANNAÐ/TEIKNAD:	KS	GRB	TEIKNINGANÚMÉR:
MKV:	1:20, 1:50	YFRIFAR:			R-013
SAMÞYKKT/KT:					VERKUNUMÉR: 2.041.130
[Signature] [Signature] Utgáfa: A					

TÓLVISUAL: F:\MOT3\Teikningar\Reinirumum\SA\Reinirumum-R-013.dwg
© ÖLL MANNVIT OG AFRITTUN TEIKNINGAR. AÐ ILUTA, EYNA, HÉLDU, Eða HAFN VÆRISÖGU LEYMAKENDRA.