


30/3 '10  
*[Signature]*

TEIKNING I SAMRÆMI VI  
 ARKITEKTATEIKNINGAR  
 dags: 2.2.10  
 undirskrift: *[Signature]*  
 kt: 240448-2400

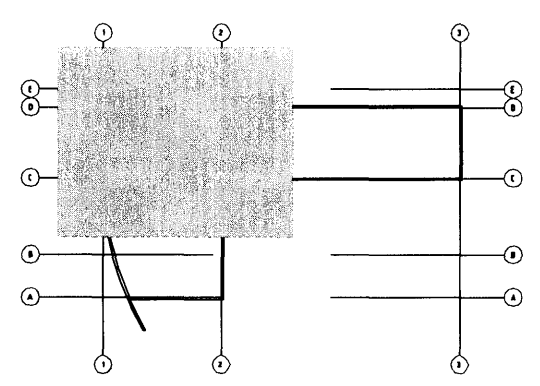

NR.	DAGS:	SKYRINGAR:	HA:	YF:	SP:
A	30.10.09	REYNDARTEIKNING	KS	HaM	

DAGS. UNDIRSKRIFTAR: NAFN OG KT. SAMRÆMINGARHÖNNUDAR:



GRENSÁSVÆGI 1, 108 REYKJAVÍK, Sími: 422 3000, Fax: 422 3001  
 VEFFANG: www.mannvit.is NETFANG: mannvit@mennvit.is

HEITI VERKS:  
**DÆLU- OG HREINSISTÖÐ**  
 HRAUNAVÍK,  
 HAFNAFIRÐI

HEITI TEIKNINGAR:  
 SPENNUJÖFNUN  
 SÍUR, DÆLUR OG GÁMASVÆÐI  
 GRUNNMYND JARÐHÆÐ HLUTI 2

DAGS:	28.04.06	HANNAÐ / TEIKNAR:	HaM	TEIKNINGANÚMÉR:	
MKV.:	1:50	YFIRFARIR:			
SAMBÝRKT / KT:					

*[Signature]*  
 R-112  
 VERKNUMÉR:  
 2.041.130  
 ÚTGÁFA: A