


30/3 '10
[Signature]

TEIKNING I SAMRÆMI VID
 ARKITEKTATEIKNINGAR
 dags: 2.2.10
 undirskrift: *[Signature]*
 kt: 240448-2469

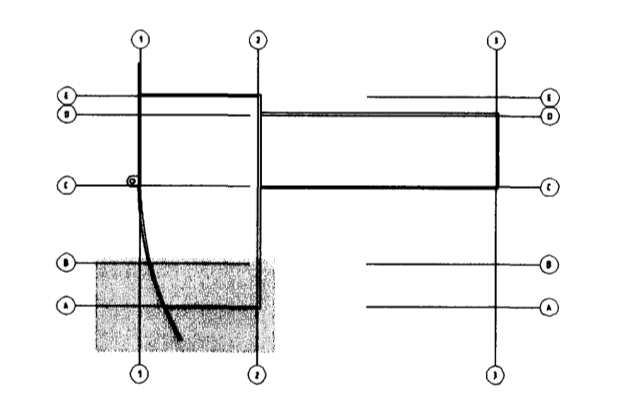

NR.	DAGS.	SKYRINGAR:	HA:	YF:	SP:
A	11.04.07	STÁLPIL JARÐTEINGT	PJ		
B	30.10.09	REYNDARTEIKNING	HaM	KS	

DAGS. UNDIRSKRIFTAR: NAFN OG KT. SAMRÆMINGARHÖNNUDAR:



GRENSÁSVEGI 1, 108 REYKJAVÍK, Sími: 422 3000, FAX: 422 3001
 VEFANG: www.mannvit.is NETFANG: mannvit@mannvit.is

HEITI VERKS:
DÆLU- OG HREINSISTÖÐ
 HRAUNAVÍK,
 HAFNAFIRÐI

HEITI TEIKNINGAR:
 SPENNUJÓFNUN
 TÖFLURÝMI, STARFSMANNAAÐSTÁÐA
 GRUNNMÝND JARÐ- OG 1.HÆÐ HLUTI 3

DAGS:	28.04.06	HANNAÐ / TEIKNAD:	HaM	TEIKNINGANUMER:	
MKV:	1:50	YFIRFARID:	A1	VERKNUMER:	R-113
SAMÞYKKT / KT:				UTGÁFA:	2.041.130 B

[Signature]
 2.041.130
 UTGÁFA B