


30/3 '10
[Handwritten signature]

TEIKNING I SAMRÆMI VÍÐ
 ARKITEKTATEIKNINGAR
 dags: 2.2.10
 undirskrift: *[Handwritten signature]*
 kt: 240448-2469

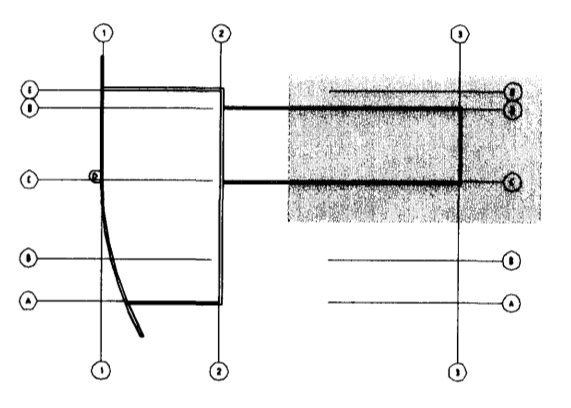

NR:	DAGS:	SKÝRINGAR:	HA:	YF:	SP:
A	28.02.08	GREINAMERKINGAR	KS	HaM	
B	29.09.09	TENGIK. SKÓLPTÆMING	KS	HaM	
C	30.10.09	REYNDARTEIKNING	HaM	KS	

DAGS. UNDIRSKRIFTAR: NAFN OG KT. SAMRÆMINGARHÖNNUNÐAR:



GRENSÁSVEGI 1, 108 REYKJAVÍK, Sími: 422 3000, FAX: 422 3001
 VEFÞANG: www.mannvit.is NETÞANG: mannvit@mennvit.is

HEITI VERKS:
DÆLU- OG HREINSISTÖÐ
 HRAUNAVÍK,
 HAFNAFIRÐI

HEITI TEIKNINGAR:
 LÁGSPENNULAGNIR
 SANDSKILJUHLUTI
 GRUNNMYND JARÐHÆÐ HLUTI 1

DAGS:	28.04.06	HANNAÐ/TEIKNAD:	HaM	TEIKNINGANÚMÉR:	R-211
MKV:	1:50	YFIRFARID:	A1	VERKUNUMÉR:	2.041.130
SAMÞYKKT / KT:				ÚTGÁFA:	C