


30/3 '10

TEIKNING I SAMHANG
 ARKITEKTATEIKNINGAR
 dags: 2.2.10
 undirskrift:
 kt: 240448-2469

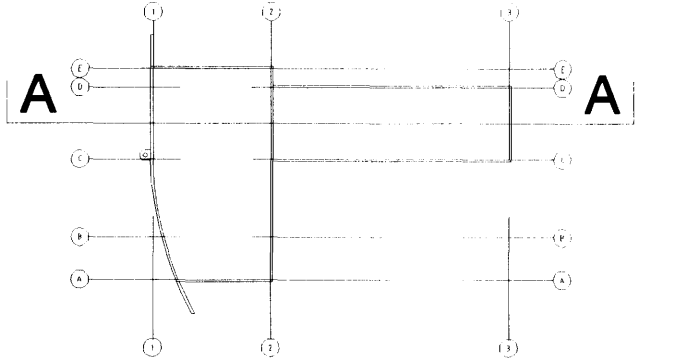

NR.	DAGS.	SKYRINGAR:	ÚTGÁFUFERILL	HA	YF.	SR.
A	30.10.09	REYNDARTEIKNING		KS	HaM	

DAGS. UNDIRSKRIFTAR: NAFN OG KT. SAMRÆMINGARHÖNNUDAR:



GRENSÁSVEGI 1, 108 REYKJAVÍK. Sími: 422 3000, FAX: 422 3001
 VEFFANG: www.mannvit.is NETFANG: mannvit@mannvit.is

HEITI VERKS:
DÆLU- OG HREINSISTÖÐ
 HRAUNAVÍK,
 HAFNAFIRÐI

HEITI TEIKNINGAR:
 BRUNAVIÐVÖRUNARKERFI
 KERFISMYND

DAGS: 28.04.06	HANNAÐ/TEIKNAD: KS	TEIKNINGANÚMÉR: R-3S01
MKV: 1:50	YFIRFARID: A1	VERKUNÚMÉR: 2.041.130
SAMBYGGT / KT:		ÚTGÁFA: A