


30/3 '10
[Signature]

TEIKNING I SAMRÆMI VIT
ARKITEKTATEIKNINGAR


dags: 2. 10

undirskrift: *[Signature]*

kt: 240448-2469

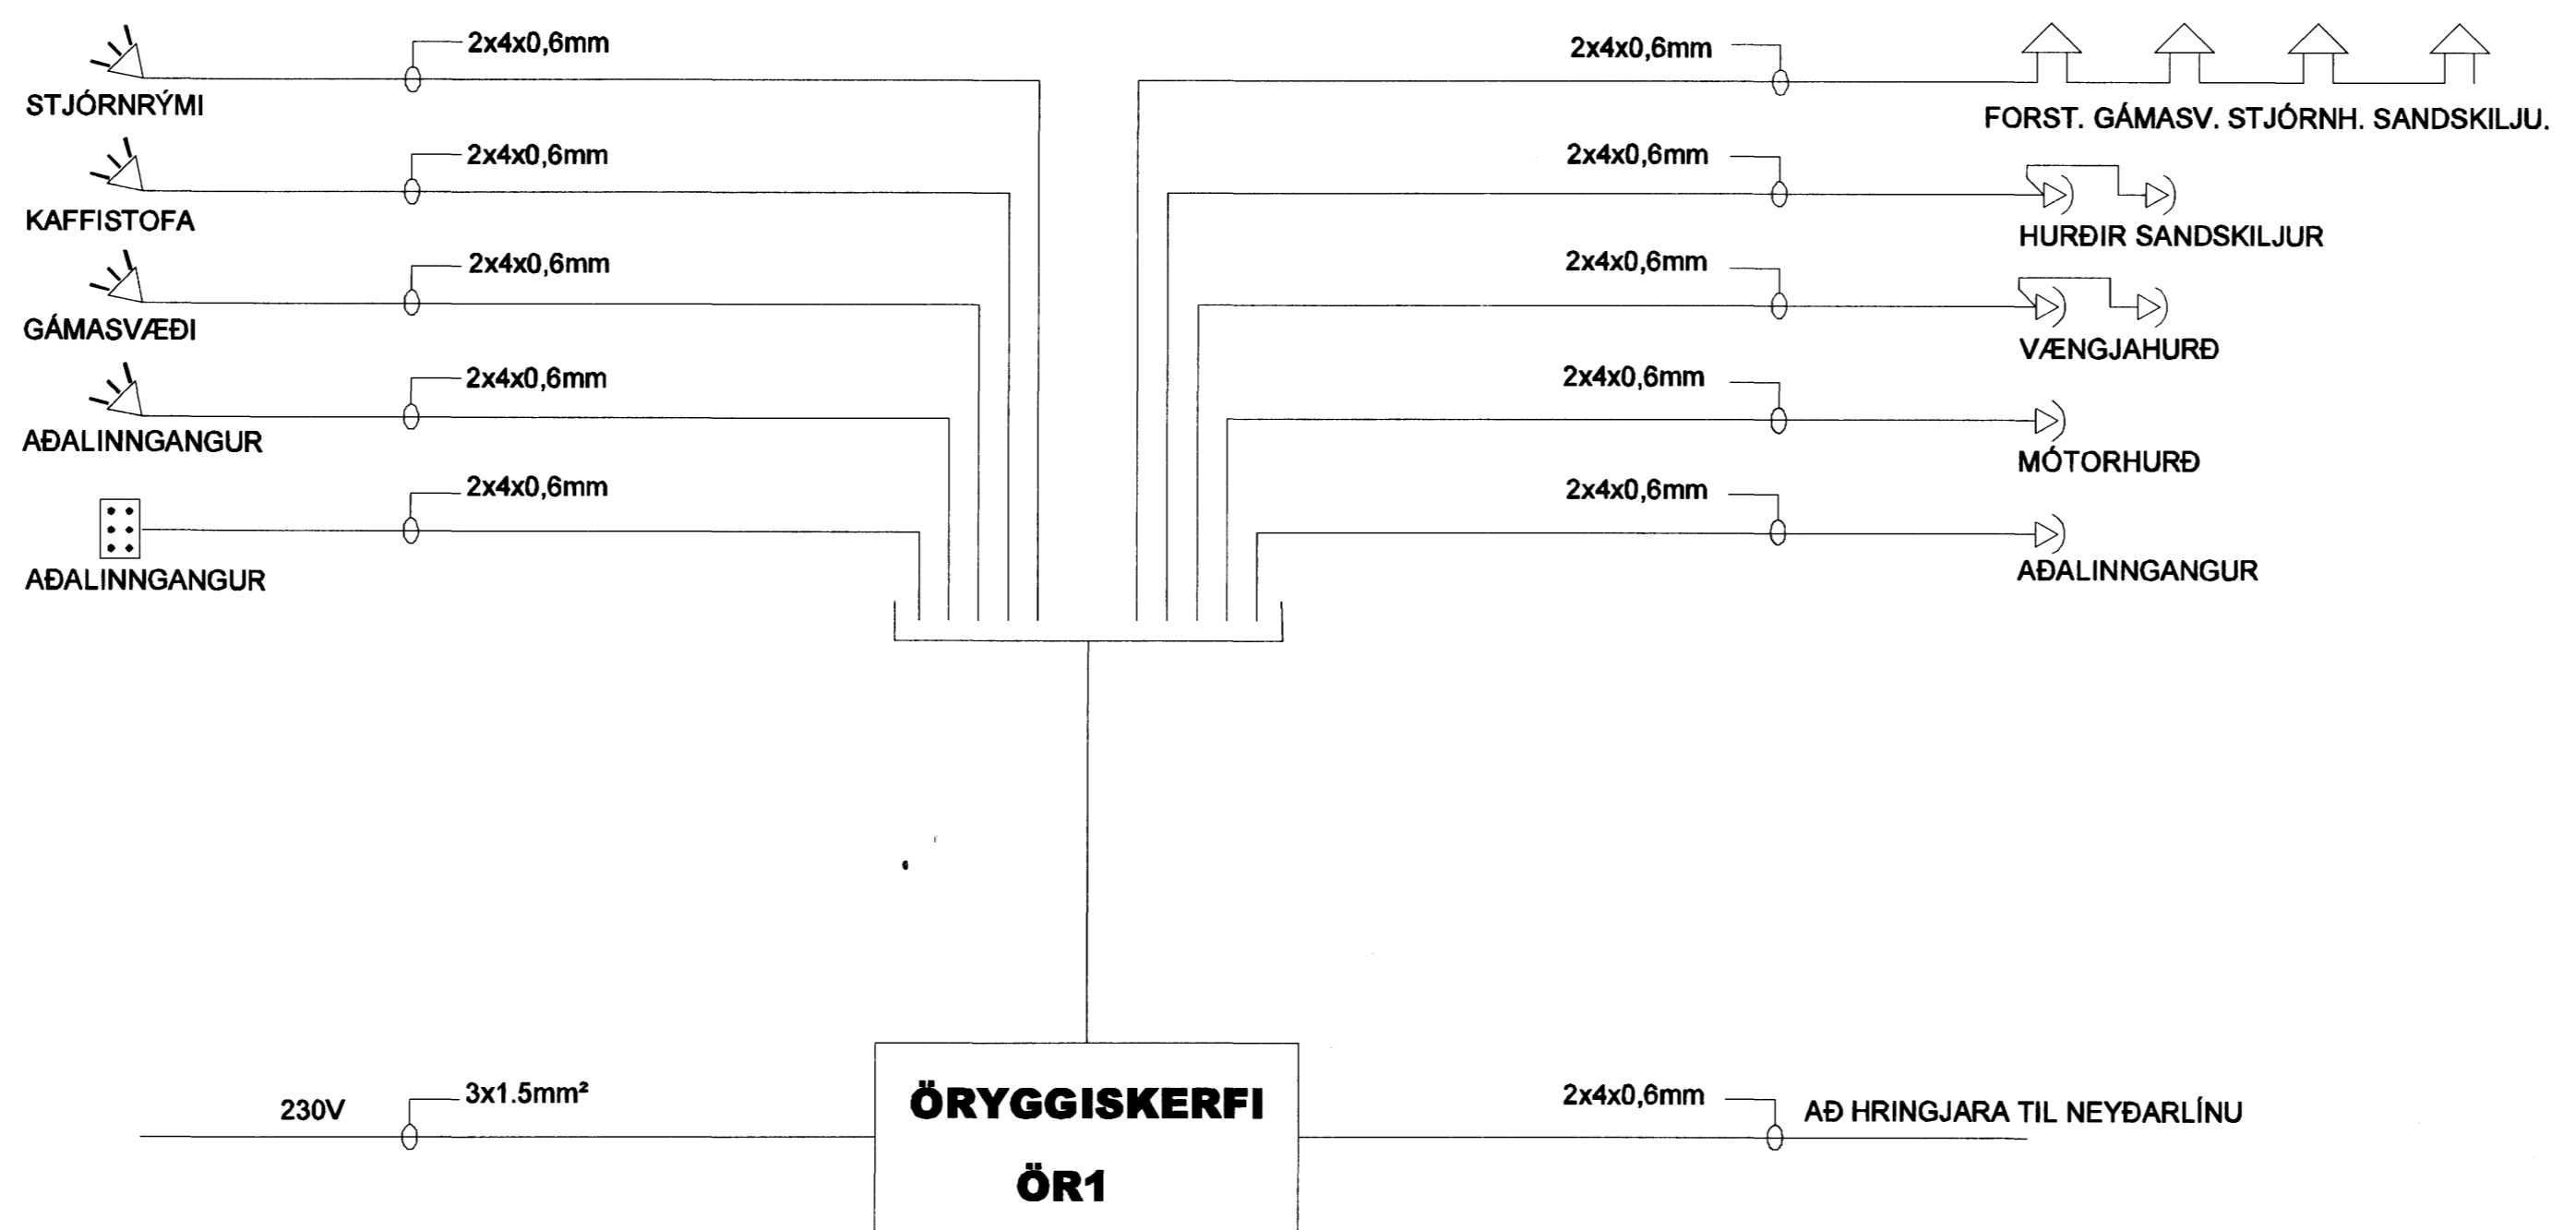

KERFISMYND INNBROTAVIÐVÖRUNARKERFIS

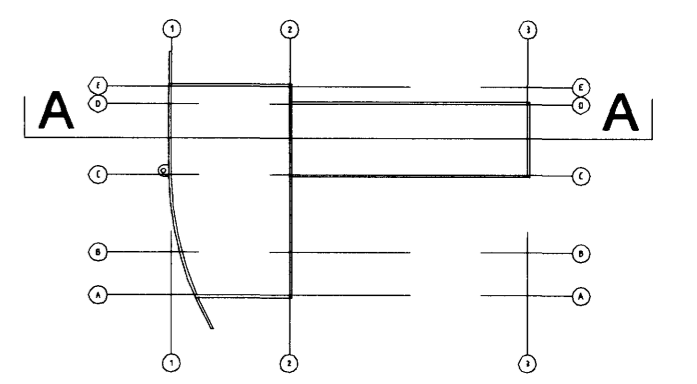

ÚTGÁFUERILL					
NR.	DAGS.	SKÝRINGAR:	HA:	YF:	SÞ:
A	30.10.09	REYNDARTEIKNING	KS	HAM	

DAGS. UNDIRSKRIFTAR: NAFN OG KT. SAMRÆMINGARHÖNNUDAR:



GRENSÁSVEGI 1, 108 REYKJAVÍK, Sími: 422 3000, FAX: 422 3001
VEFFANG: www.mannvit.is NETFANG: mannvit@mannvit.is

HEITI VERKS:
DÆLU- OG HREINSISTÖÐ
HRAUNAVÍK,
HAFNAFIRÐI

HEITI TEIKNINGAR:
ÖRYGGISKERFI
KERFISMYND

DAGS.: 28.04.06	HANNAÐ / TEIKNAD: KS	TEIKNINGANÚMÉR: R-3S02
MKV: 1:50	YFIRFARIB: A1	
SAMÞYKKT / KT: <i>[Signature]</i>		VERKUNAR: 2.041.130
		ÚTGÁFA: A