


30/3 '10
[Signature]

TEIKNING I SAMRÆMI VIÐ
 ARKITEKTATEIKNINGAR
 dags: 2.2.10
 undirskrift: *[Signature]*
 kt: 240448-2469

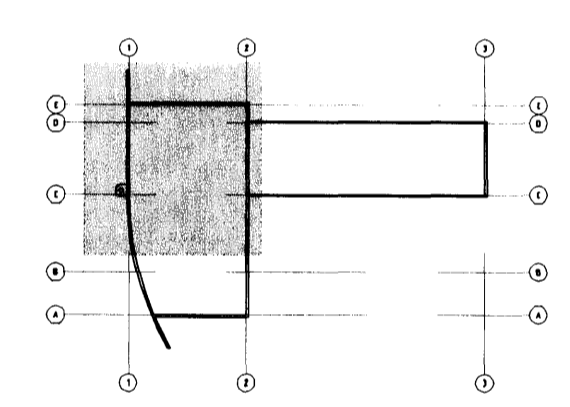

NR.	DAGS:	SKÝRINGAR:	HA:	YF:	SP:
A	20.01.09	ALM. BREYTING	KS	HaM	
B	30.10.09	REYNDARTEIKNING	KS	HaM	

DAGS. UNDIRSKRIFTAR: NAFN OG KT. SAMRÆMINGARHÖNNUDAR:



GRENASÁSVEGI 1, 108 REYKJAVÍK, Sími: 422 3000, Fax: 422 3001
 VEFANG: www.mannvit.is NETFANG: mannvit@mannvit.is

HEITI VERKS:
DÆLU- OG HREINSISTÖÐ
 HRAUNAVÍK,
 HAFNAFIRÐI

HEITI TEIKNINGAR:
 SMÁSPENNULAGNIR
 SIUR, DÆLUR OG GÁMASVÆÐI
 GRUNNMYND JARÐHÆÐ HLUTI 2

DAGS:	28.04.06	HANNAÐ / TEIKNAD:	KS	TEIKNINGANUMER:	312
MKV:	1:50	YFIRFARID:	A1	VERKNUMER:	2.041.130
SAMÞYKKT / KT:		<i>[Signature]</i>		ÚTGÁFA:	B