


Mótt: 3013 '10  
*[Signature]*

TEIKNING I SAMRÆMI VIT  
 ARKITEKTATEIKNINGAR  
 dags: 2.2.10  
 undirskrift: *[Signature]*  
 kt: 240448-2469

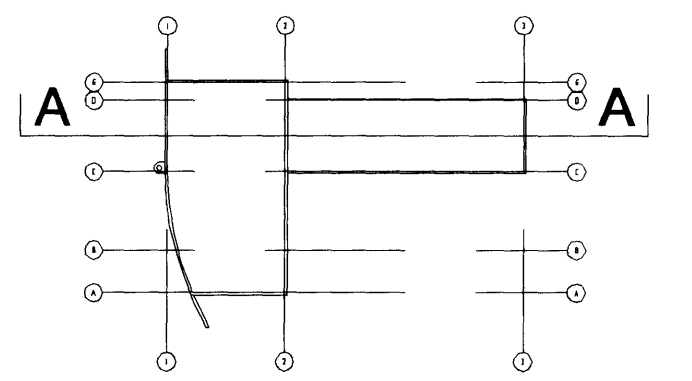

NR:	DAGS:	SKÝRINGAR:	ÚTGÁFUFERILL	HA:	YF:	SR:
A	30.10.09	REYNDARTEIKNING		KS	H&M	

DAGS. UNDIRSKRIFTAR: NAFN OG KT. SAMRÆMINGARHÖNNUBAR:



GRENASÁVEGI 1, 108 REYKJAVÍK, Sími: 422 3000, FAX: 422 3001  
 VEFANG: www.mannvit.is NETFANG: mannvit@mannvit.is

HIETI VERKS:  
**DÆLU- OG HREINSISTÖÐ**  
 HRAUNAVÍK,  
 HAFNAFIRÐI

HIETI TEIKNINGAR:  
 TÆKJASTAÐSETNING  
 SÉRTEIKNINGAR  
 GRUNNMYND KJALLARI HLUTI 1

DAGS:	28.04.06	HANNAÐ / TEIKNAD:	KS	TEIKNINGANÚMÉR:	R-4S01
MKV:	1:50	YFIRFARND:	A1		
SAMÞYKKT / KT:		<i>[Signature]</i>			VERKNUMÉR: 2.041.130 ÚTGÁFA: A