

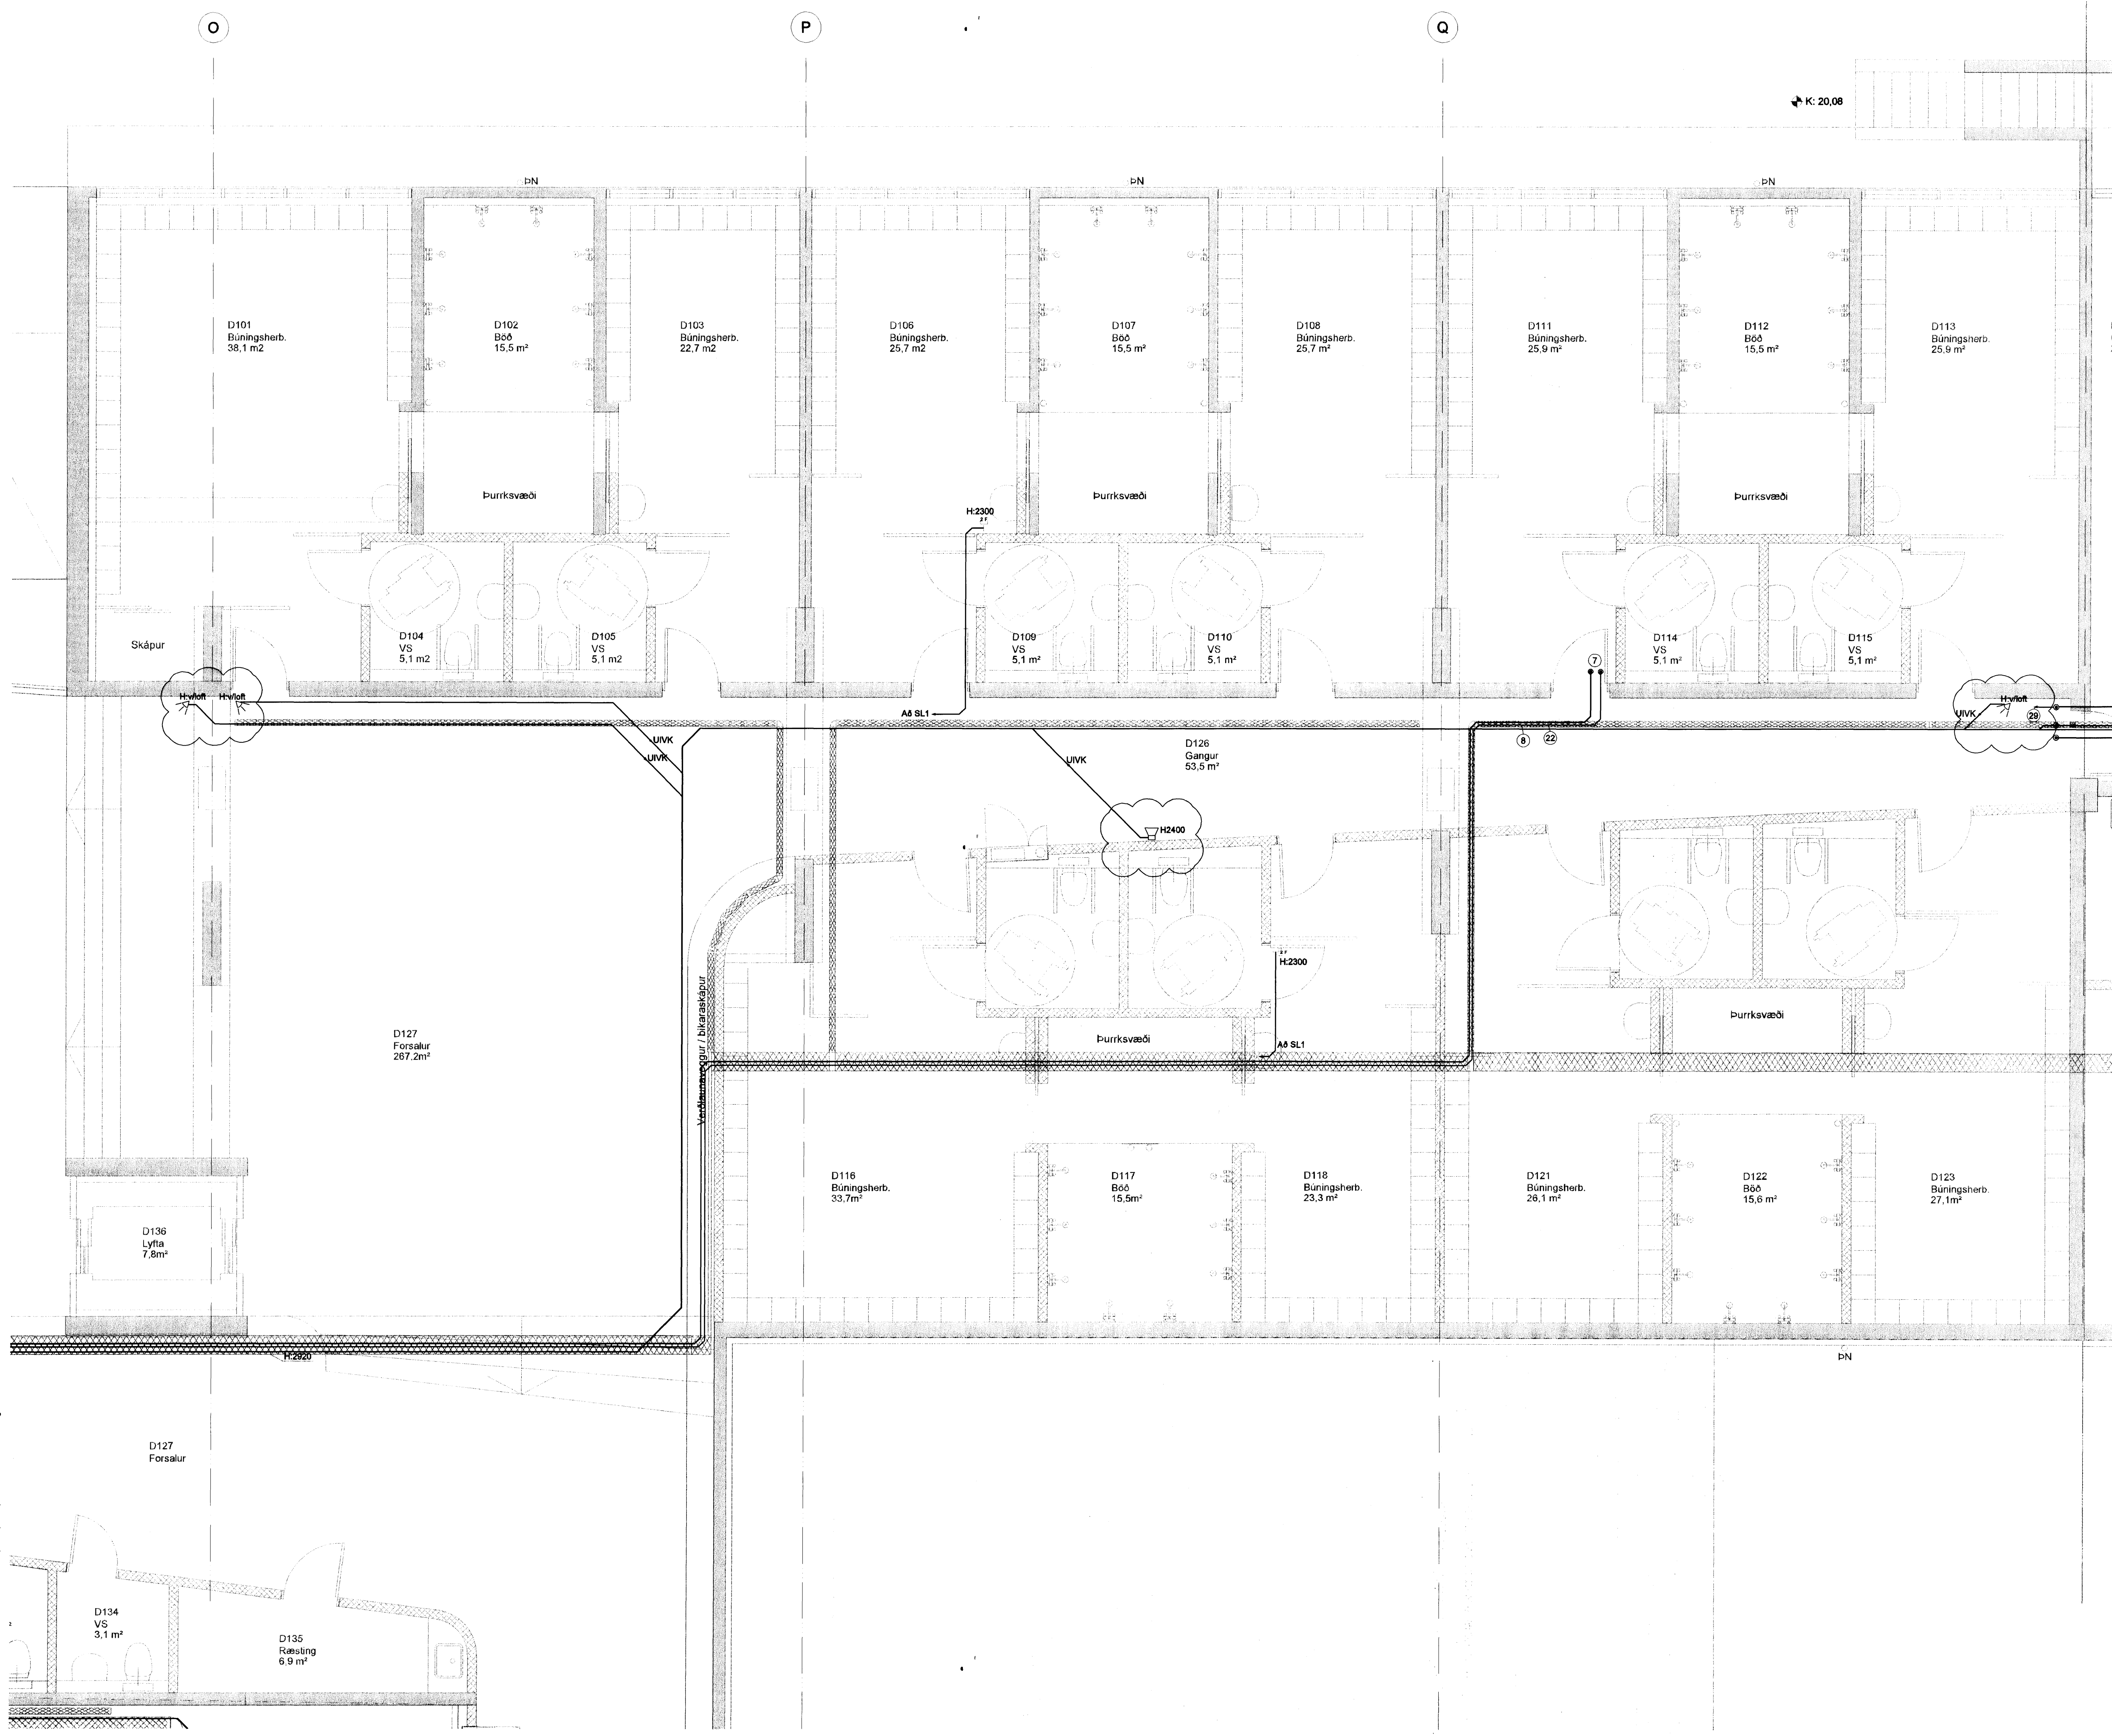


Mál: 18/3 '10  
H

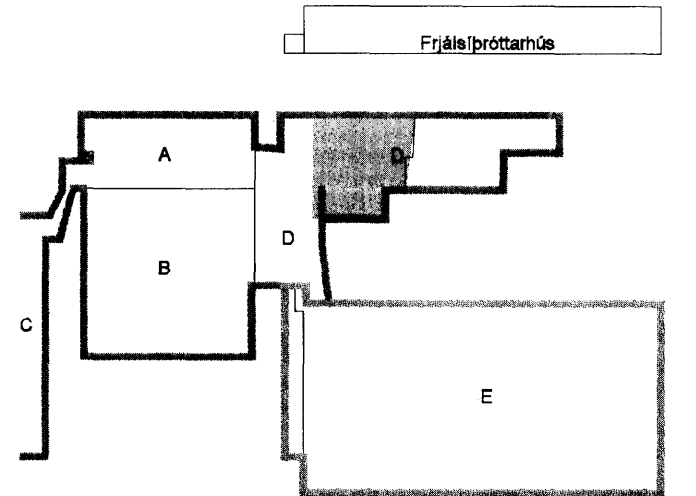

*[Signature]*  
Kl. 11045/220

KAPLAKRIKI

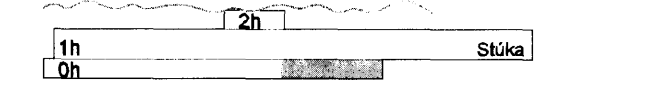

|            |          |                                      |                |
|------------|----------|--------------------------------------|----------------|
| E          | 14.01.10 | Innbrotavörðunarkerfi                | BSG/ÓG         |
| D          | 08.04.09 | Bætt við tenglum                     | SF/ÓG          |
| C          | 28.07.08 | Stigum breytt                        | SF/ÓG          |
| B          | 25.02.08 | Tæknilymi fjarlæt á teikningu A R304 | BSG/ÓG         |
| A          | 27.11.07 | Verkefning                           | RVK/HJ         |
| Útg. Dags. | Skýring  |                                      | Hannað/Virfanó |



VERKFRÆÐISTOFA

BÆJARHRAUN 20 · 220 HAFNARFJÖRÐUR · KENNIT. 710796-2899  
 vab@vab.is · Sími 585 8600 · Fax 585 8610 · www.vab.is

Áritun sérhönnuðar  
 Öm Guðmundsson Kt: 220961 2739 *[Signature]*

Verkefni  
**KAPLAKRIKI**  
**HAFNARFIRÐI**

Verkið  
 Rafkerfi  
 Smáspenna 0.hæð  
 Grunnmynd

|            |          |          |        |      |
|------------|----------|----------|--------|------|
| Hannað     | Teiknað  | Virfanó  | Kvart  | Síða |
| RVK/HJ     | RVK/HJ   | RVK      | 1:50   | / A1 |
| Dags.      | Verkefni | Teikning | Útgáfa |      |
| 30.04.2007 | 06811    | A R303   | E      |      |

V:\2008\06811\06811-Kaplakriki-FH\hanna@vab.is\03\Grunnmynd\06811-R304-hæð-A.dwg