

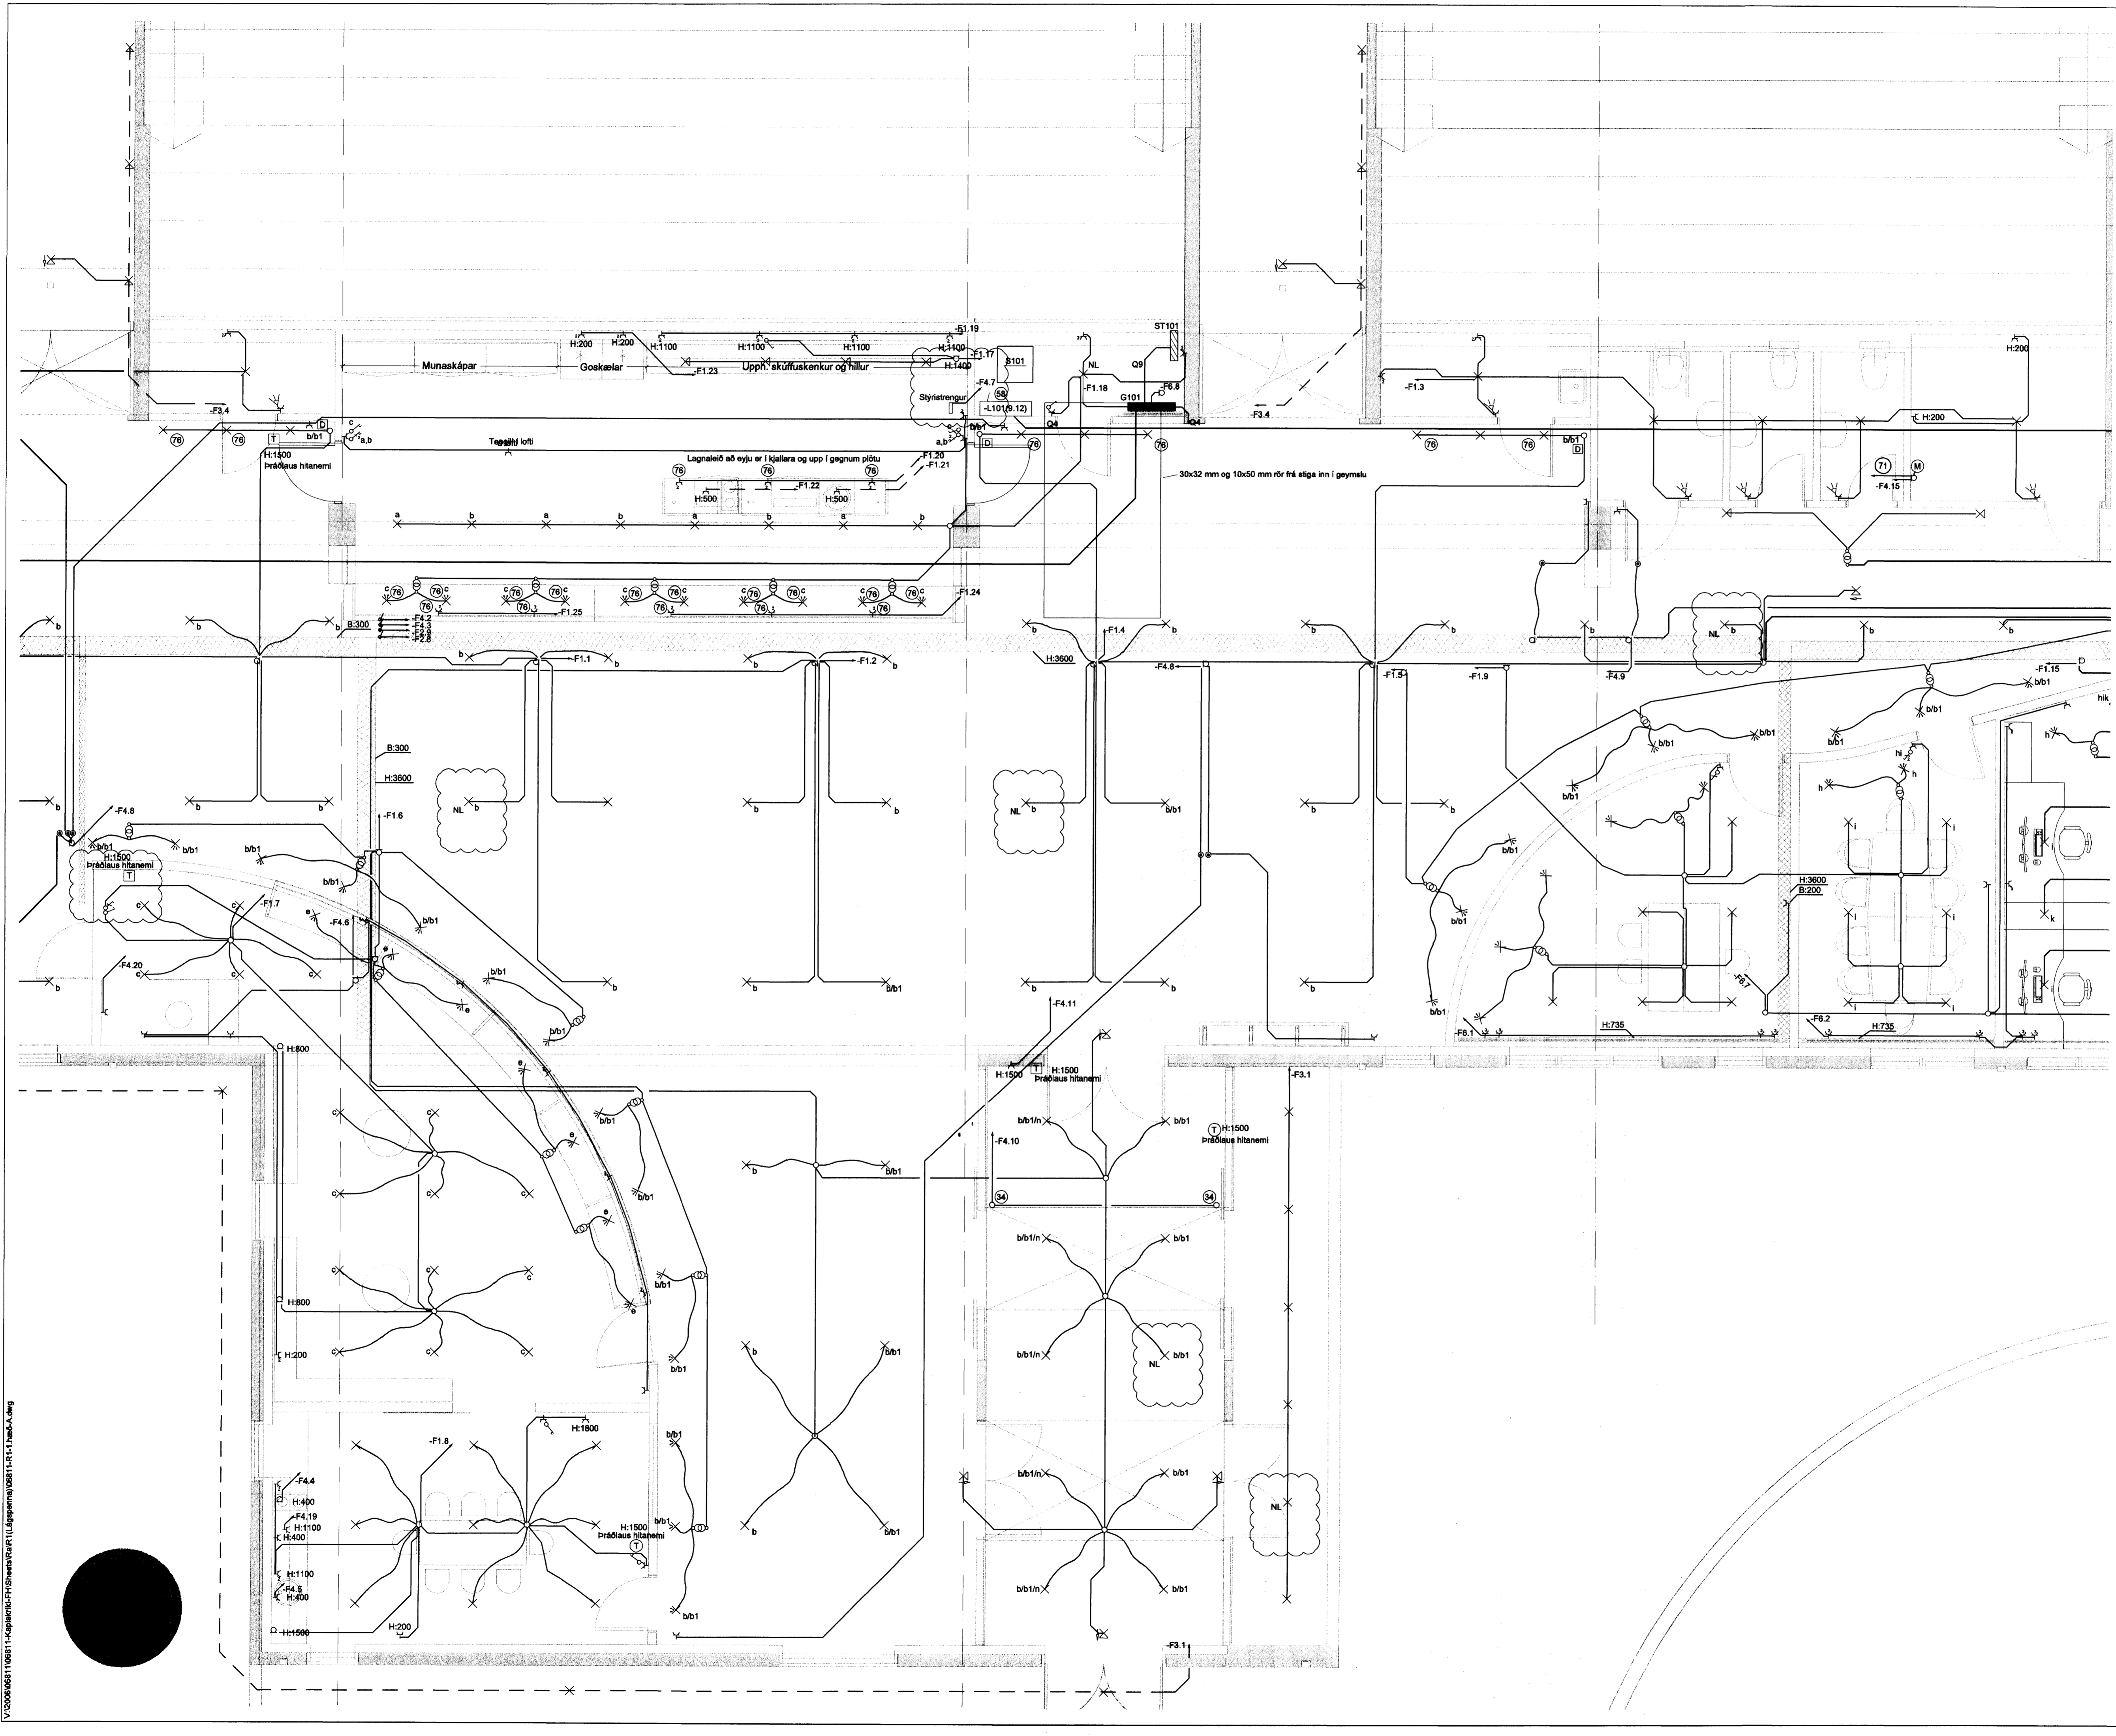
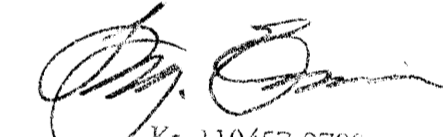


2811 2010 H

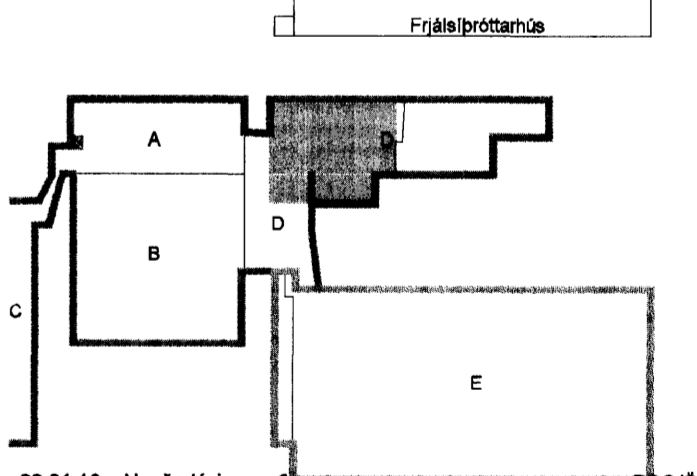

  
Kt. 110457-2789

**KAPLAKRIKI**

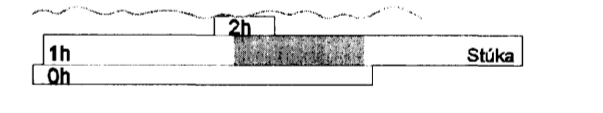

G	22.01.10	Neyðarýsling og t...	BSG/ÖG
F	07.12.09	Kveikingar, hússjómakerfi	BSG/ÖG
E	05.11.09	Ýmsar breytingar	BSG/ÖG
D	12.06.09	Ný verslun, breytt herbergi	SF/BSG
C	30.01.08	Breyting á ljósum og raflopi	SF/ÖG
B	08.12.08	Breyting á stígam og ljósum	SF/ÖG
A	27.11.07	Verktækning	RVKHJ
Útg. Dags.	Skýring		Hannabeyrirtard



BÆJARHRAUN 20 · 220 HAFNARFJÖRÐUR · KENNIT. 710796-2899  
vsb@vsb.is · Sími 585 8600 · Fax 585 9610 · www.vsb.is

Áritun sérhönnuðar				Örn Guðmundsson Kt. 220981-2739	
Verkefni					
KAPLAKRIKI					
HAFNARFIRÐI					
Verkefni					
Rafkerfi					
Lágsþenna 1 hæð					
Grunnmynd					
Hannabeyrirtard	Teknað	Yfirfarið	Kvarði	Síða	
RVKHJ	RVKHJ	BSG	1:50	/ A1	-
Dags.	Verkefni	Tekning	Útgáfa		
30.04.2007	06811	A R113	G		

V:\2009\06811\06811-Kaplakriki-FH-Sheets\PAR (Lágsþenna)\06811-R11-Task-A.dwg