

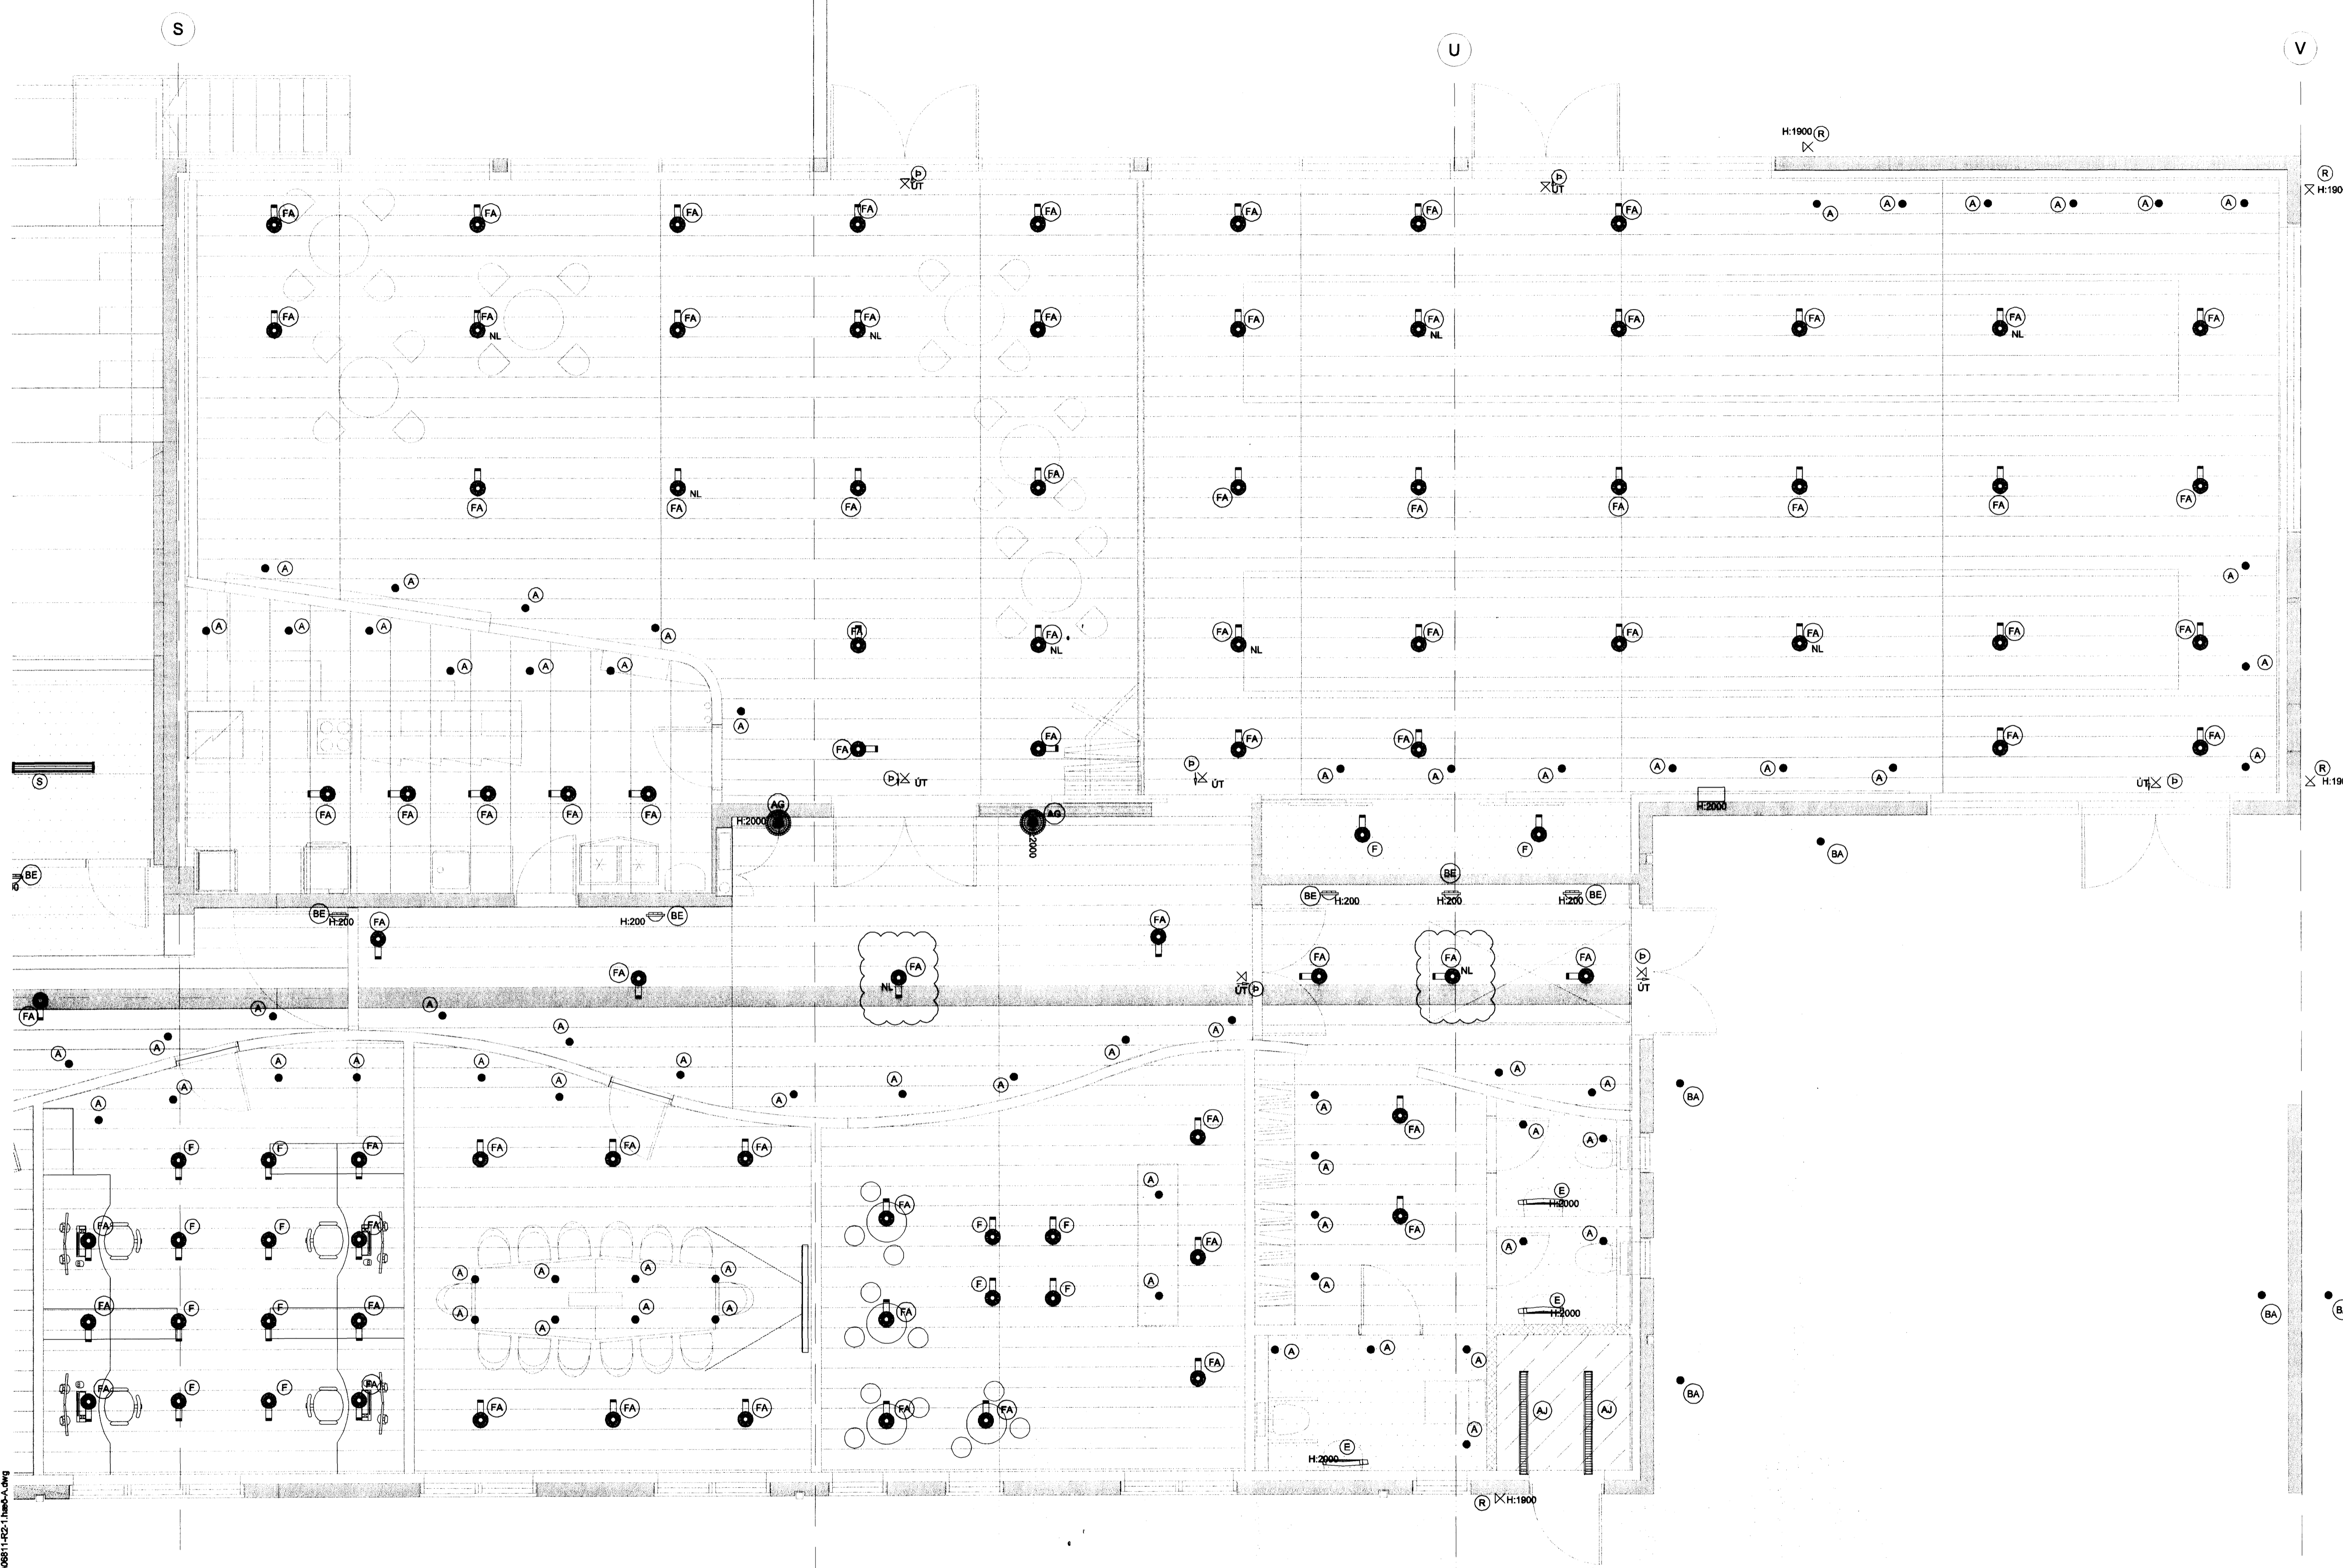


28/1 2010 *H*

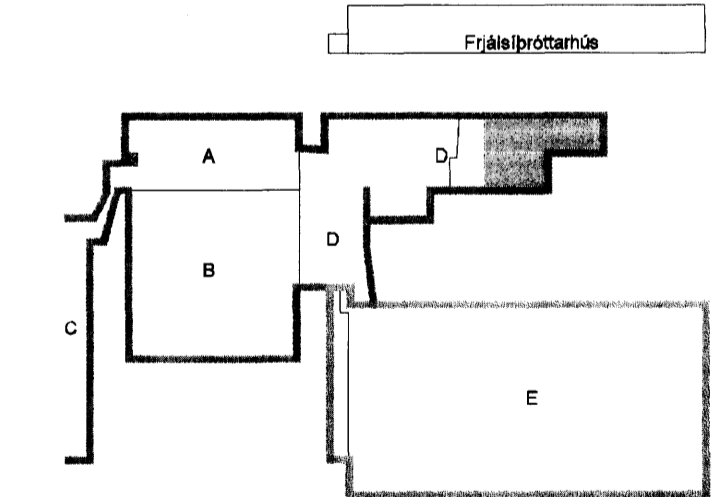

Hanna
 KR. 110457-2789
KAPLAKRIKI

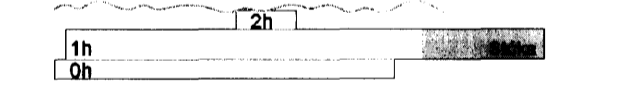

- D 22.01.10 Neyðarlýsing BSG/OG
- C 12.06.09 Breyting á herbergjum SF/BSG
- B 30.01.09 Breytt lampaplan og skýmingaáætla SF/OG
- A 27.11.07 Verkefning RVK/HJ
- Útg. Dags. Skýring Hannab/Yfirfarir

VSB

VERKFRÆDISTOFA

BÆJARHRAUN 20 · 220 HAFNARFJÖRDUR · KENNIT. 710796-2899
 vab@vab.is · Sími 585 8600 · Fax 585 8610 · www.vsb.is

Ártun sérhönnuðar Óm Guðmundsson Kt:220961 2739				
Verkefni KAPLAKRIKI HAFNARFIRÐI				
Verkefni Rafkerfi Lampaplan 1.hæð Grunnmynd				
Hannað RVK/HJ	Teiknað RVK	Kvæði 1:50	/A1	Síða -
Dags. 30.04.2007	Verkefni 06811	Teikning A R214	Útgáfa D	

V:\2009\06811\06811-Kaplakriki-FH\Sheets\RP22 (Lampaplan) 06811-RP21-hafn-A.dwg