


Mottelid
20.10.2010

Handwritten signature

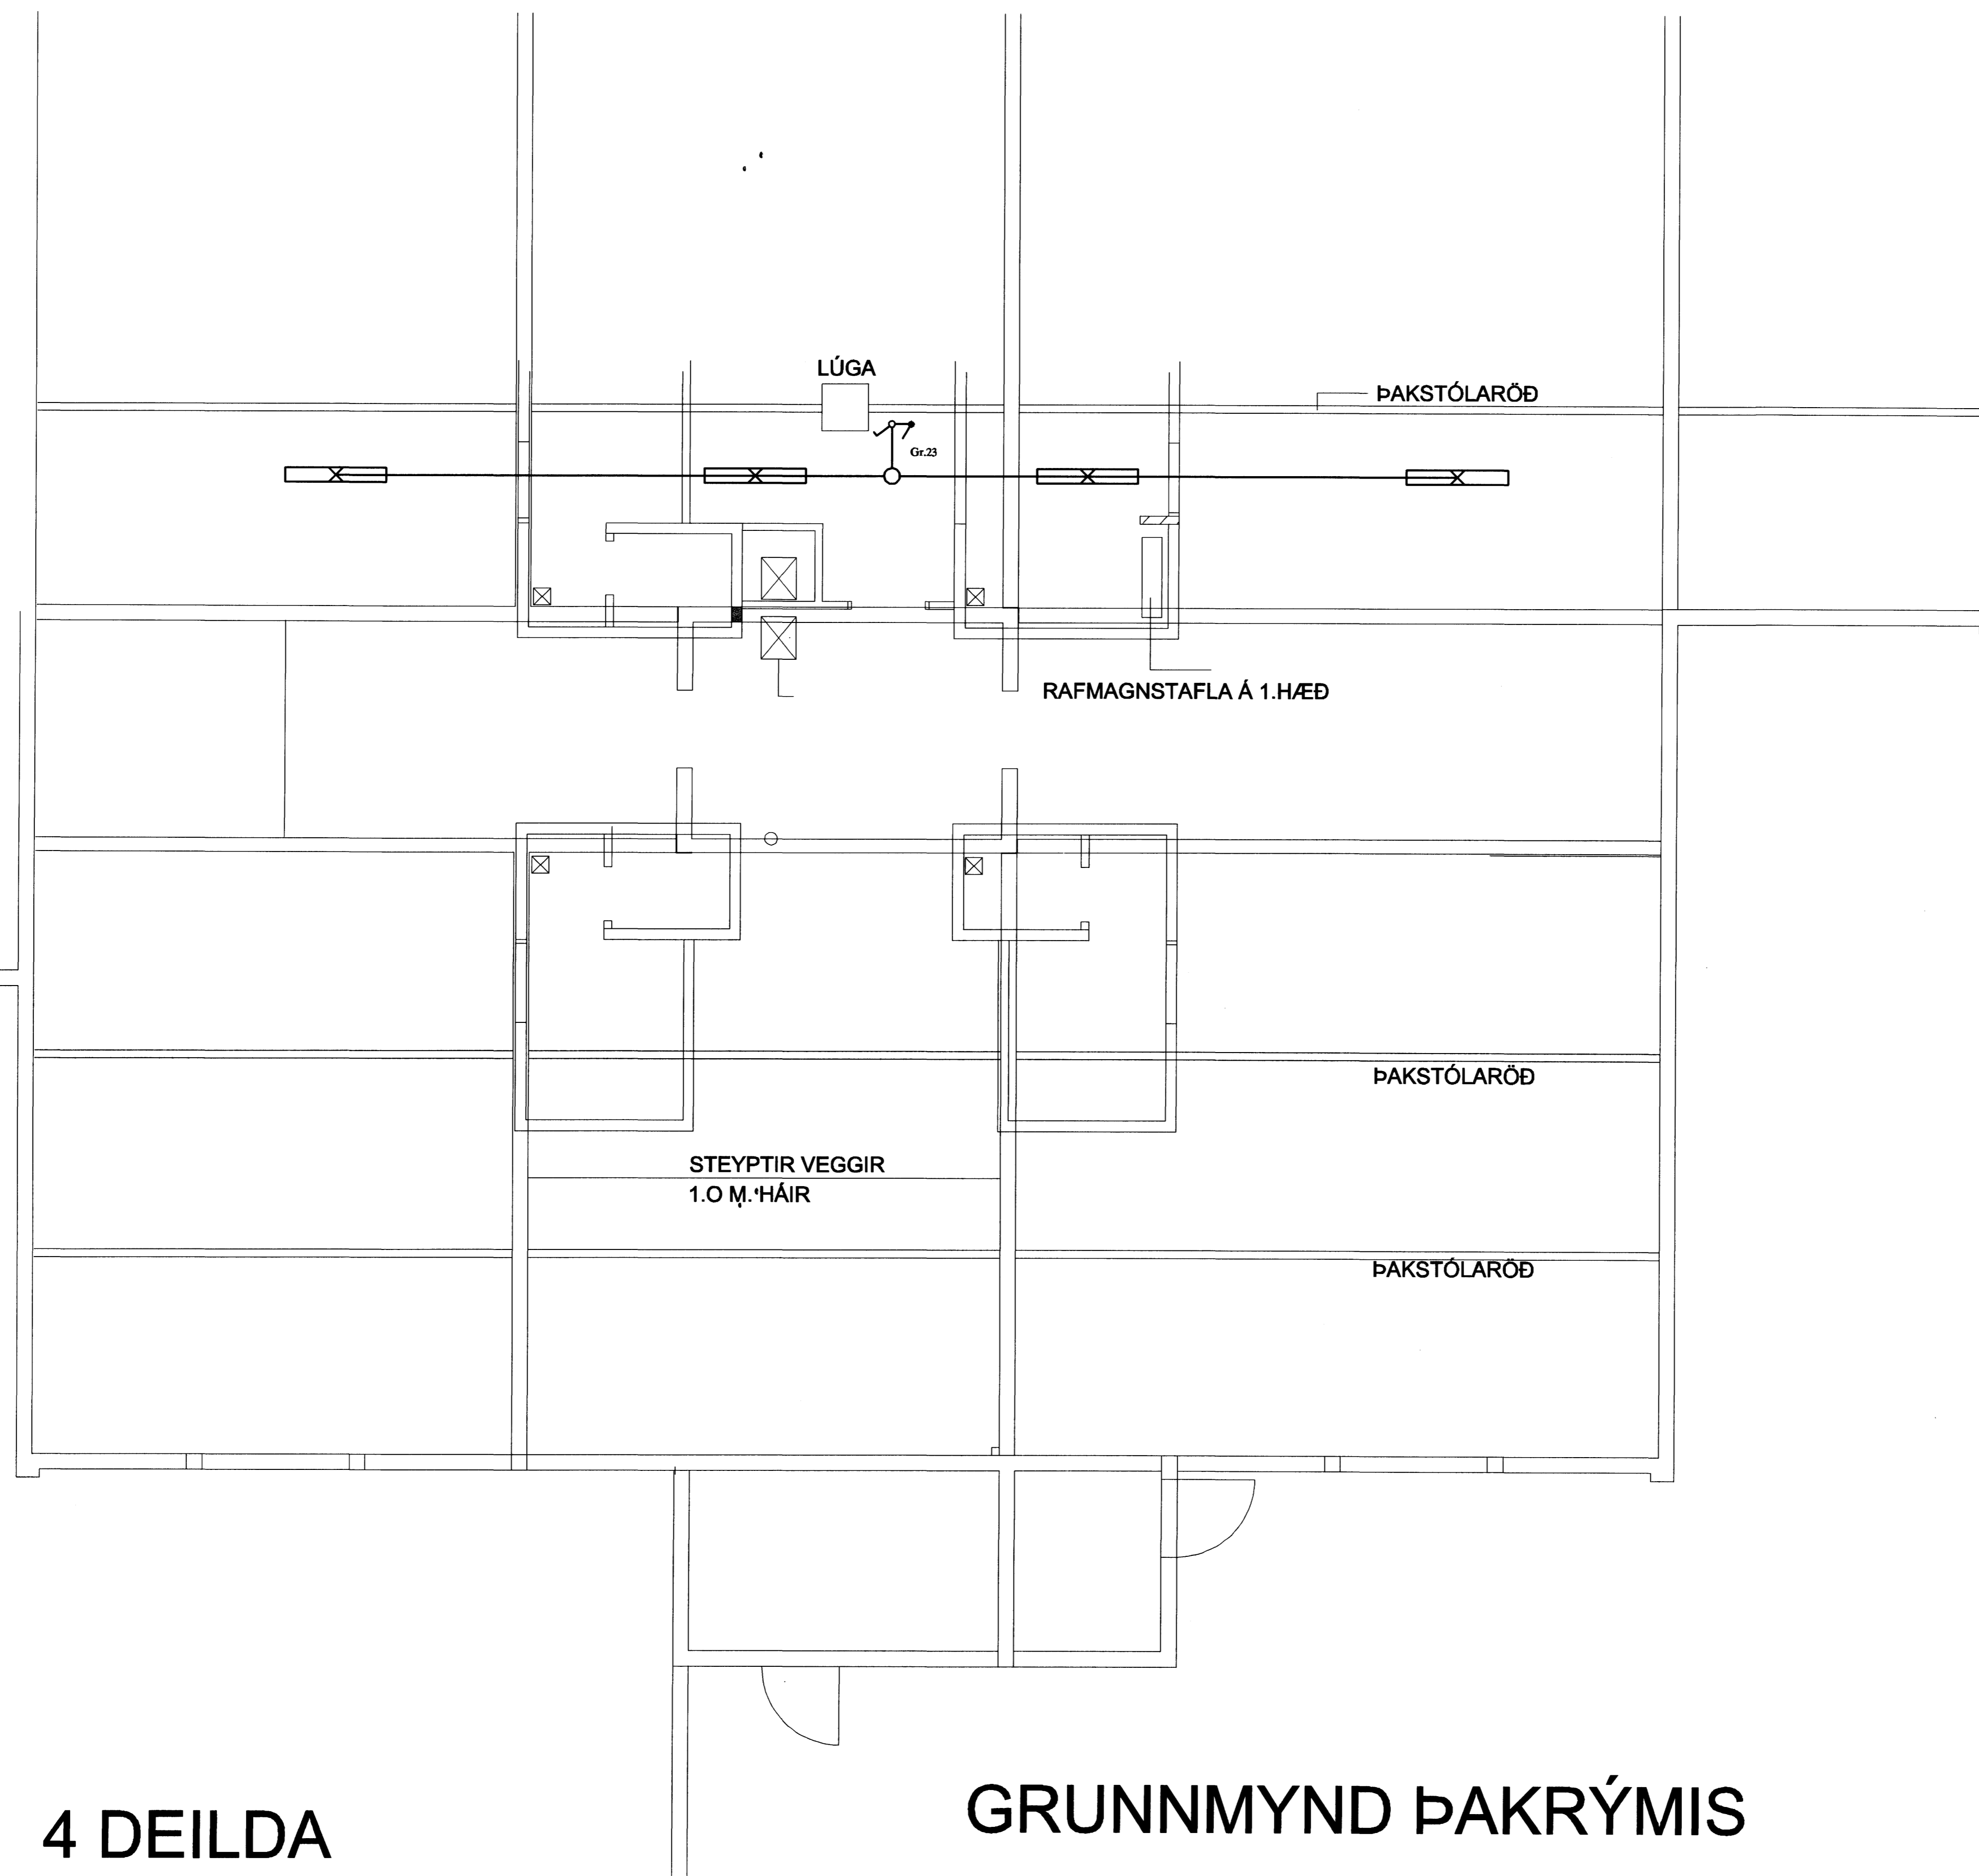

4 DEILDA

GRUNNMYND ÞAKRÝMIS

19182610
Handwritten signature
258144 3939

						ENGIDALSSKÓLI - DAGVISTUN BARNNA		MEY. 1:50	
						RIS		TEK.NR. R2.1	
						RAFLÖGN 1		SÍÐASTA TNR.	
B	10-10-01	REYNDARTEIKNING	B.F.T.	T.S.	<i>Handwritten signature</i>	220146-2439	RAFMA GNSVERKFRÆÐISTOFA		TNR. 4 AF 4
A	10-07-23	VINNUTEIKNING	B.F.T.	T.S.		220146-2439	EDMUND BELLERSEN TRALSTI SVENJÓNSSON		UTO. B
ÚTG.	DAGS.	TEIKN.	NAFNAD	SAMÞYKKT	KENNITALA	TERA S/F		SÍMÍ 568788 SÍMÍ 568790	