



28/4 2010

ARITUN ADALHÖNDUÐAR:  
120357-5149  
ARITUN HÖNDUÐAR:  
210362-4529


UTI INNI  
ARKITEKTAR  
Jón Þór Þorvaldsson AÍ, FSSA  
Kt. 021256 7579

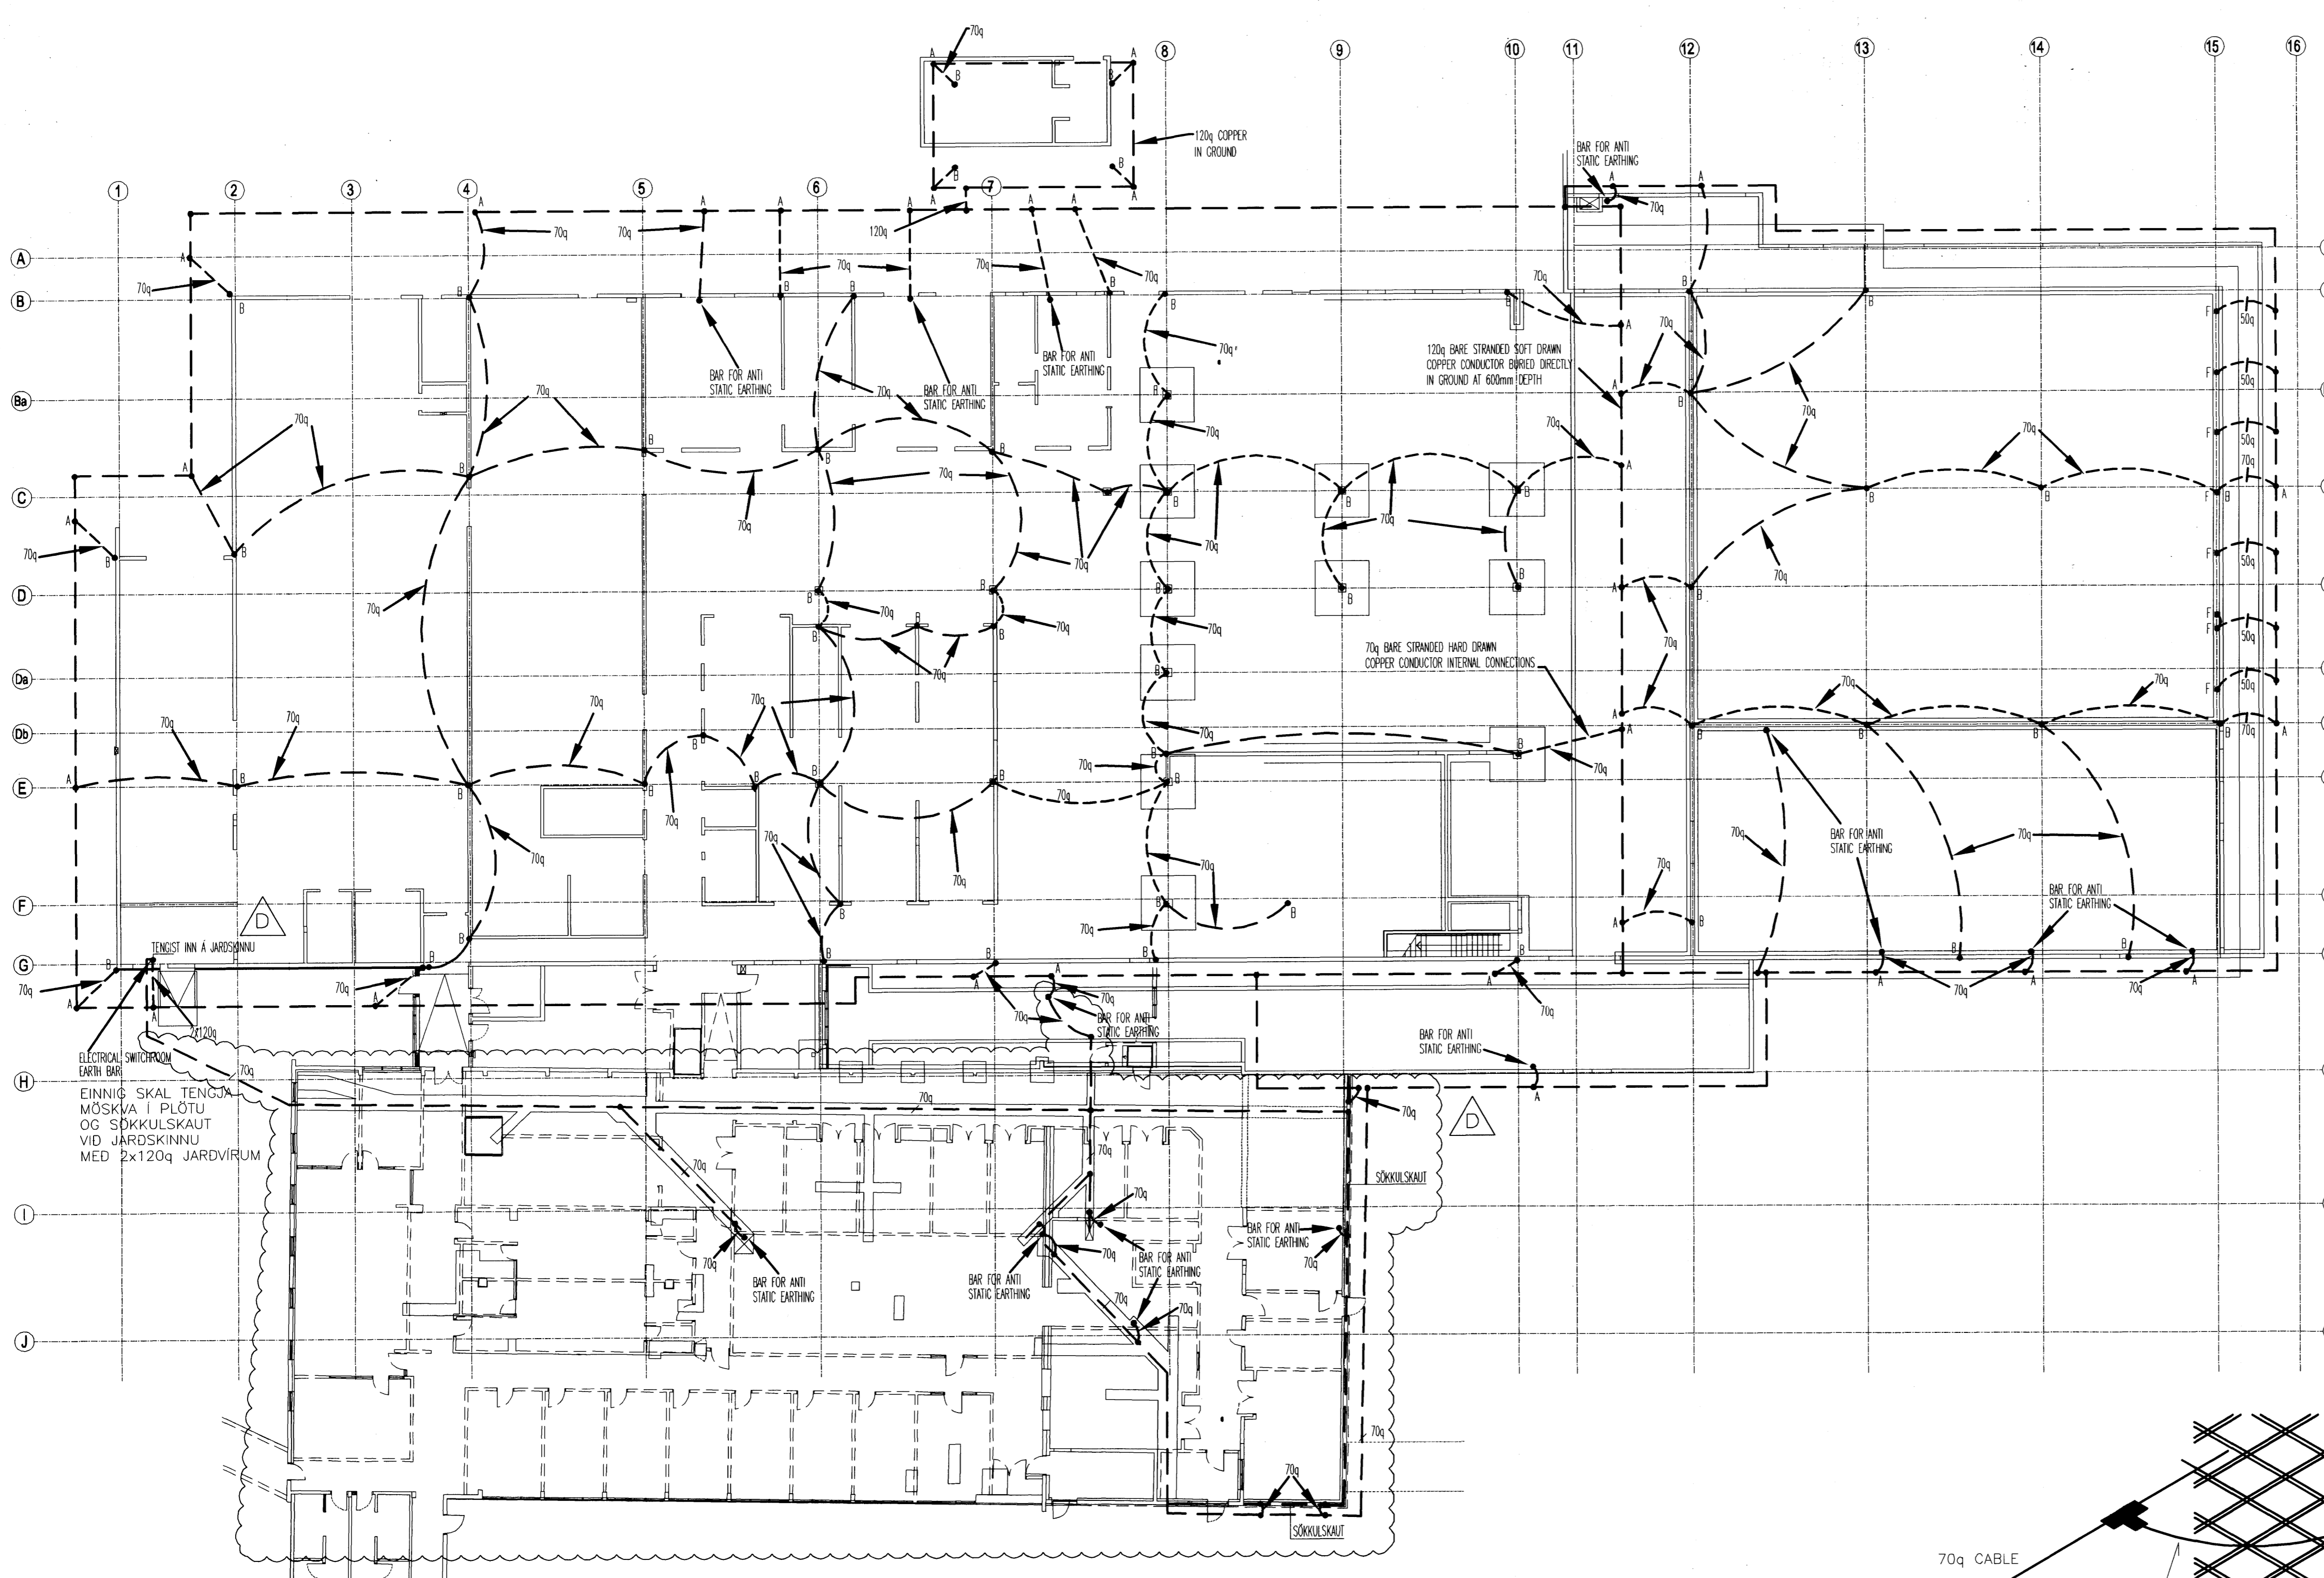

- A CONNECTION TO EXTERNAL PERIMETER TAPE
- B CONNECTION TO REINFORCEMENT USING 12mm STUD WELDED TO PLATE & CONNECTED TO REINFORCEMENT
- D FLOOR BONDING MESH TO BE EARTH BONDED. CONNECTIONS NOT SHOWN. SEE DETAIL 1.
- E 1 No 50q CABLE CONNECTION PER STRUCTURAL BAY TO GROUND TAPES, THUS :-
- F CONNECTION TO THE BUILDING STRUCTURAL STEEL BEAM.


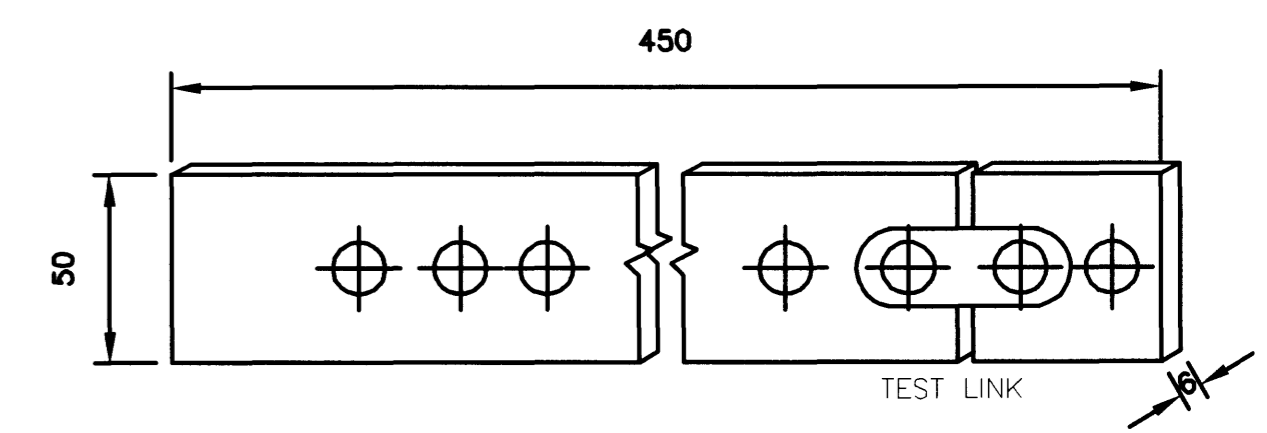


EARTH BAR - COPPER  
MOUNTED ON INSULATORS FIXED TO SWITCHROOM WALL AT 450mm ABOVE FINISHED FLOOR LEVEL.

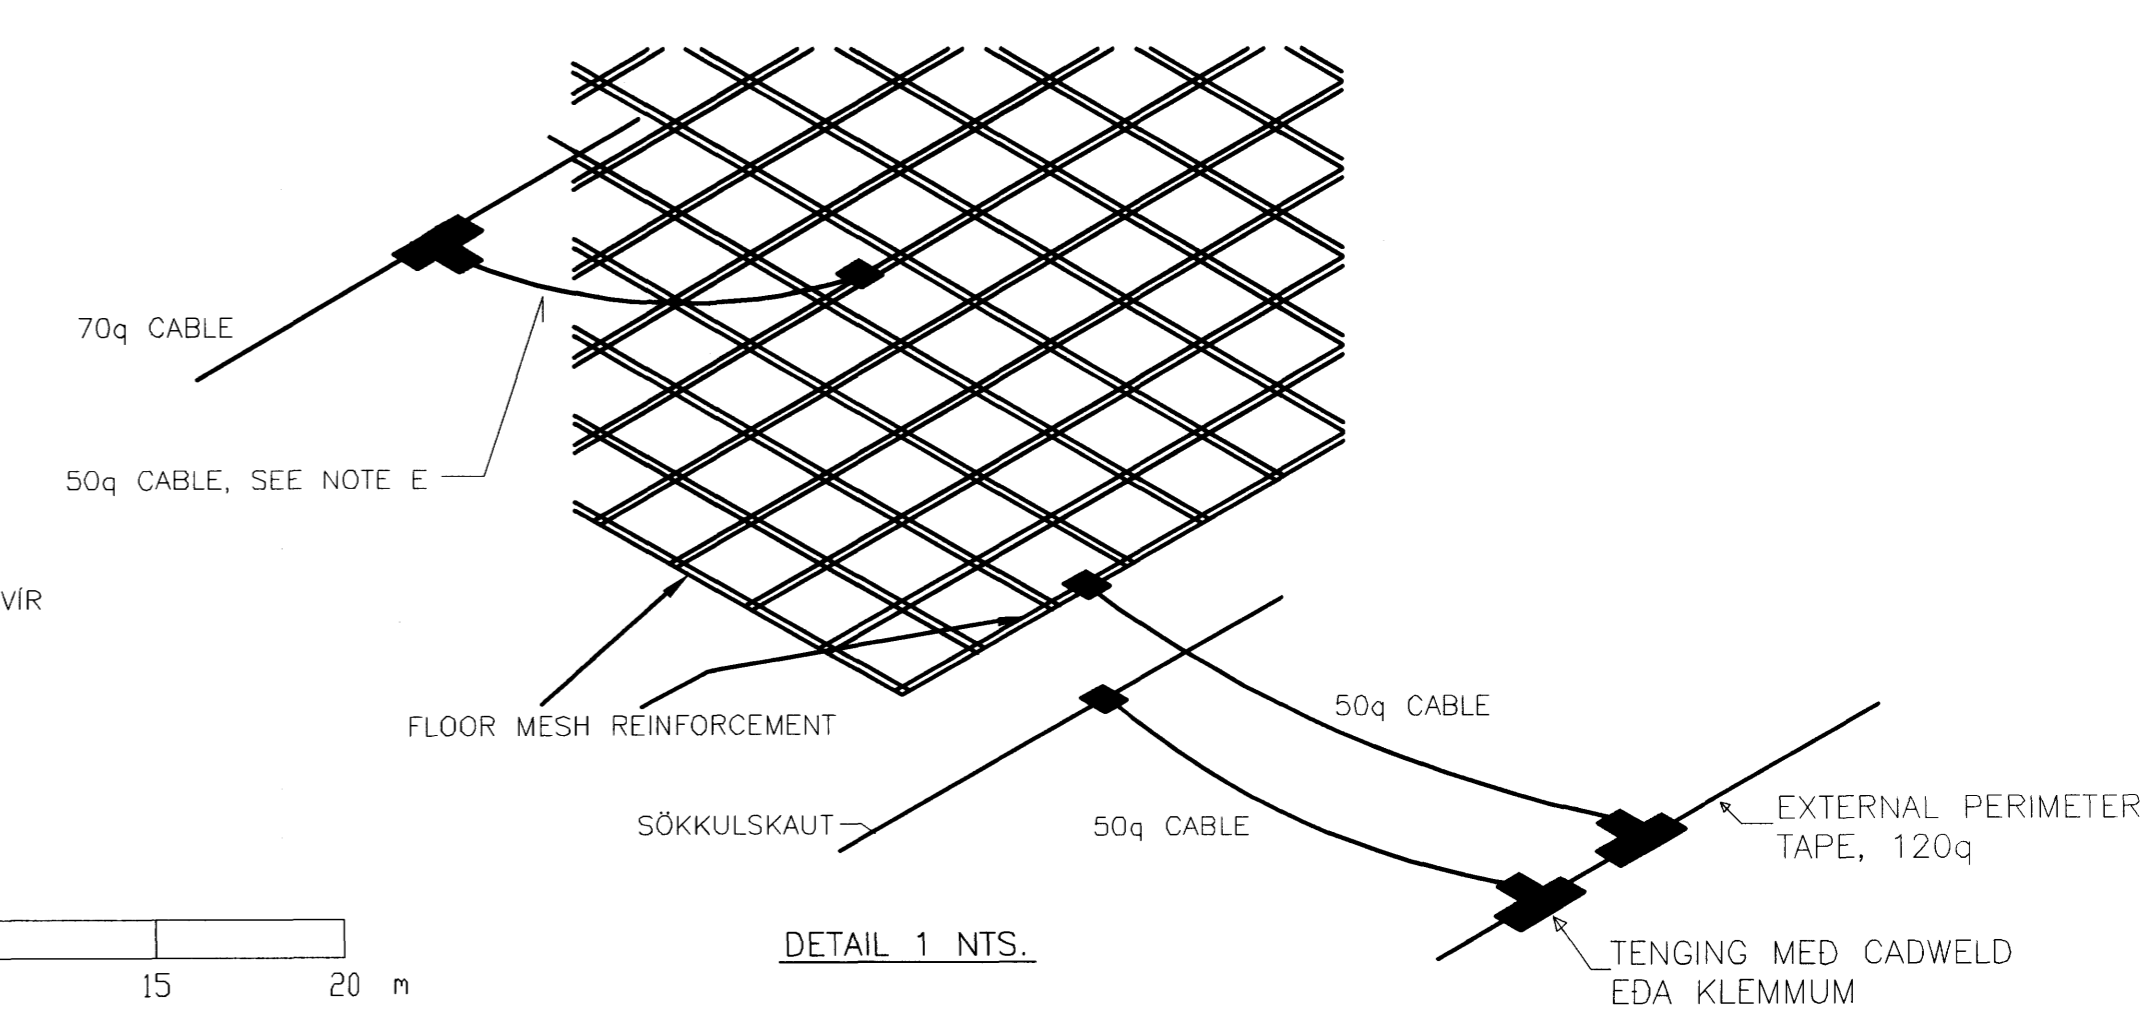

TEIKNING PESSI ER AD MESTU UNNIN AF TANVEC (NO. G0258A/E45/6/072A, EARTHING OF STRUCTURE)

- AUK PESS SEM FRAM KEMUR HJÁ TANVEC SKAL SETJA EFTIRFARANDI:
- BINDA JÄRNAGRINDINA Í PLÖTUNNI SAMAN MED KLEMMUM Þ.A. HÚN MYNDI 10x10m MÖSKVA
  - TENGJA SKAL GRIND (MÖSKVA) ÞESSA REGLULEGA MED 10m MILLIBILI VÍÐ "PERIMETER TAPE" MED 50q Cu VIR
  - SETJA REGLUBUNDIÐ SÖKKULSKAUT OG TENGJA MED 10m MILLIBILI VÍÐ "PERIMETER TAPE" MED 50q Cu VIR

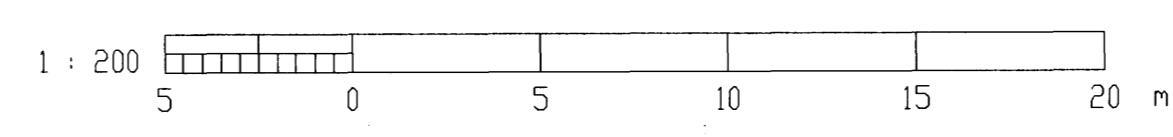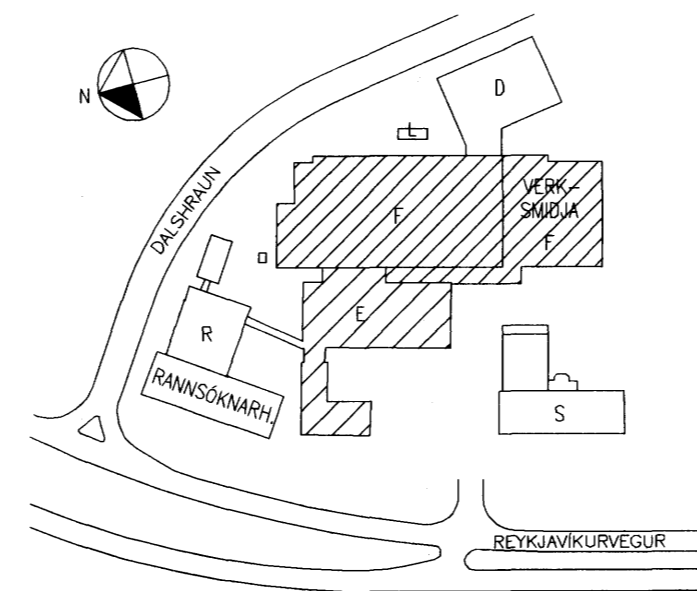

				SAMÞYKKT: D 10.04.20 E-HÚSI BÆTT VÍÐ RÓJ BIS ÞGH EKP C 04.10.05 VIBBÆTUR RÓJ BIS ÁGE GIG A 97.04.14 VERKTEIKNING BIS BIS HS FA		REYKJAVÍKURVEGUR 78, HFJ. F-VERKSMÍÐJA OG E-HÚS, ELÐRI VERKSMÍÐJA JARÐSKAUT OG SPENNUJÓFNUN SÖKKULSKAUT =22 + FLOKKUN BLAÐ	
TILVÍSUN	IS1F-E22-00.01D	www.verkis.is - sími: +354 422 8000		ÚTG DAGS	SKYRINGAR	TEIK HANN RÝNT SAMÞ	VERKFAANG 97001 TEIKNING 22.5.F001 D

© Öll rétt og öðrum teikningar, öð hluta eða í heild er höð skriflegu leyfi höfundar