




SNID A-A

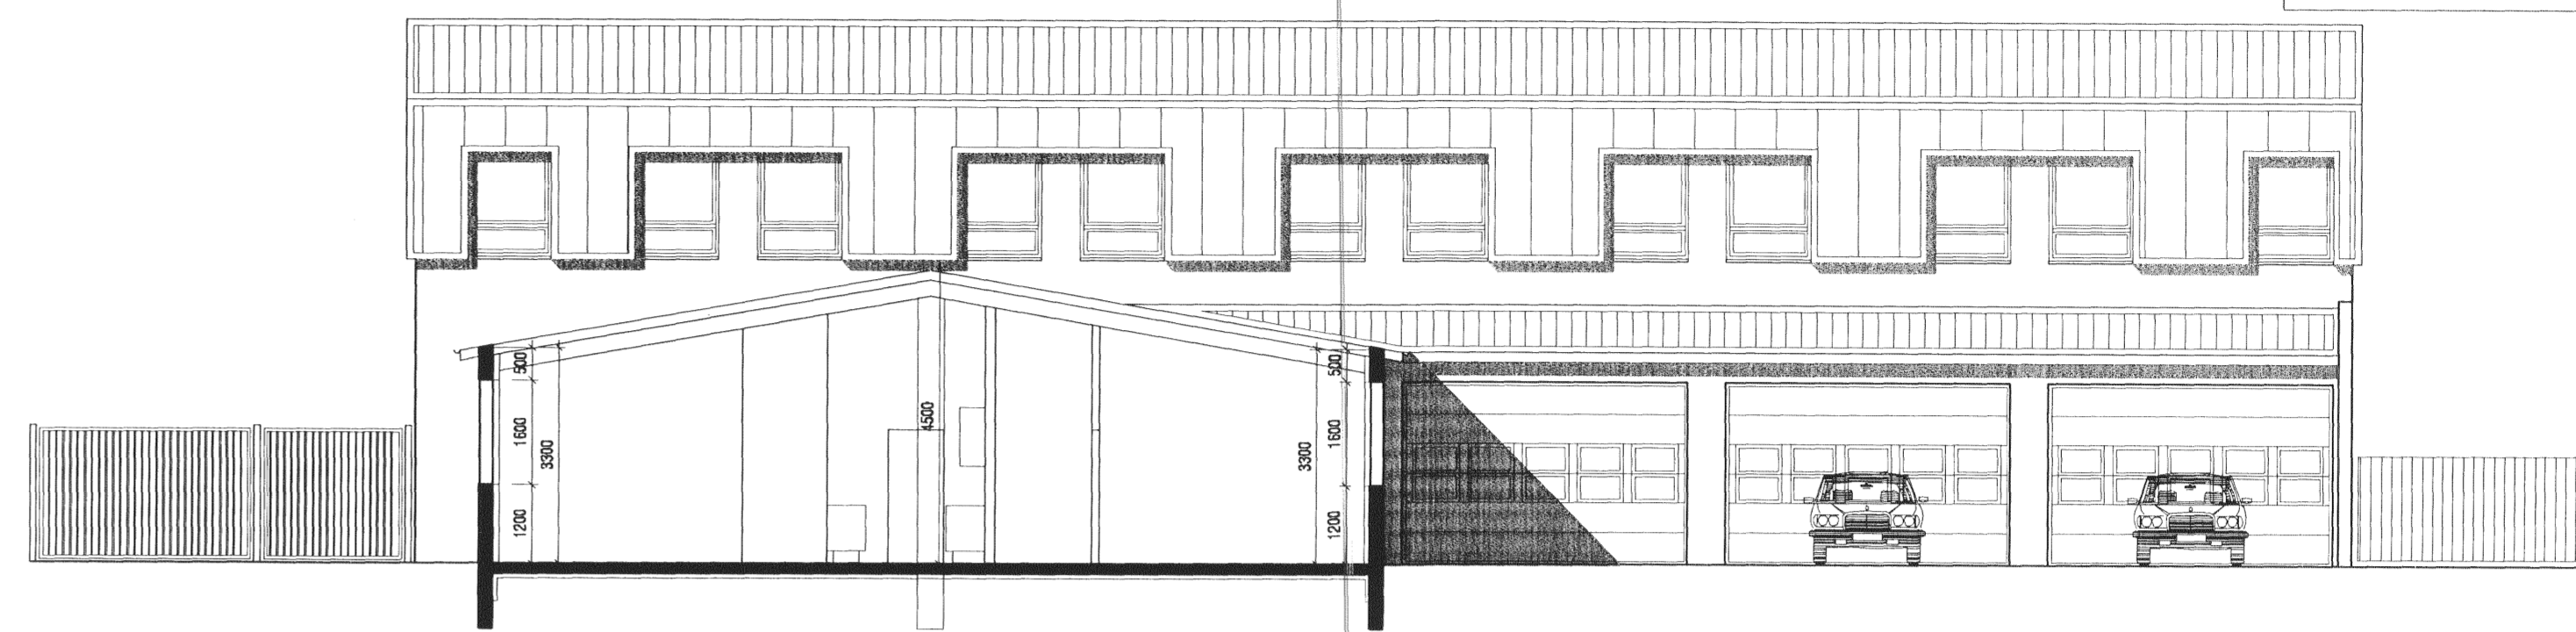


SNID B-B

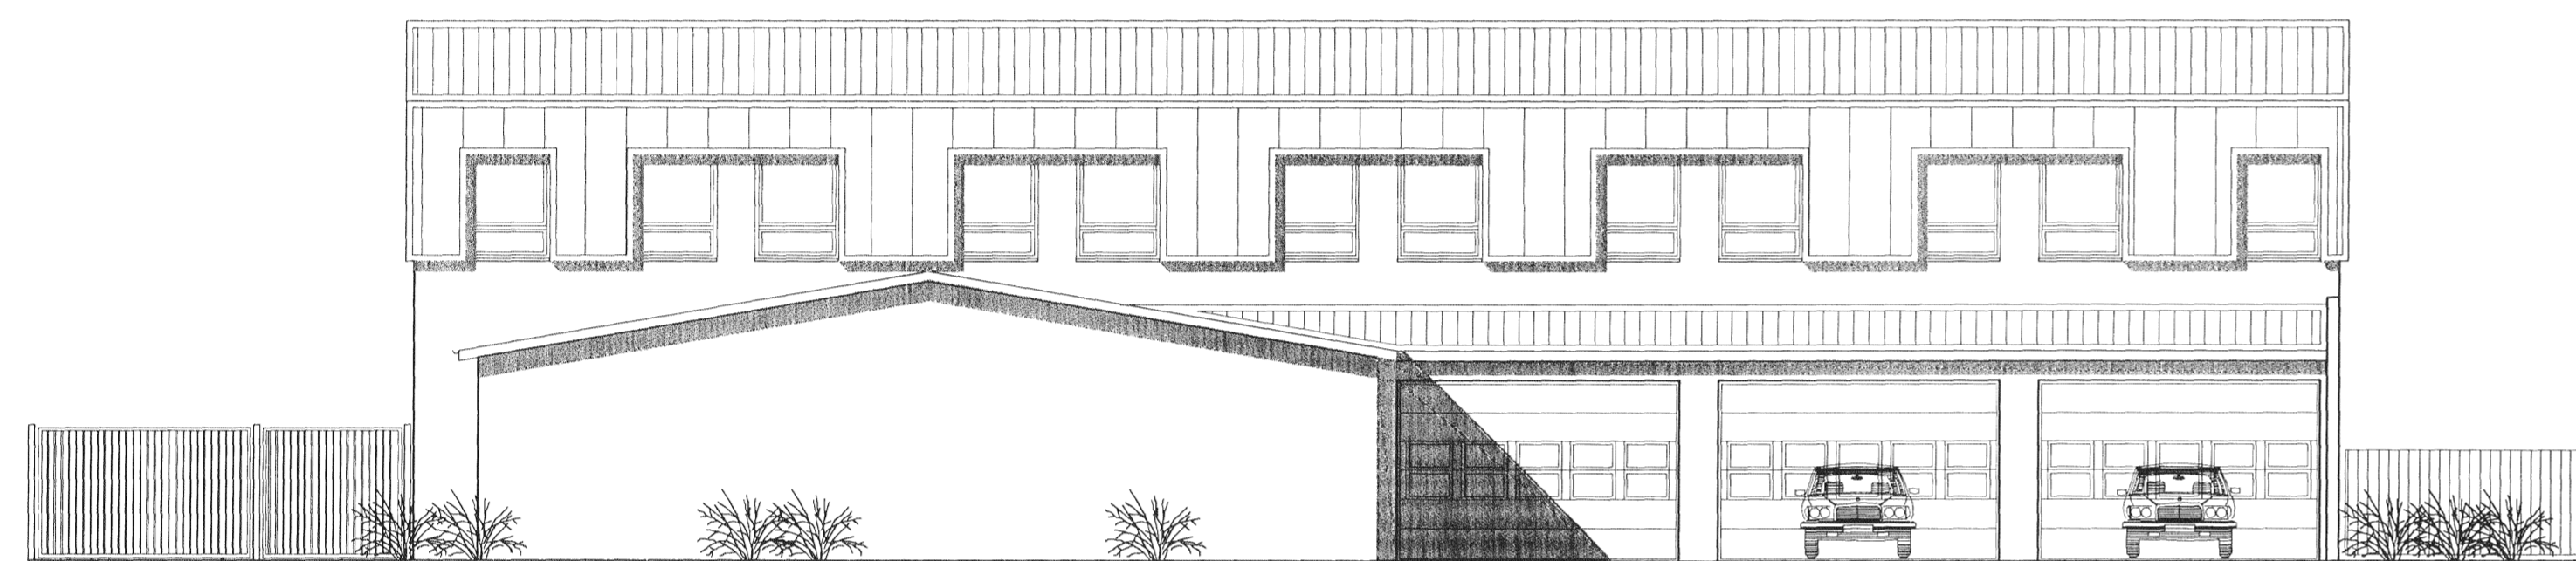


ÚTLIT NORDUR

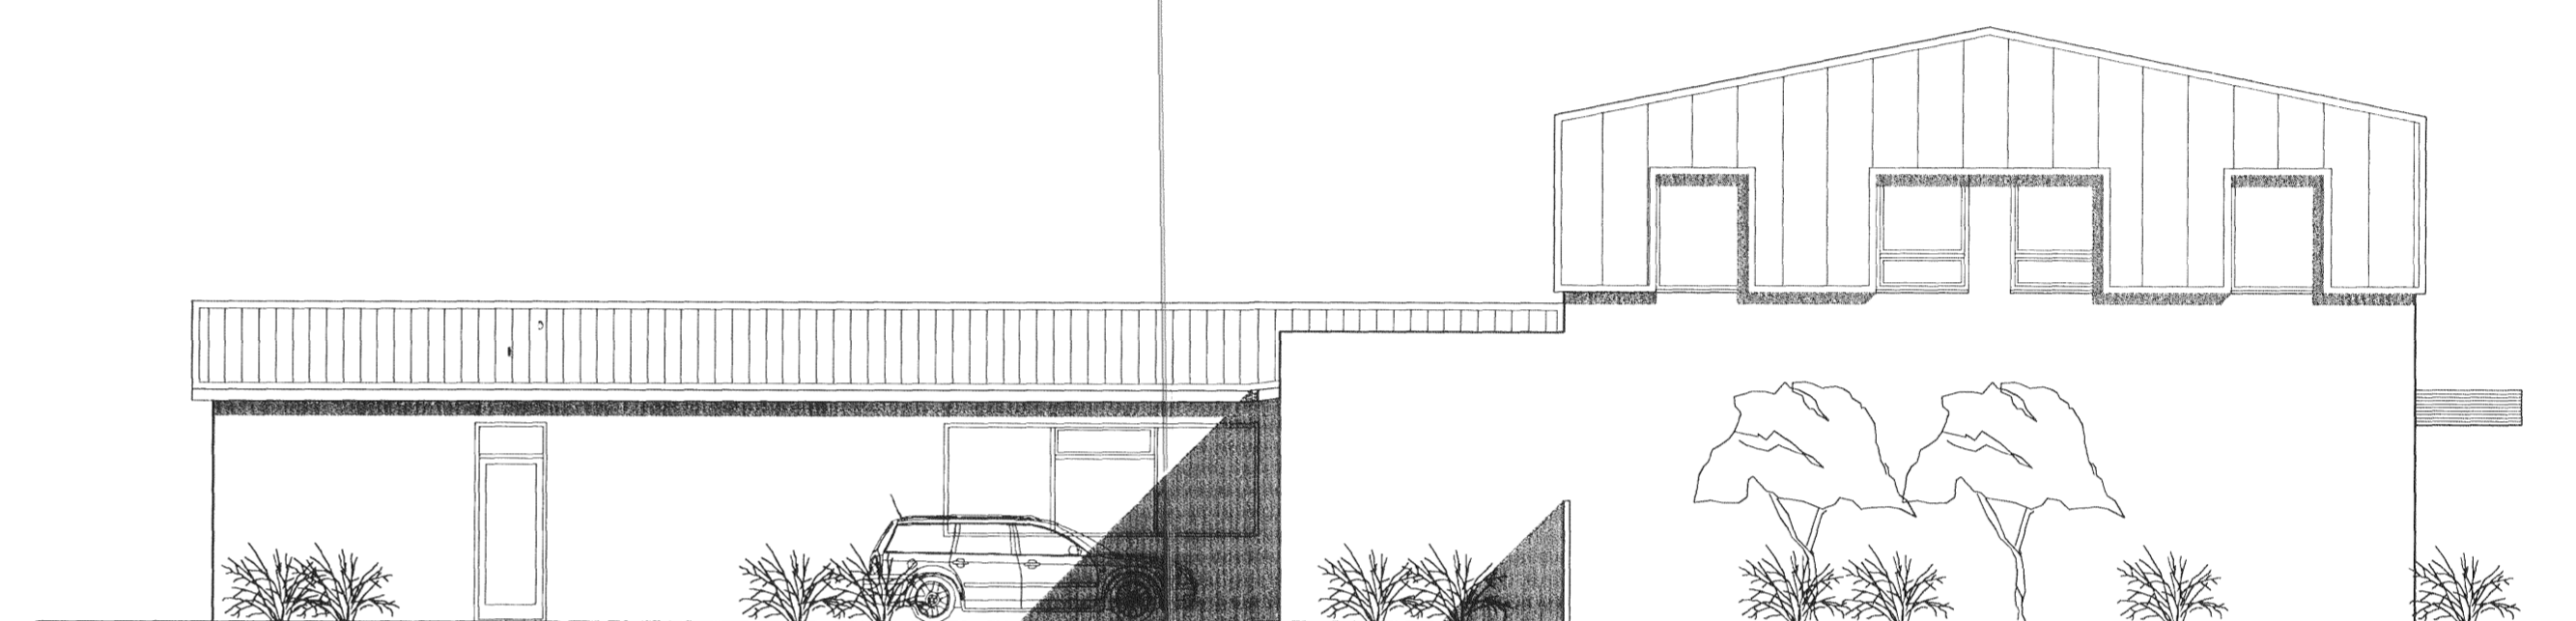

ÚTLIT VESTUR

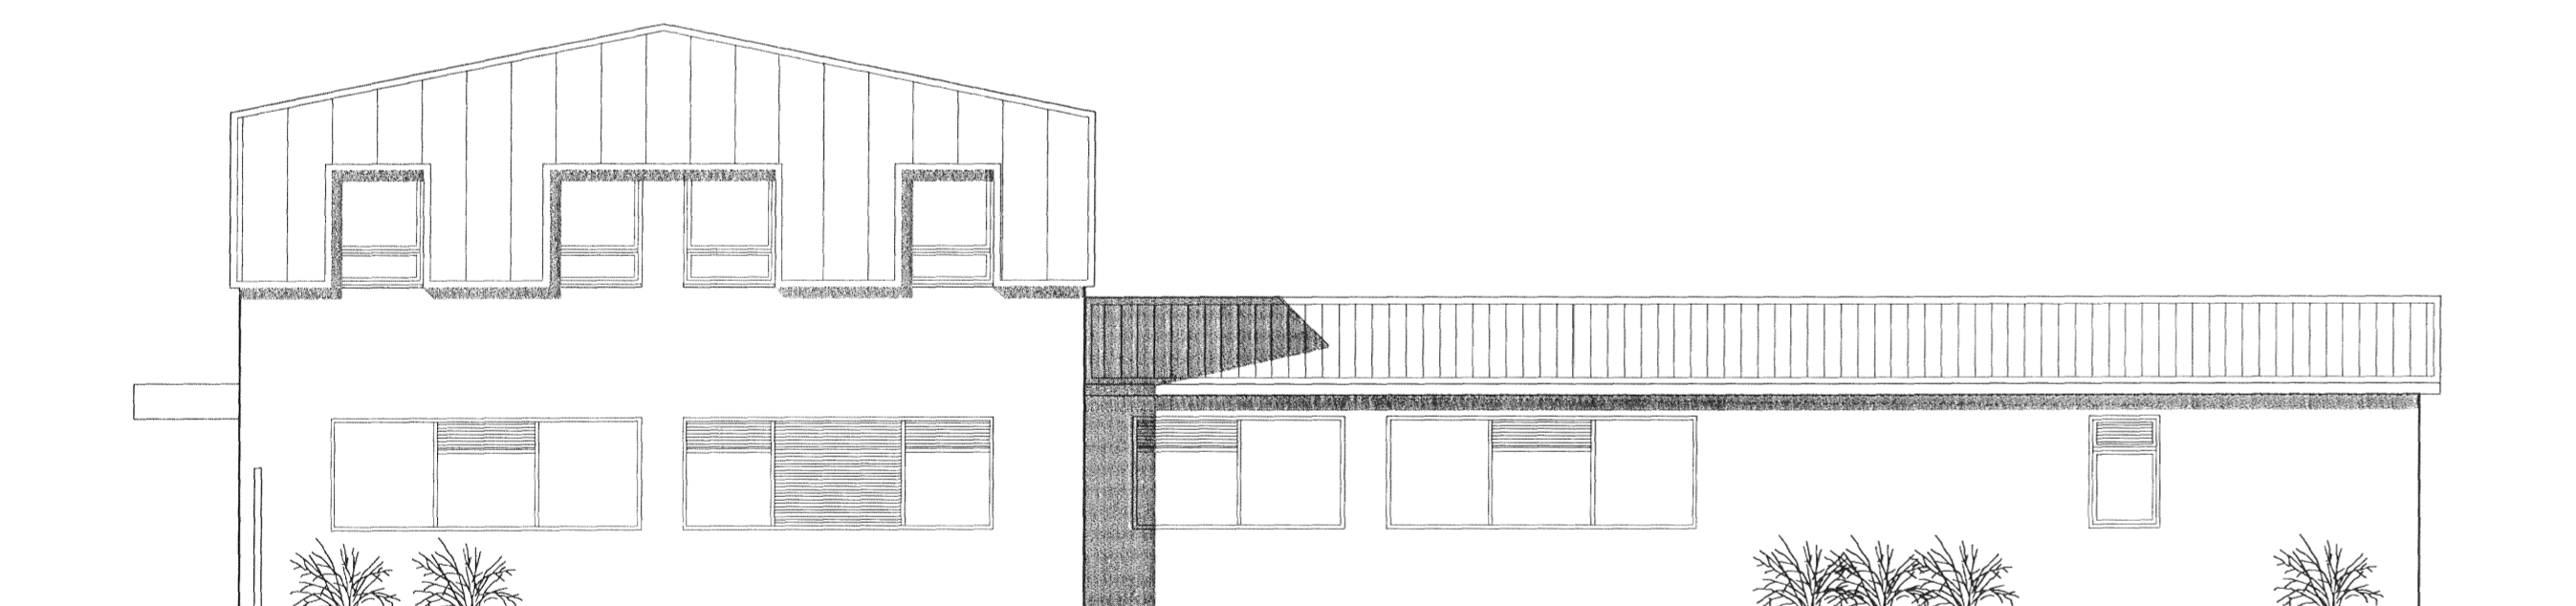


ÚTLIT AUSTUR

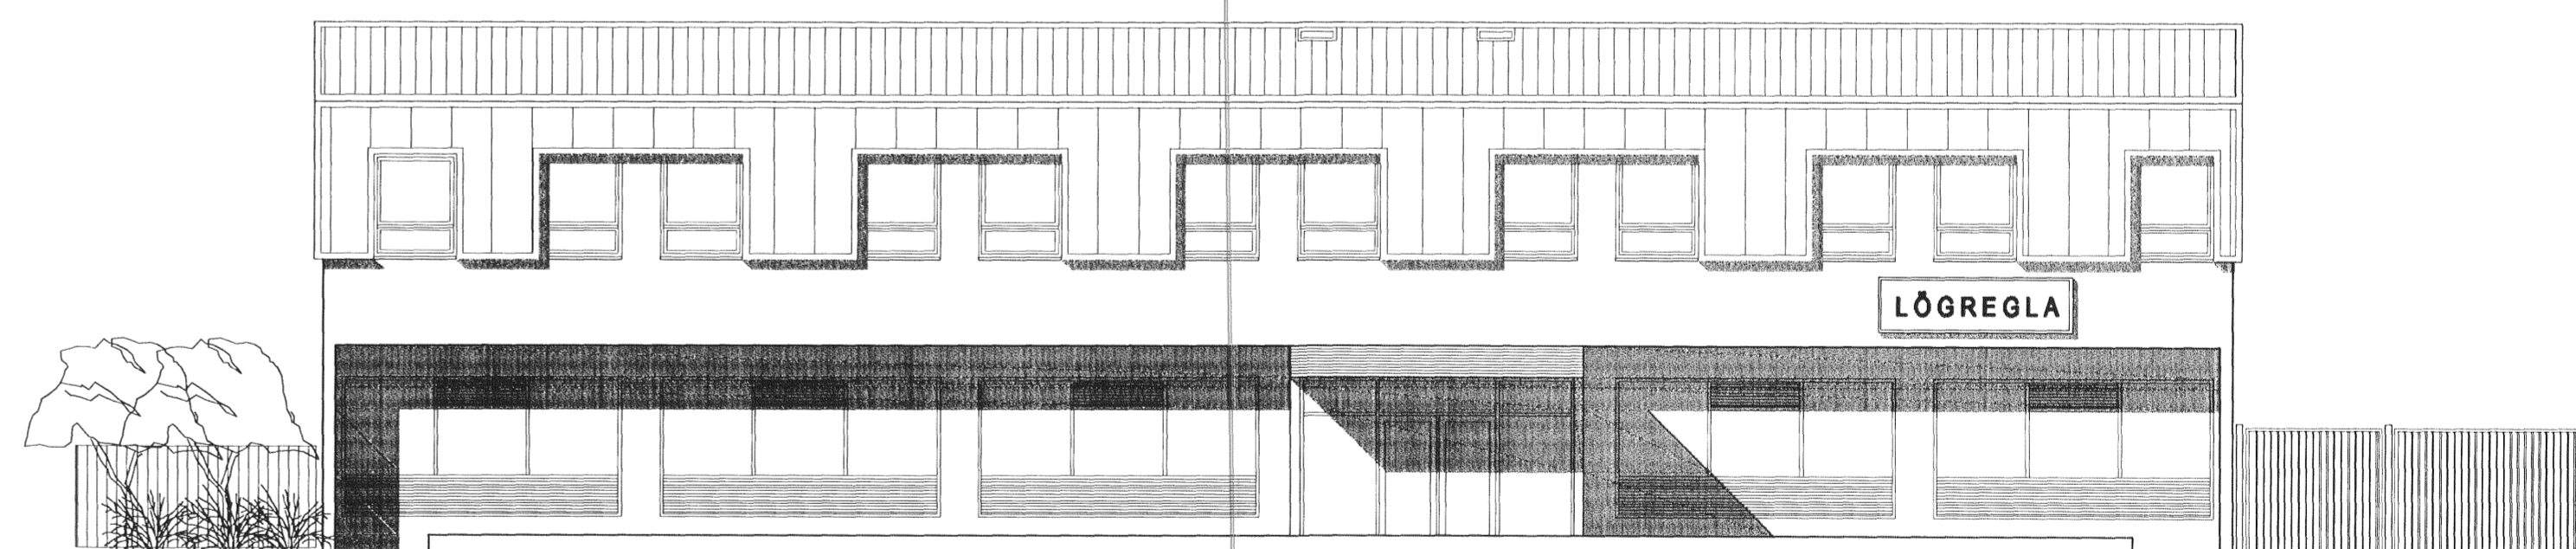

ÚTLIT SUÐUR

REYNDARTEIKNING

mansard
teiknistofa ehf

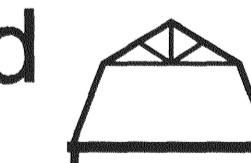

Hraunbrún 30 - 220 Hafnarfjörð
Kt.: 570394-2079 - mansard@hotmail.com

Verkhelti: FLATAHRAUN 11, HAFNARFIRÐI

Efni: BYGGINGARNEFNDARTEIKNING
ÚTLIT

Verknúmer: A-04-11-01 Mkv.: 1:100 A1

Teikn. nr.: A-003 Daga: 08.04.11

Hannað: JHH Teiknað: JHH

Jón Hrafn Hlökkverson byggingafræðingur

Kt.: 260662-6519 - s: 862-7102

Samþykkt: