
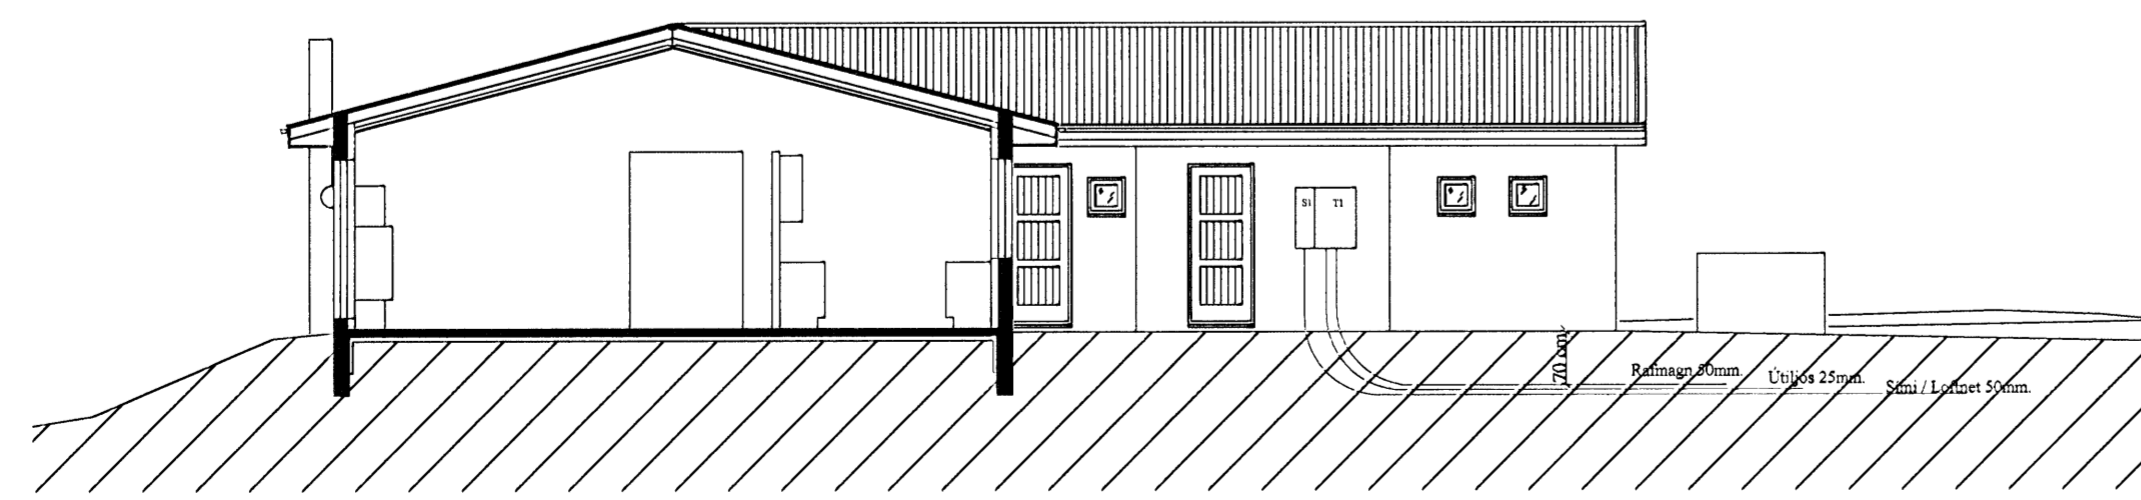


EINLÍNUMYND

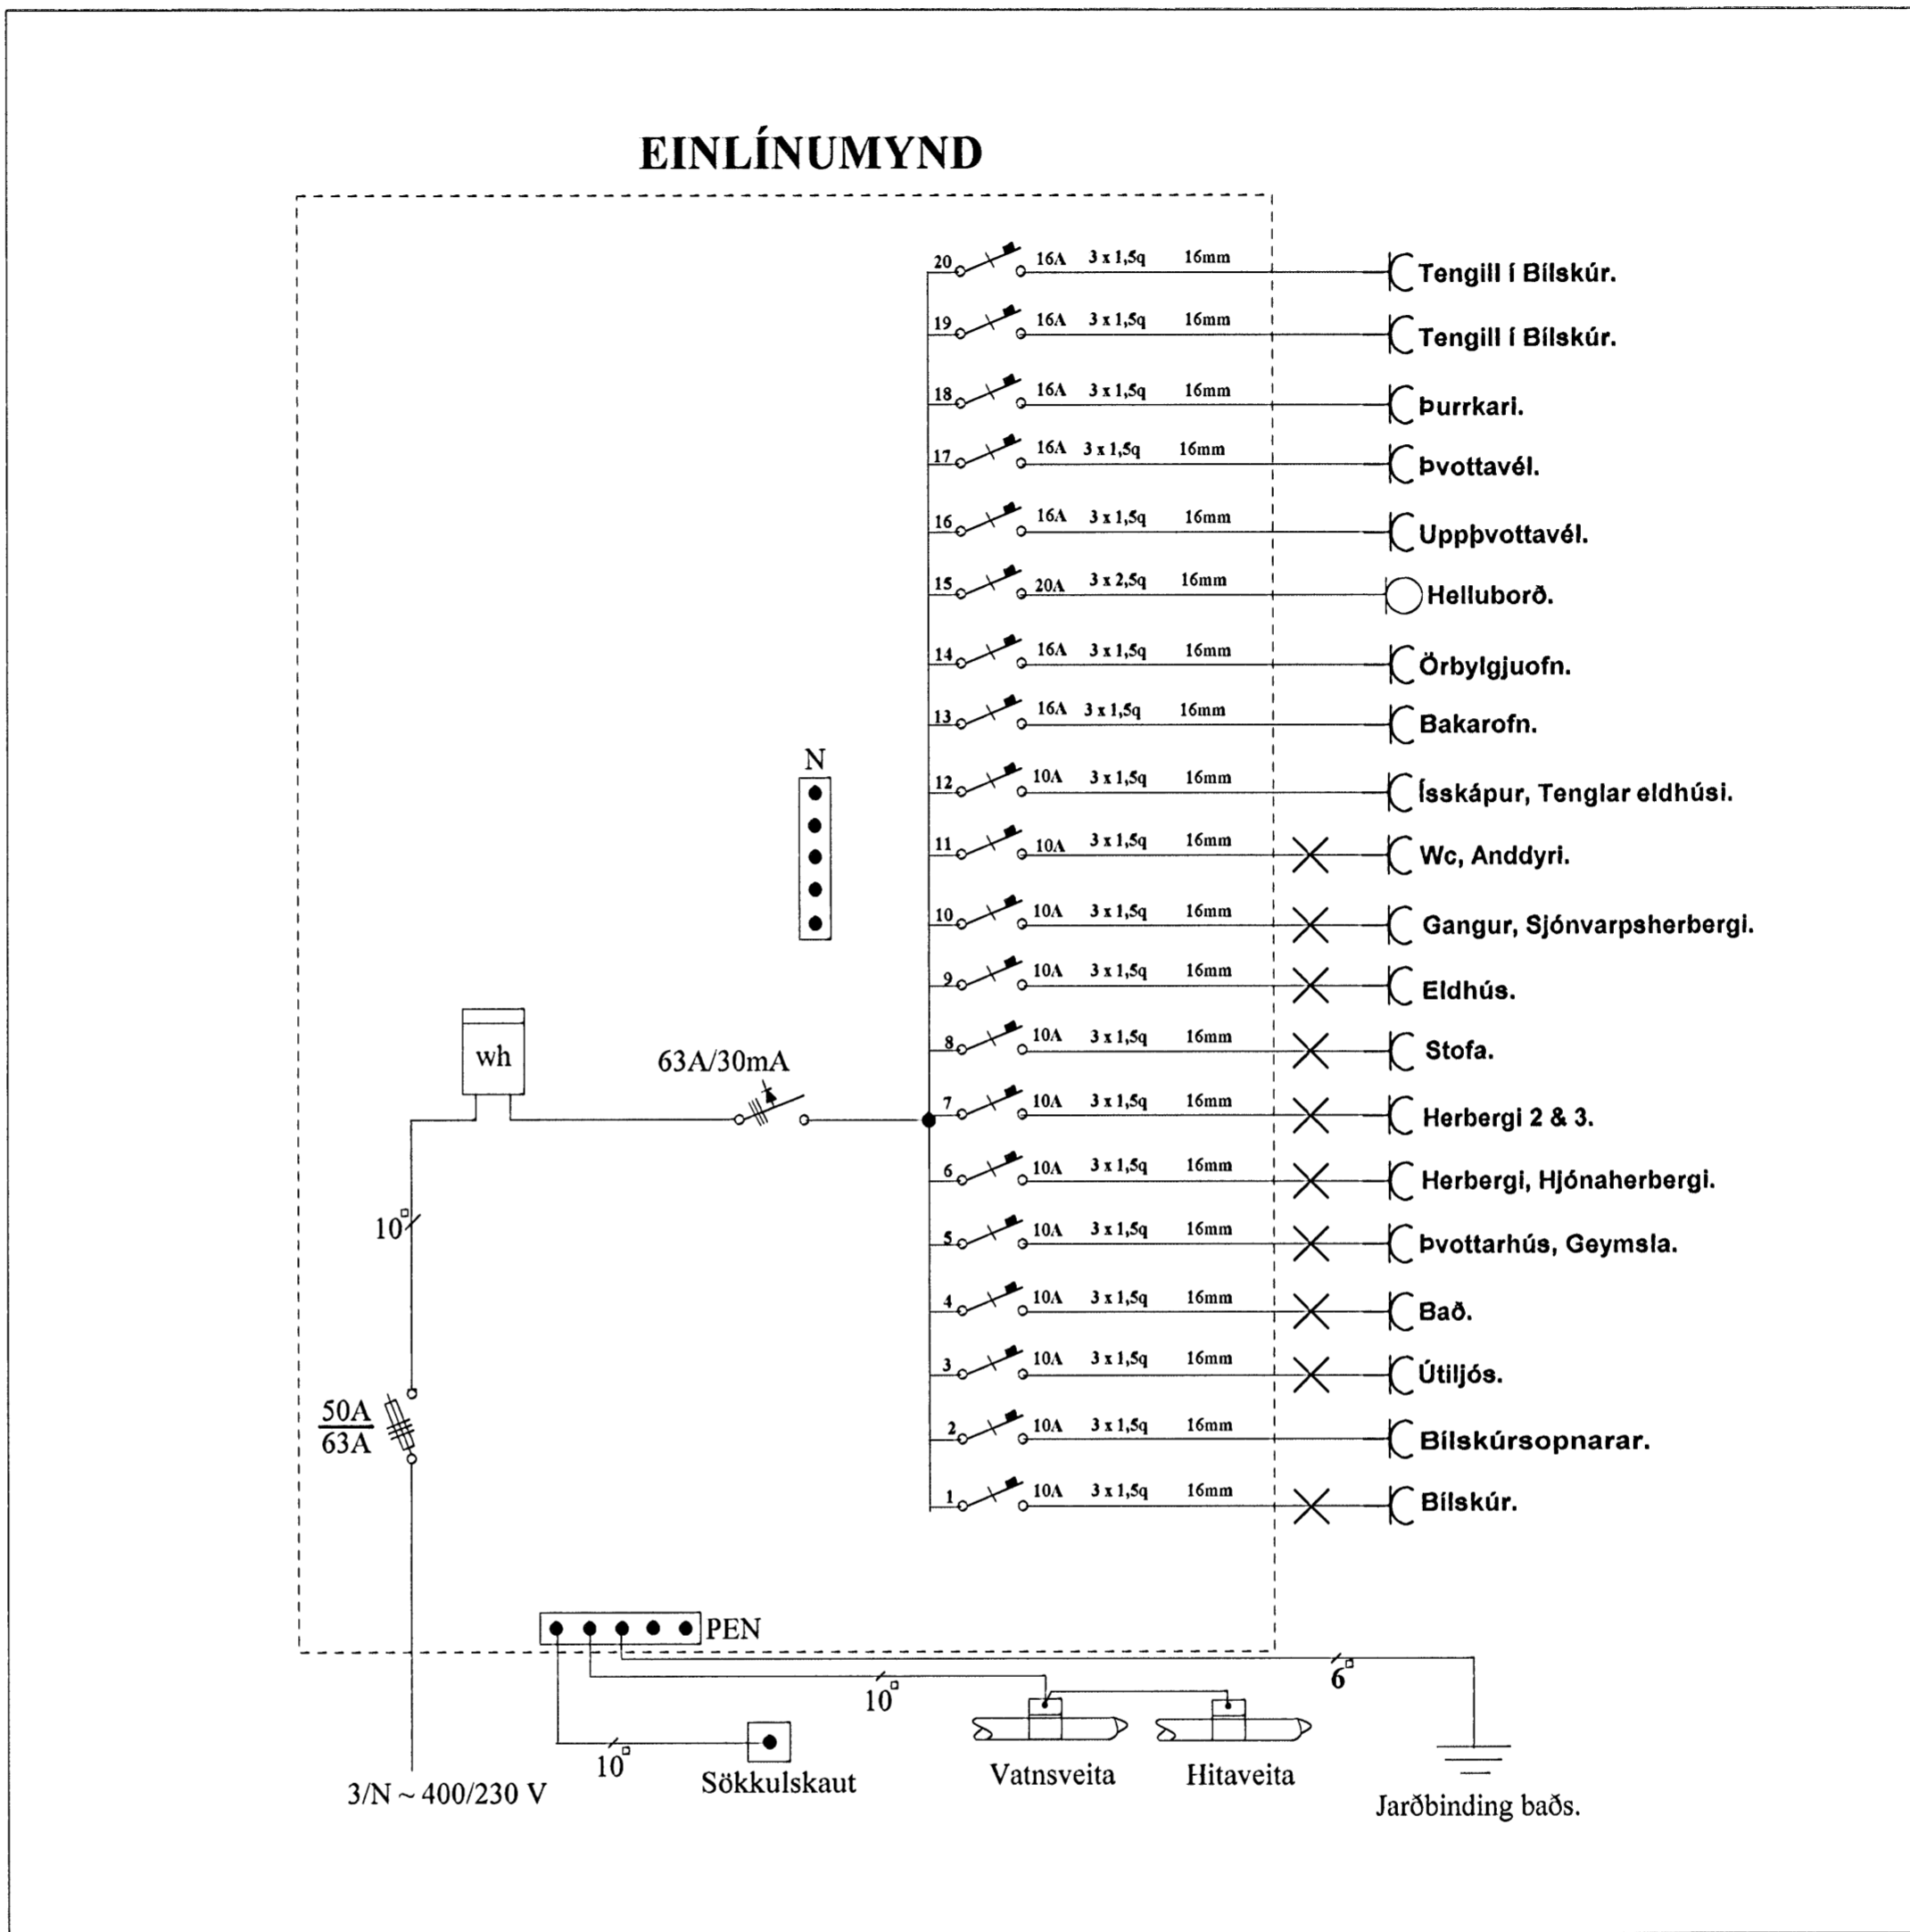

SNIDMYND 1:100

YFIRFARIR  
22. Okt. '09  
Aft

<b>Raf-Bræður ehf</b> Svanur H. Þórhallsson, Raflagnahönnuður kt. 010267-3319. S.5675880 GSM.8965086			
Verkefni: Glitvellir 38. Hafnarfjörður.		Teikning: Snidmynd - Einlínnumynd.	
Teiknað: Svanur.	Kvarði: 1:100 /	Dags: 20.Okt.2008	Teikning nr: 3 af 4.
<i>Svanur Þórhallsson</i>			