


ÓTGÁFUFRILL


NÚMÉR:	DAGS:	SKRANGAR:	HANNAÐ:
B1	12.12.2006	BYGGINGARTEIKNING	BIO
B2	26.10.2007	STÆKKUN HÚSS	BIO
R1	18.07.2008	REYNDARTEIKNING	BIO

DAGS. UNDRISKRIFAR: NAFN OG KT. SAMREINGARHÖNNUNAR:

UNDRISKRIF SAMREINGARHÖNNUNAR: *[Signature]*

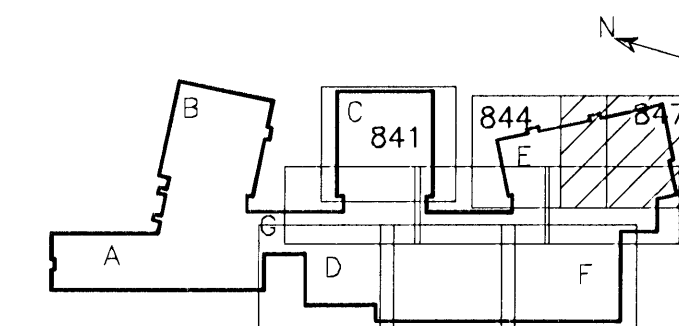

LYKILMYND

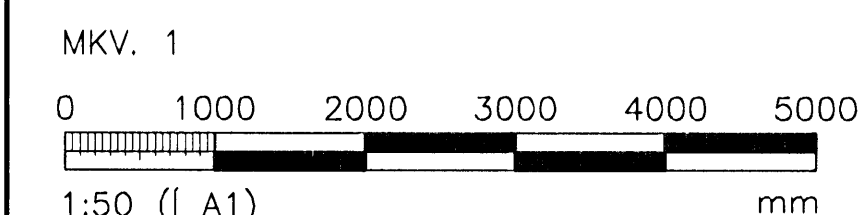

ÖLL AFNOT OG AFRITUN TEIKNINGA, AD HLUATA EDA HEILD, ER HÁÐ SKRIFLEGU LEYFI HÖFUNDA.

VGK HÖNNUN
 GRENSÁSVEGI 1 - 108 REYKJAVÍK - Sími: 422 3000 - FAX: 422 3001
 VEFANG: www.vgkhonnun.is - NETFANG: vgkhonnun@vgkhonnun.is


HEITI VERKS:

HRAUNVALLASKÓLI 2. AF.
DREKAVELLIR 9, HAFNARFIRDI

HEITI TEIKNINGA:

LOFTRÆSIKERFI:
3. HÆÐ, GRUNNMYND

MELT:	TEIKNAD:	GEYMSLUNUMER:	VNR:
	STO		3.151.218
HANNAÐ:	YFRIFARÐ:	MKV:	NR. TEIKNINGA:
BIO		1:50	
DAGS. UNDRISKRIFAR:	NAFN OG KT. HÖNNUNAR:	L2-847	
31.12.2008	VGK-HÖNNUN hf	430572-0169	
UNDRISKRIF HÖNNUNAR:	ÓTGÁFA:		
LAFUS ÁRS/ELSSON	R1	2008625119	

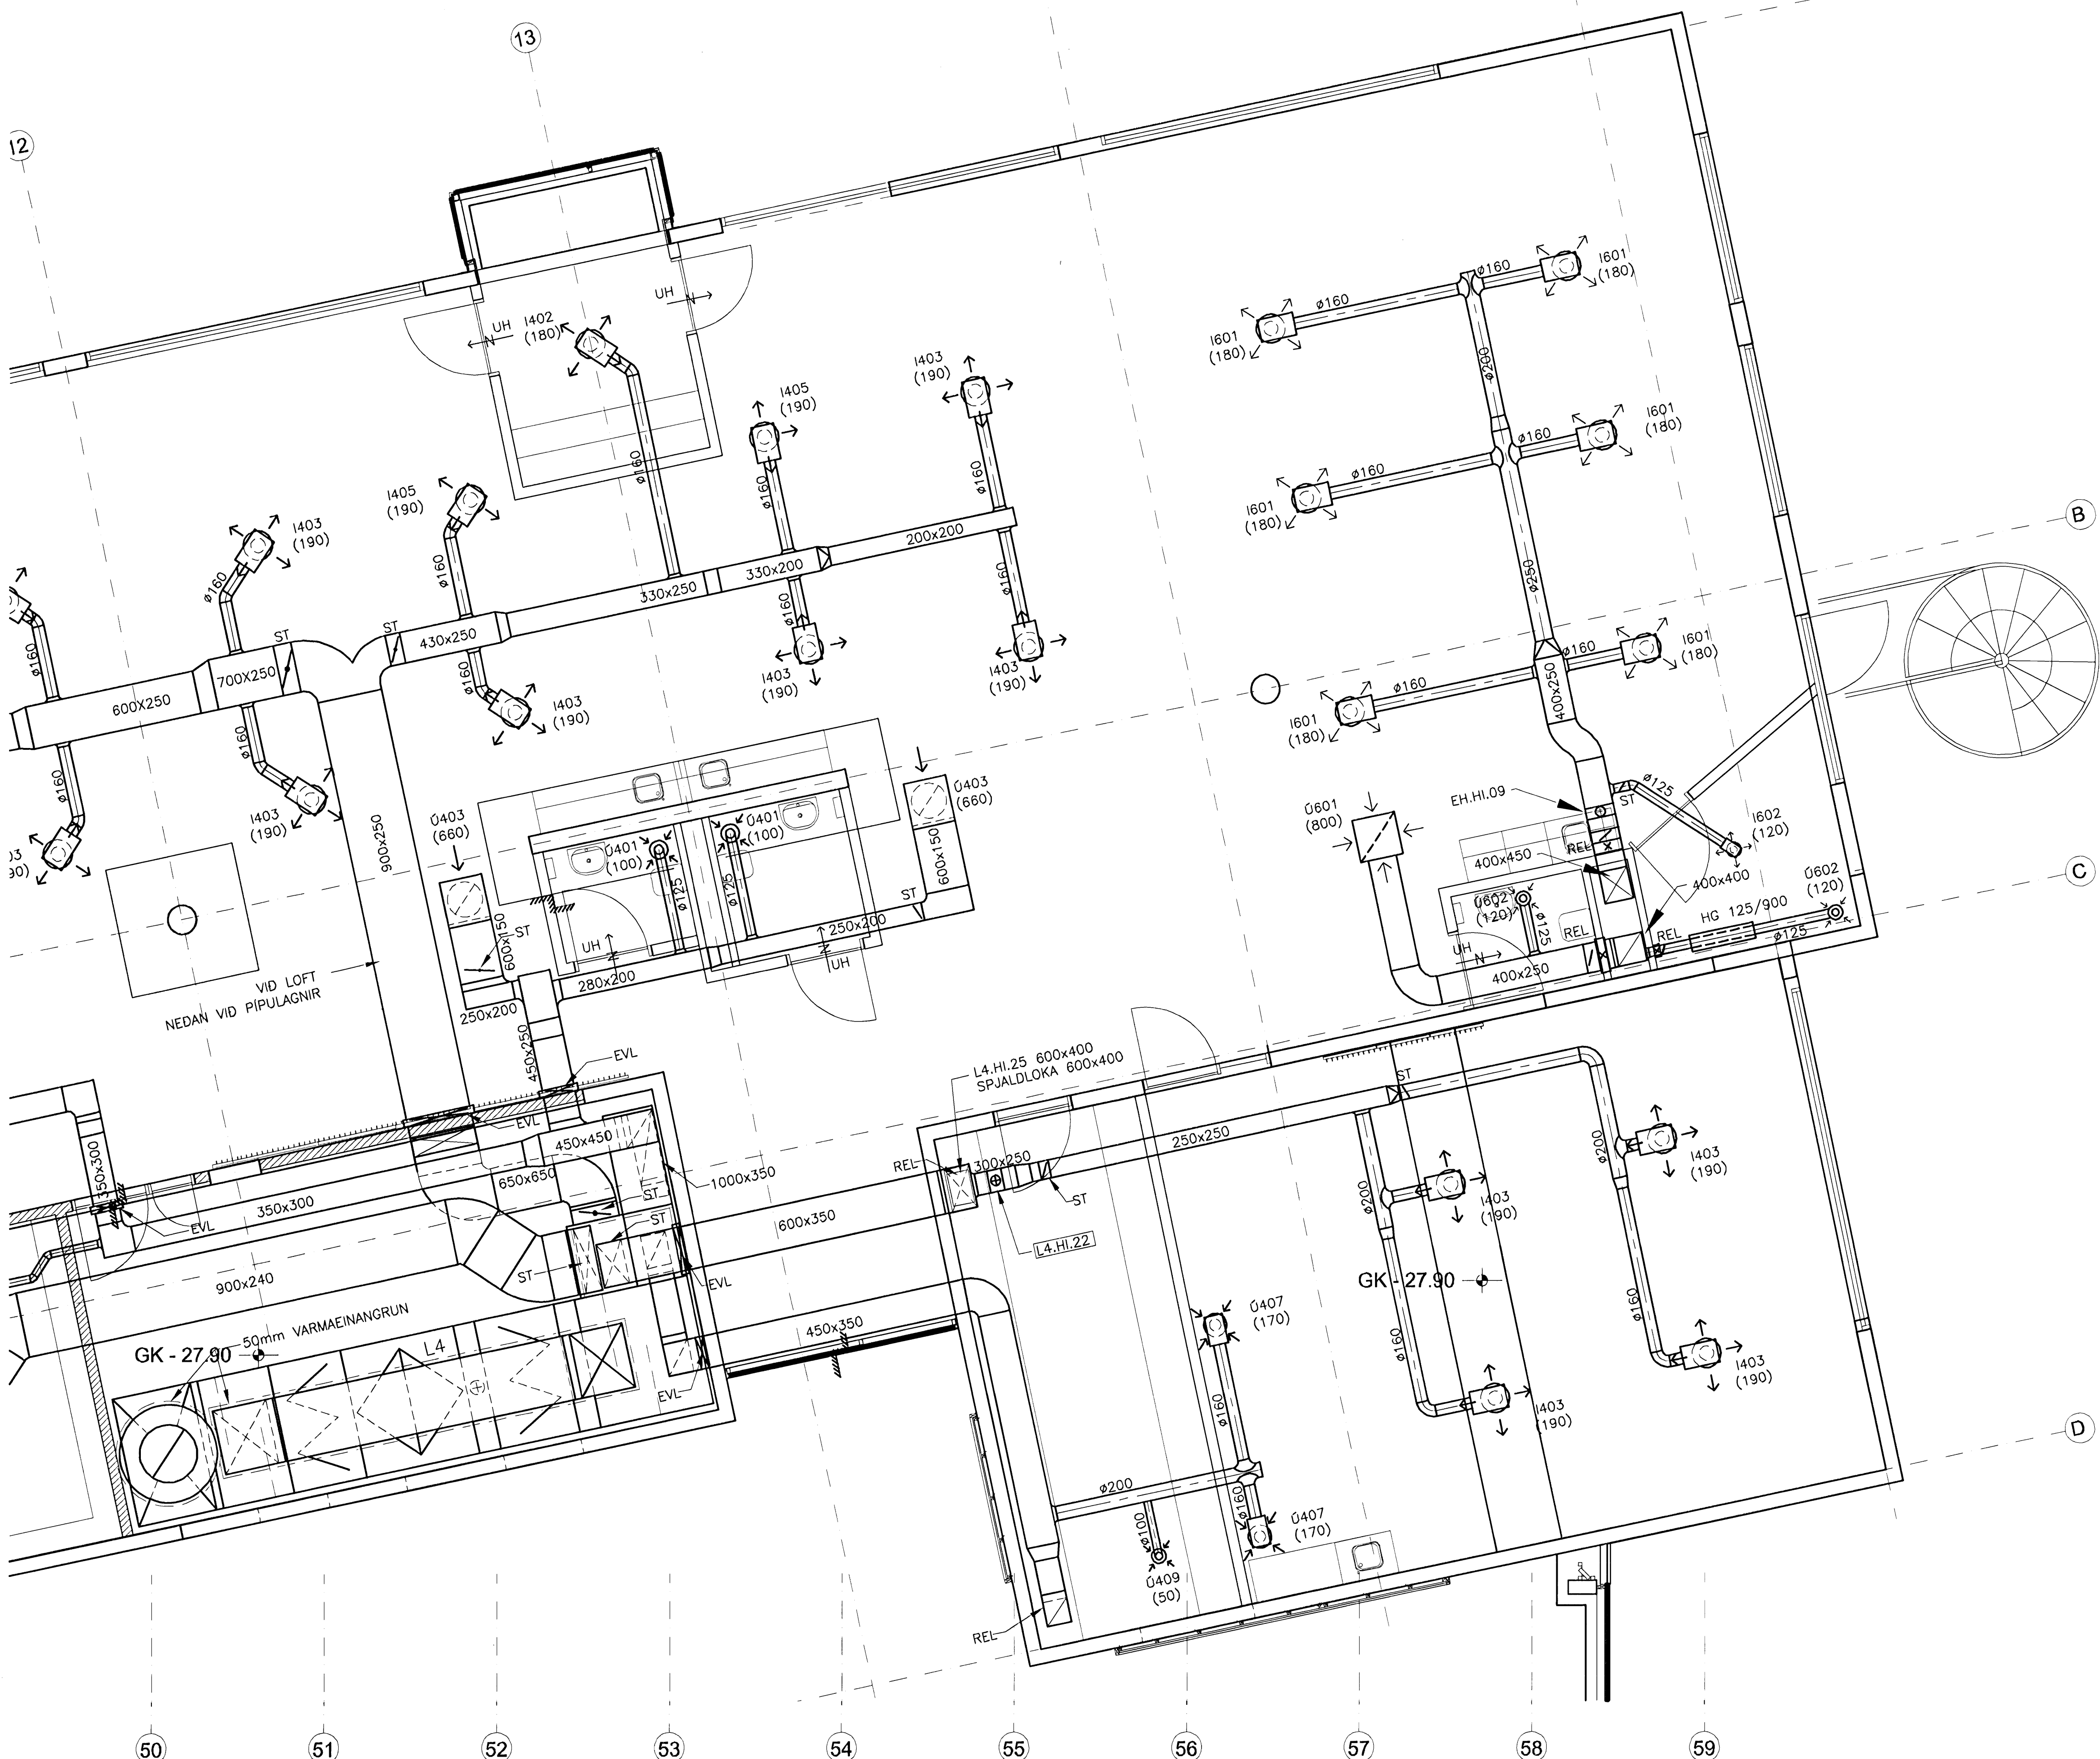

3. HÆÐ. GRUNNMYND
MKV. 1