
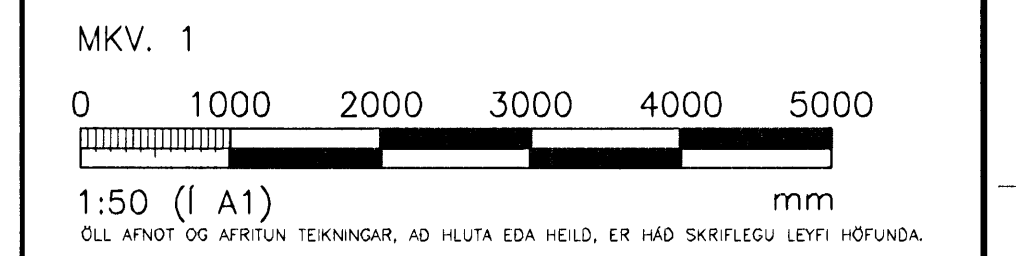


Samþykkt þann
17 FEB 2009
 Byggingdóttir í Hafnarfirði
 P/h. Hrólfur S. Gunnlaugsson

ÓTGAUFERILL

NUMER:	DAGS:	SKRÁNGAR:	HANNAÐ:
B1	12.12.2006	BYGGINGARTEIKNING	BIO
B2	13.10.2007	STOKKUM BREYTT	BIO
B3	07.12.2007	STOKKUM BREYTT V/STURTU OG BÖNINGSKLEFA	BIO
R1	18.07.2008	REYNDARTEIKNING	BIO

DAGS, UNDRISKRIFTFAR: NAFN OG KT. SAMRÆMINGARHÖNNUNÐAR:
 UNDRISKRIFT SAMRÆMINGARHÖNNUNÐAR: *[Signature]*

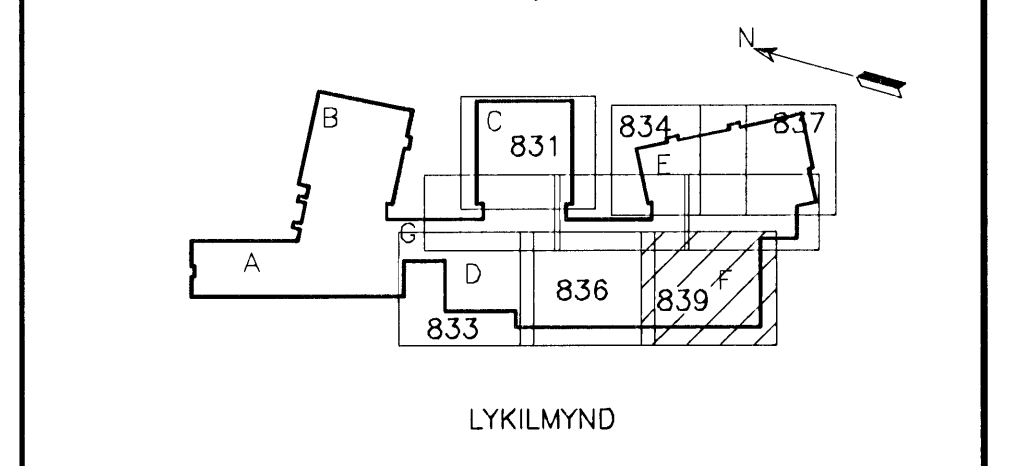

VGK HÖNNUN
 GRENSÁSGVEGI 1 · 108 REYKJAVÍK · Sími: 422 3000 · Fax: 422 3001
 VEFÞANG: www.vgkhonnun.is · NETÞANG: vgkhonnun@vgkhonnun.is

RETTI VERKS:
HRAUNVALLASKÓLI 2. ÁF.
DREKAVELLIR 9, HAFNARFIRÐI

RETTI TEIKNINGAR:
 LOFTRÆSIKERFI:
 2. HÆÐ, GRUNNMYND

MÆLI:	TEIKNAD:	GEYMSLUNGUR:	VNR:
HANNAÐ:	YFRFARÐ:	MKV:	NR. TEIKNINGAR:
DAGS, UNDRISKRIFTFAR:	NAFN OG KT. HÖNNUNÐAR:	430572-0169	L2-839
UNDRISKRIFT HÖNNUNÐAR:	ÓTGAFA:		R1
LÁRUS ÁRSÆLSSON	2008625119		

GRUNNMYND
 MKV. 1