



1. HÆÐ, GRUNNMYND  
MKV. 1



Samþykkt þann  
17 FEB 2009  
Byggingafulltrúinn / Hafnarfréði  
F.h. Hrólfur S. Gunnlaugsson

ÓTGÁFUFRILL

NUMER	DAGS	SKYRNINGAR	HNNAÐ
B1	12.12.2006	BYGGINGARTEIKNING	BIO
B2	04.02.2008	ÝMSAR BREYTINGAR	BIO
R1	18.07.2008	REYNDARTEIKNING	BIO

DAGS. UNDRISKRIFTAR:      NAFN OG KT. SAMRÆMINGARHÖNNUNAR:

UNDRISKRIFT SAMRÆMINGARHÖNNUNAR: *[Signature]*

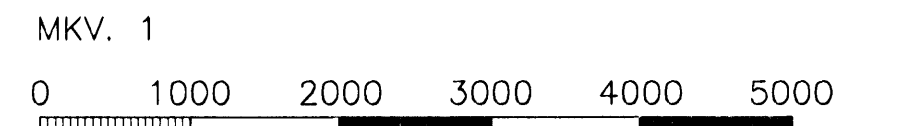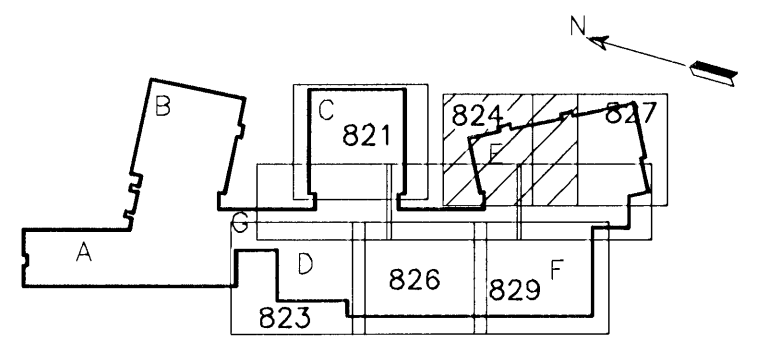

**VGK HÖNNUN**  
GRENSÁSVEGI 1 · 108 REYKJAVÍK · Sími: 422 3000 · Fax: 422 3001  
VEFFANG: www.vgkhonnun.is · NETFANG: vgkhonnun@vgkhonnun.is

HÉTTI VERKS:  
**HRAUNVALLASKÓLI 2. ÁF.**  
DREKAVELLIR 9, HAFNARFIRÐI

HÉTTI TEIKNINGAR:  
LOFTRÁSÍKERFI:  
1. HÆÐ, GRUNNMYND

MILT	TEIKNAD.	ÁDH	DEYMSLUNUMER	UNR
HNNAÐ:	BIO	JGG	MKV: 1:50	NR. TEIKNINGAR: 3.151.218
DAGS. UNDRISKRIFTAR:	NAFN OG KT. HÖNNUNAR:			
31.12.2008	VGK-HÖNNUN hf		430572-0169	<b>L2-824</b>
UNDRISKRIFT HÖNNUNAR:	ÓTGÁFA:			R1
LÁRUS ÁRSÆLSSON	2008021119			