

9 STÆÐI
Útstæði
undir garði


0003 halli ca.3,5%
Gólfhurðill

HURÐ
ÚT

BÍLAGEMYSLA
21 STÆÐI
HÖLF B
522,4 m²

HREYFI
B88

11.93 %
RAMPI

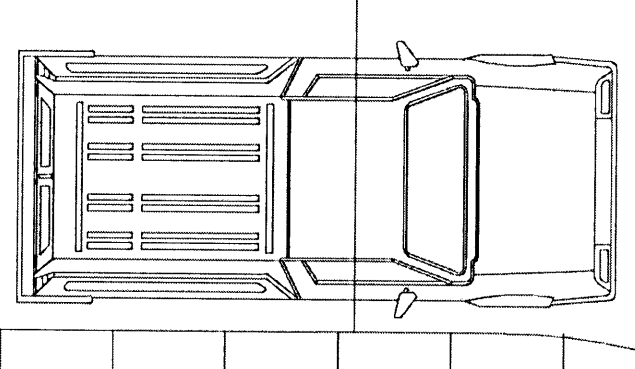


5.65
5.58



LL

UU

DD

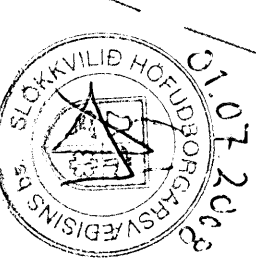

BRÉTTI : 15.05.2006
BRÉTTI : 07.07.2006
BRÉTTI : 19.05.2008
BRÉTTI : 19.05.2008