


ÚTGÁFUERILL

NR:	DAGS:	SKRIFINGAR:	HANNAÐ:
B1	10.10.2006	BYGGINGARTEIKNING	PB
B2	30.07.2007	BRUNASLÖNGU BÉTT INN	PB
R1	30.08.2008	REYNDARTEIKNING	PB

DAGS. UNDRISKRIFAR: *[Signature]*  
UNDRISKRIF SAMRÉMINGARHÖNDUÐAR: *[Signature]*

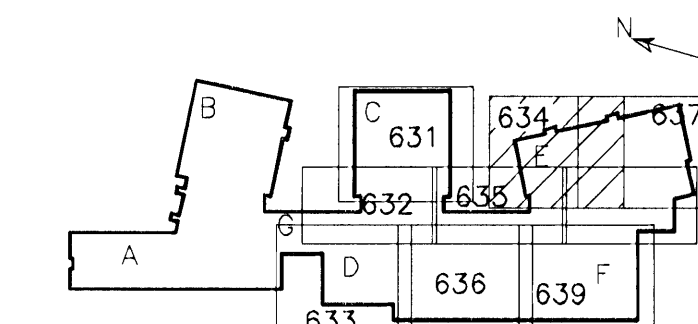


LYKILMYND



ALMENNAR SKÝRINGAR SJÁ TEIKN. P2-601

MKV. 1

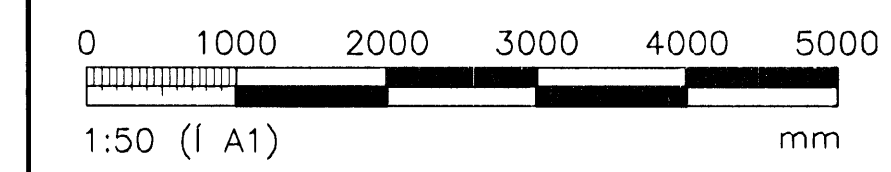

ÖLL AFNOT OG AFRITUN TEIKNINGAR, AD HLUTA EDA HEILD, ER HAD SKRIFLEGU LEYFI HÖFUNDA.



GRENSÁSVEDI 1 - 108 REYKJAVÍK - Sími: 422 3000 - Fax: 422 3001  
VEFFANG: www.vgghannun.is - NETFANG: vgghannun@vgghannun.is

HEITI VERKS:  
**HRAUNVALLASKÓLI 2. ÁF.**  
DREKAPELLIR 9, HAFNARFIRDI

HEITI TEIKNINGAR:  
VATNSÓÐAKERFI:  
2. HÆÐ, GRUNNMYND

MÆLI:	TEIKNAD:	GEYMSLUNUMER:	VNR:
HANNAÐ:	YFIRFARÐ:	MKV:	NR TEIKNINGAR:
DAGS. UNDRISKRIFAR:	NAFN OG KT. HÖNDUÐAR:	<b>P2-634</b>	
UNDRISKRIF HÖNDUÐAR:	ÚTGÁFA:	R1	

GRUNNMYND  
MKV. 1