



Fallþrpa C1 og C2

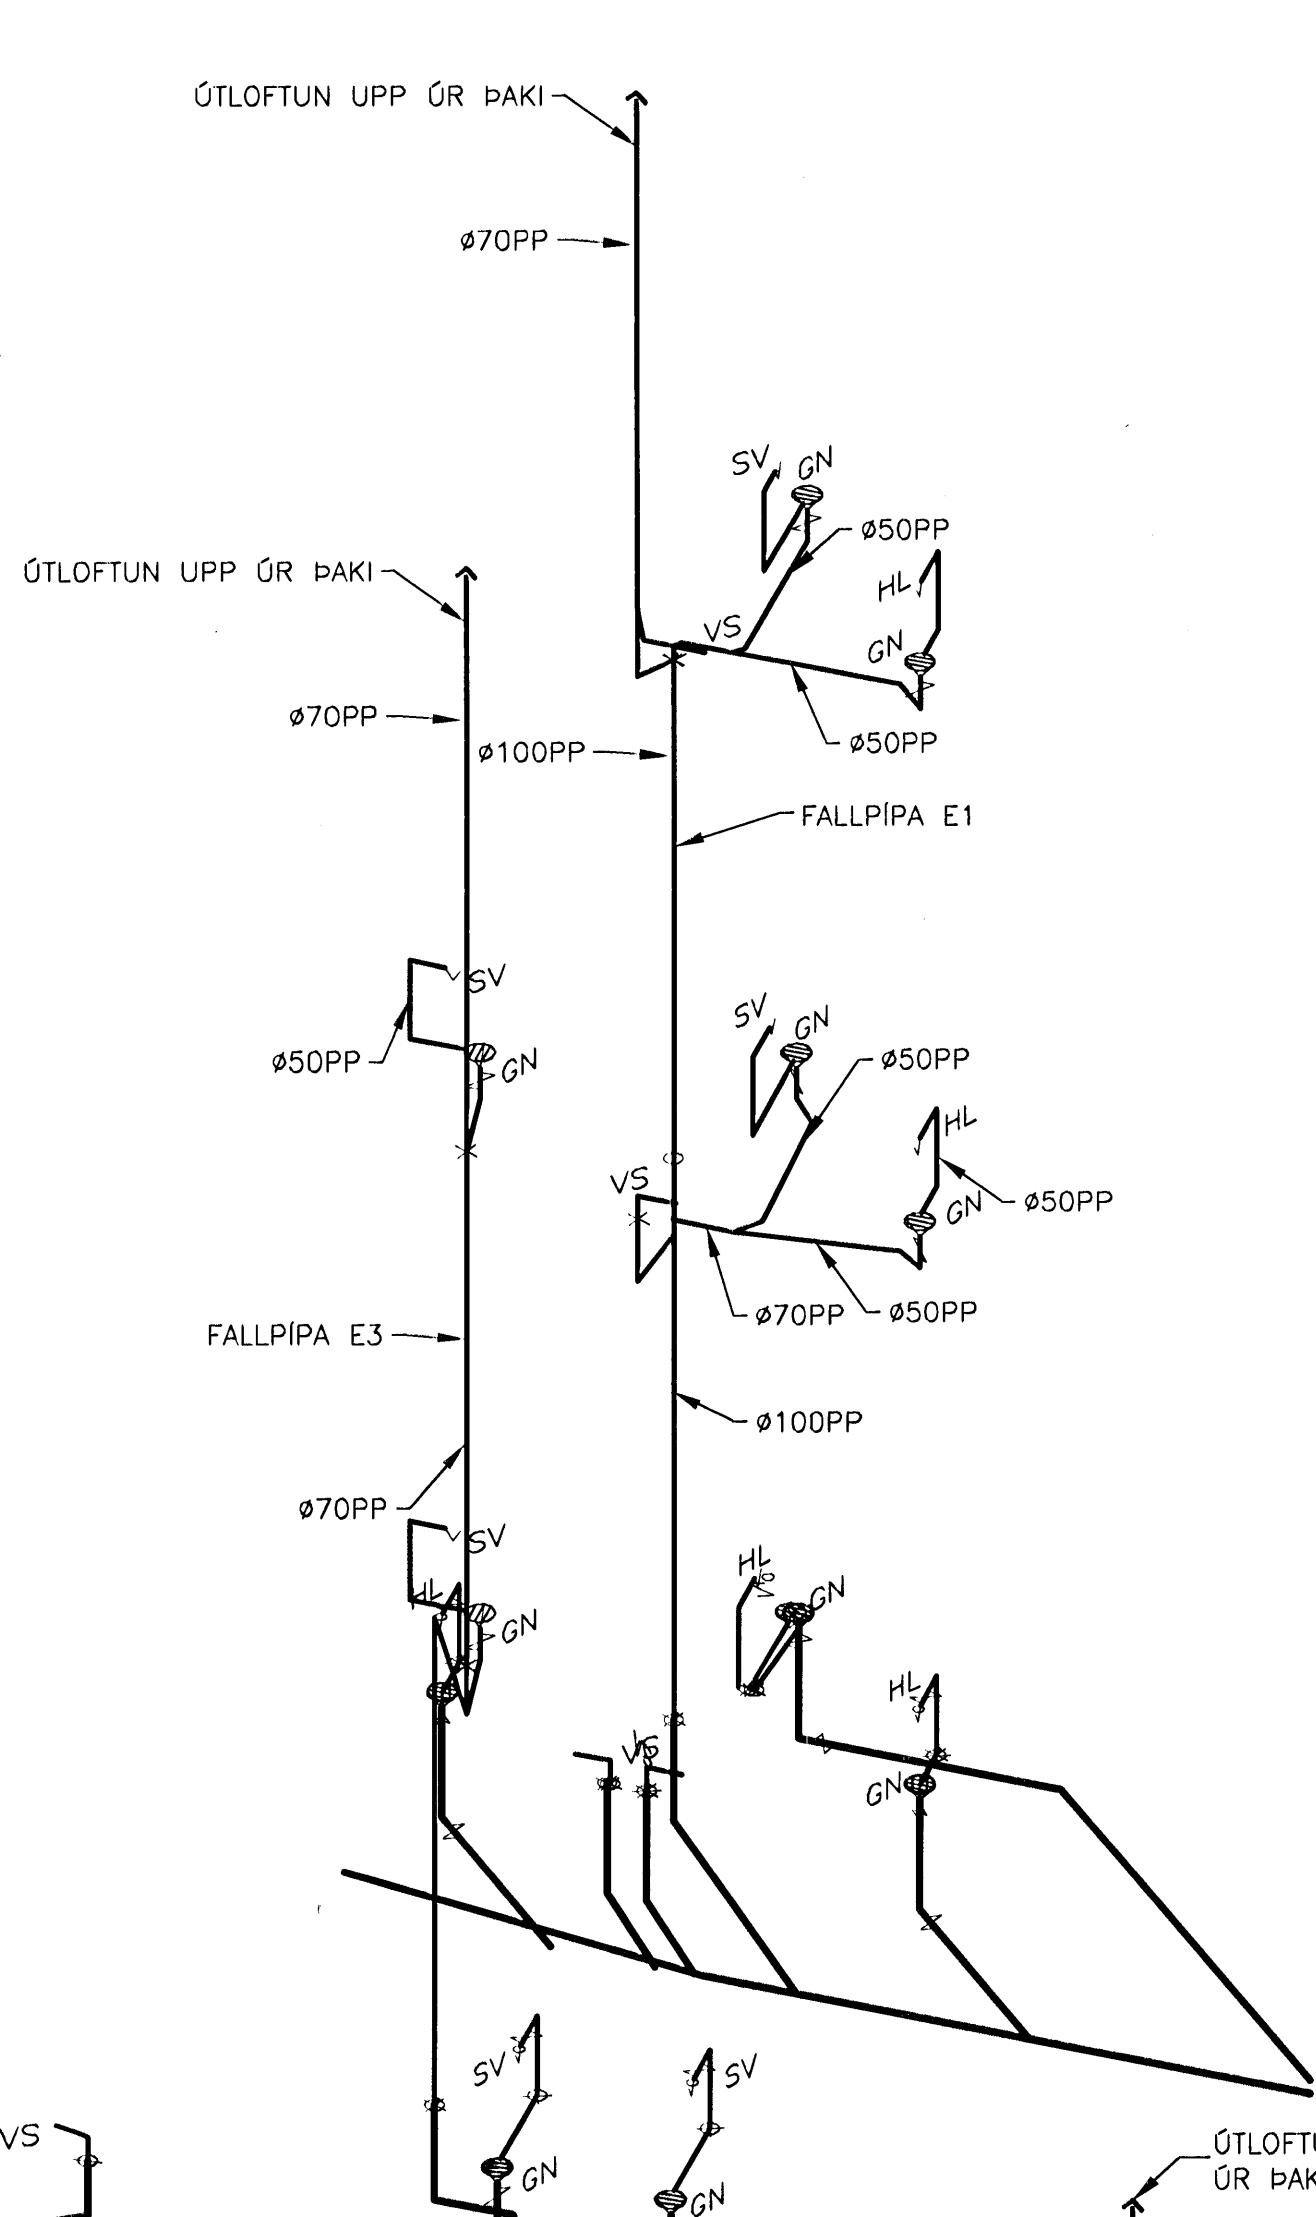


Fallþrpa E1 OG E3

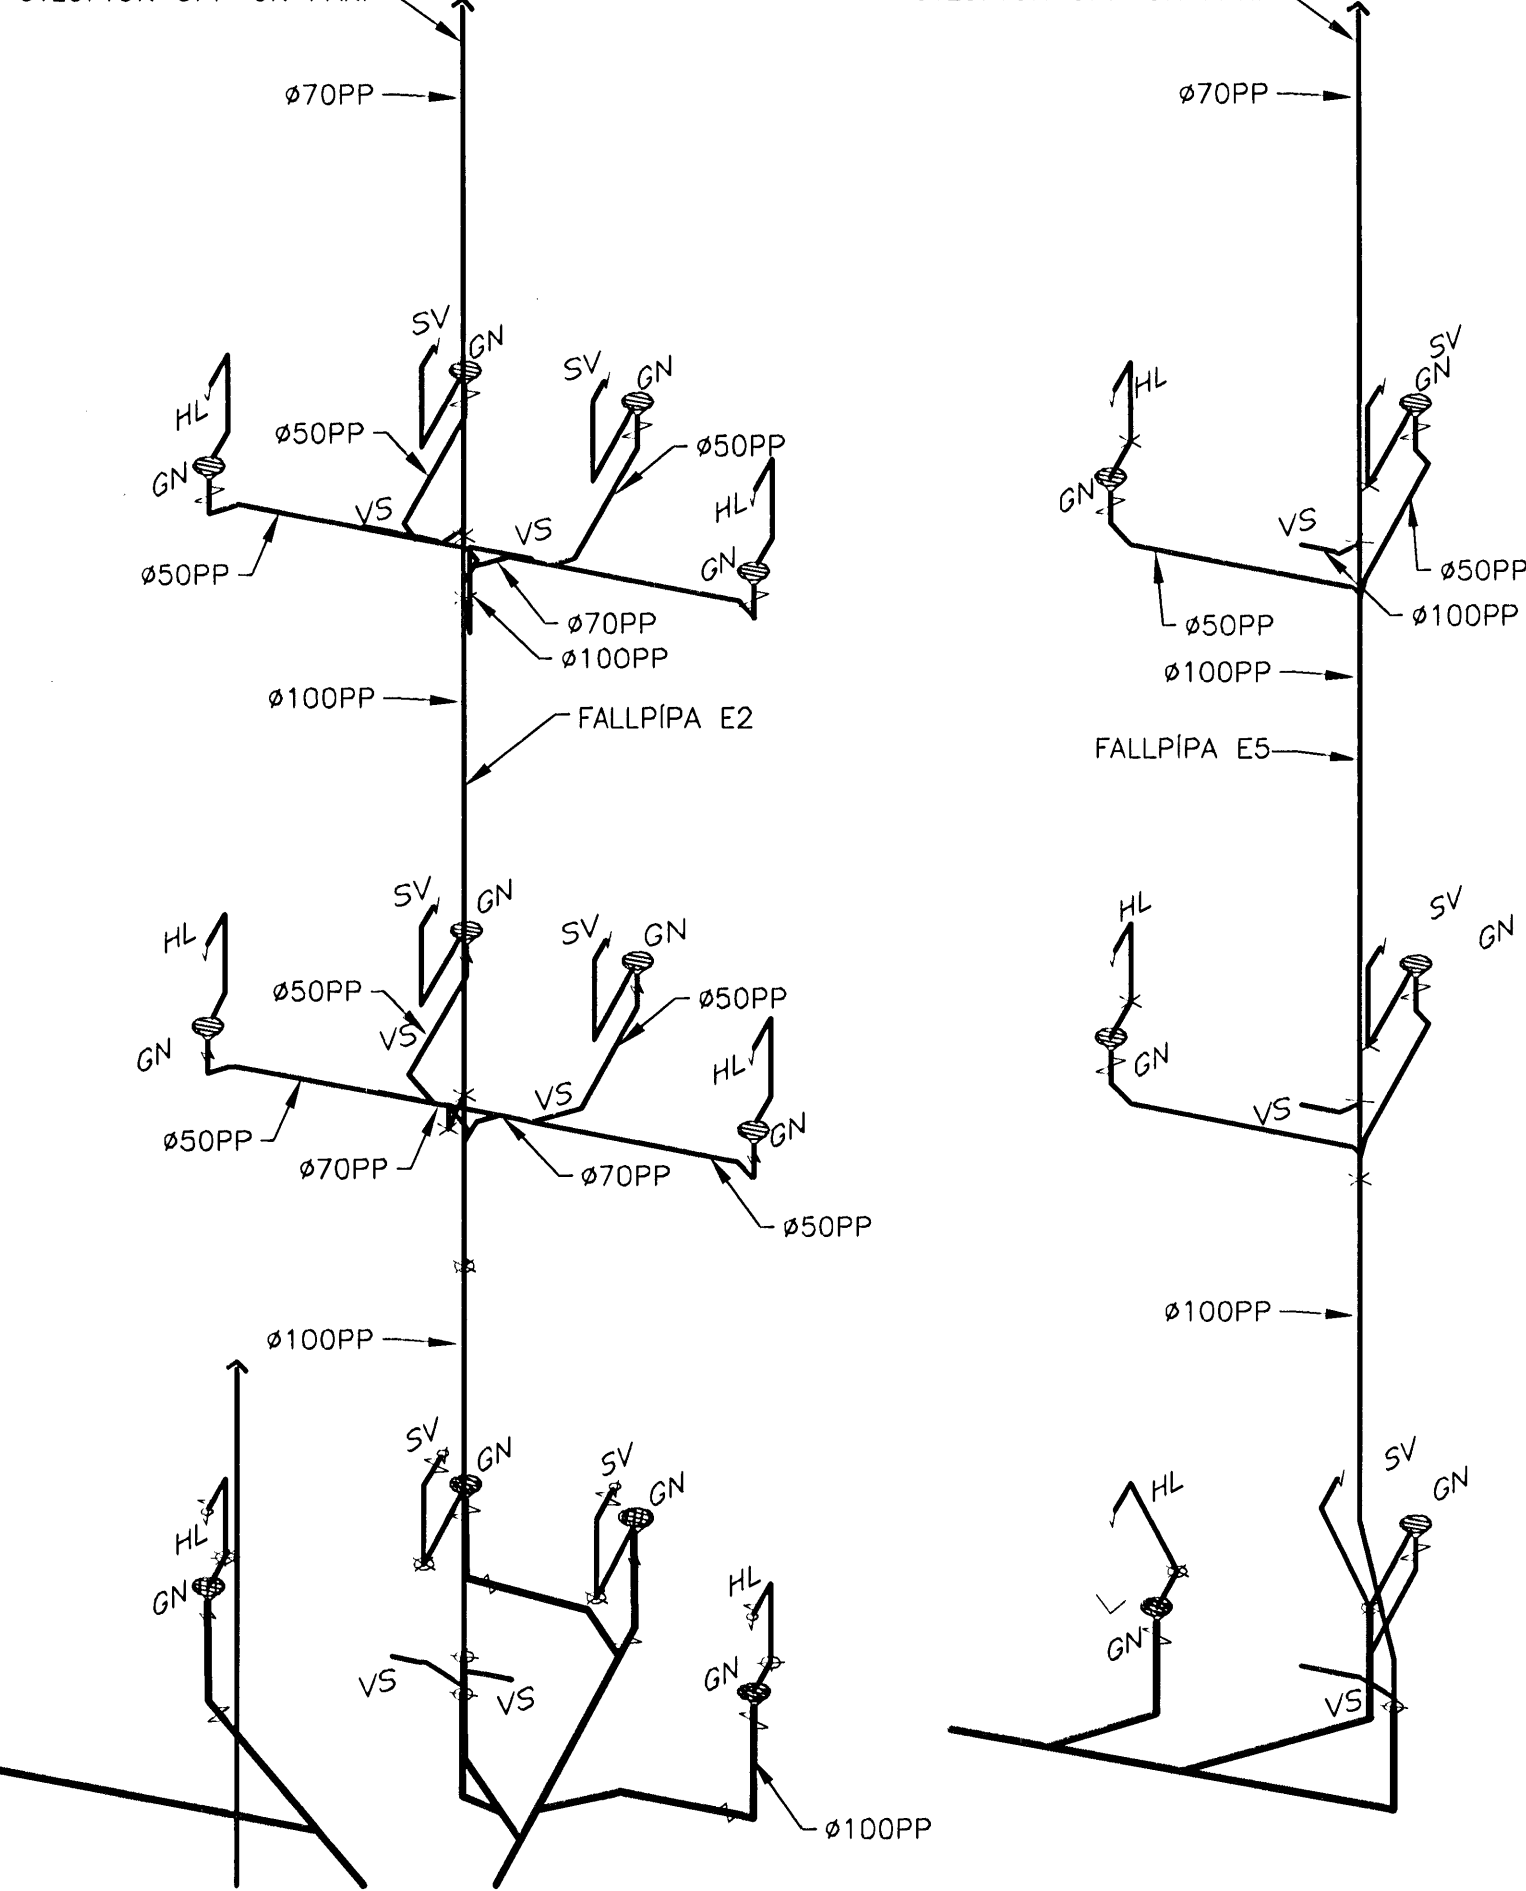


Fallþrpa E2

Fallþrpa E5

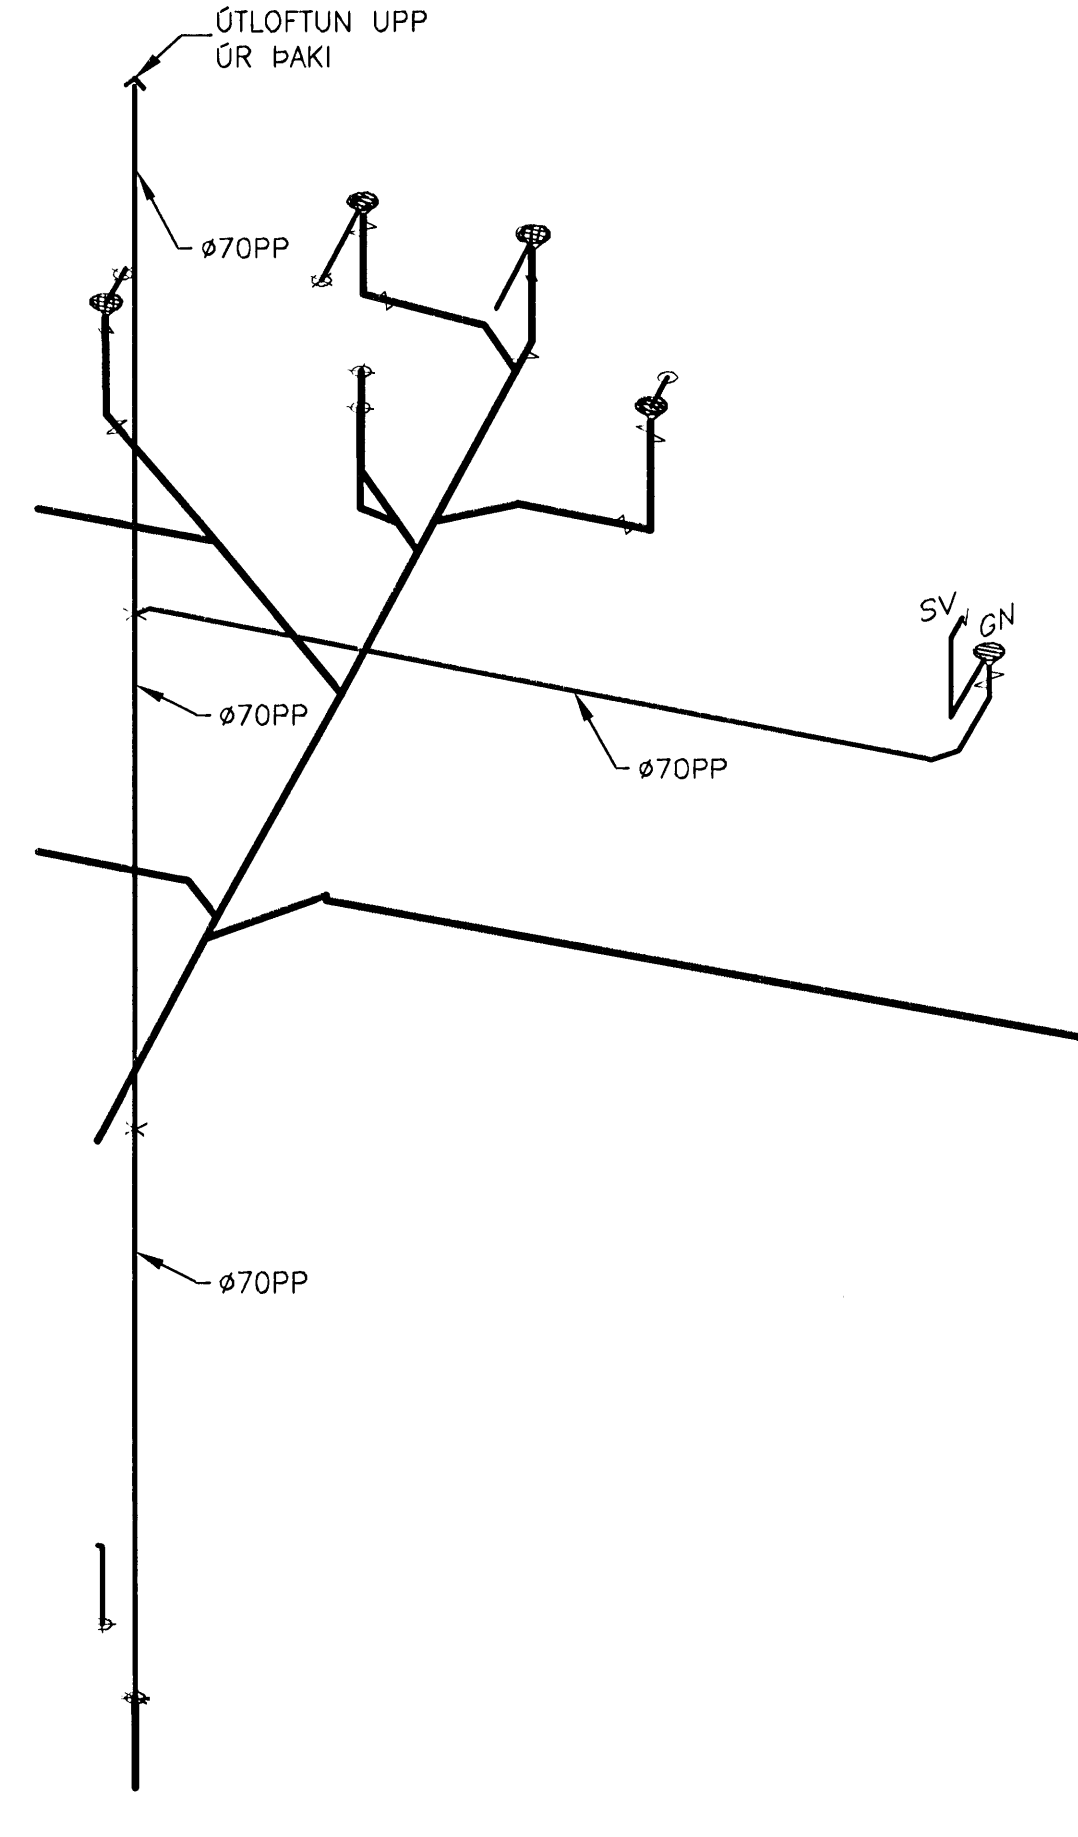


Fallþrpa E4

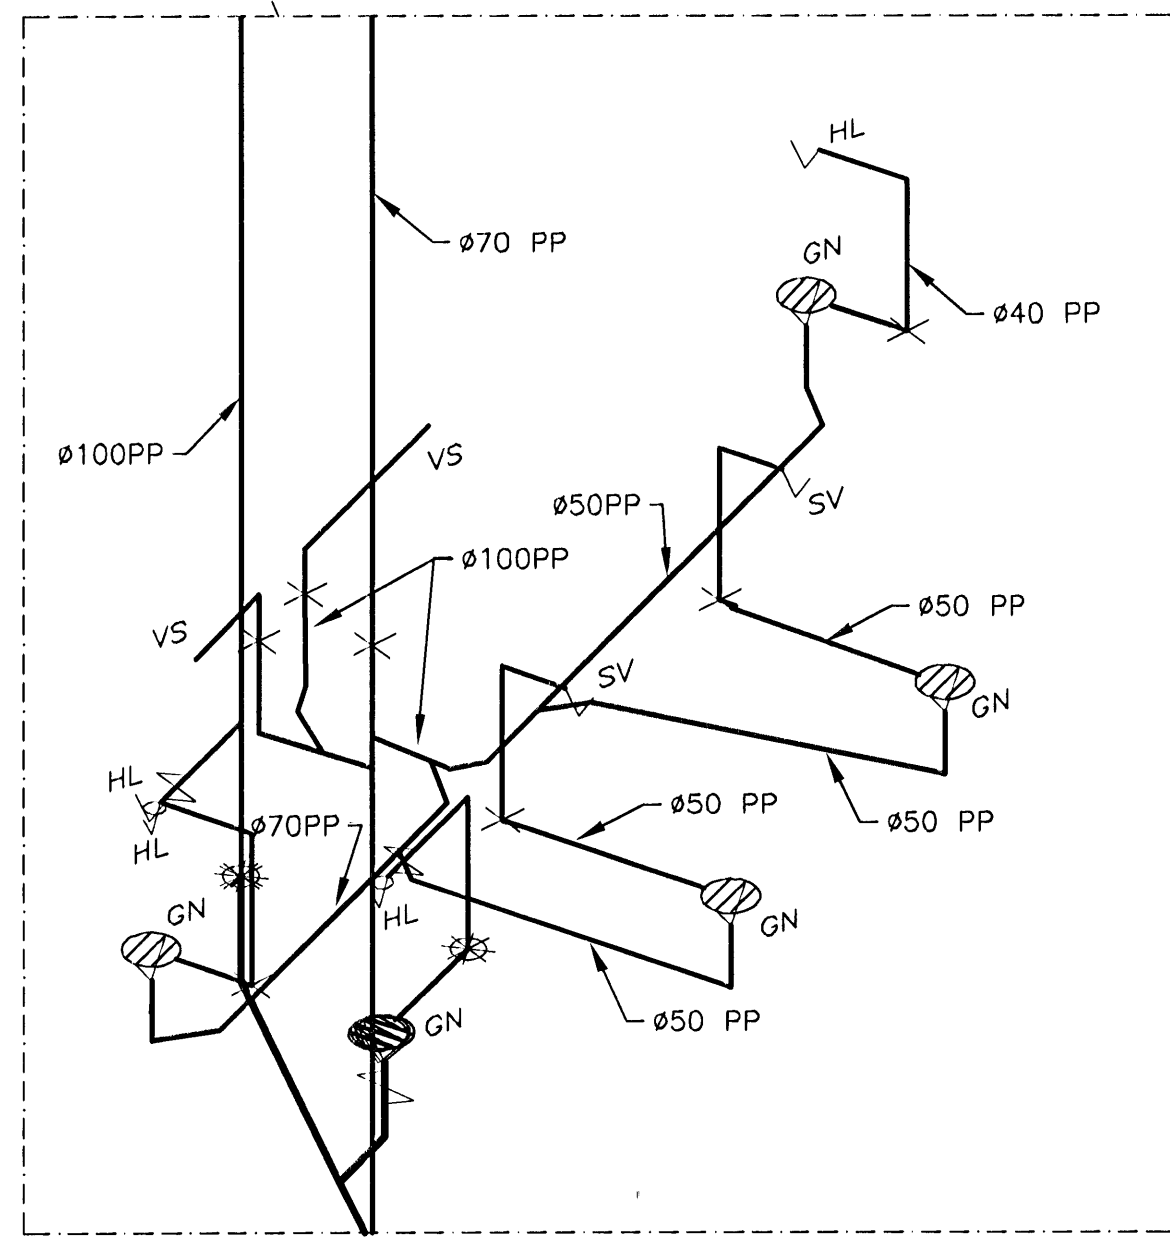

Fallþrpa F1

Fallþrpa F2

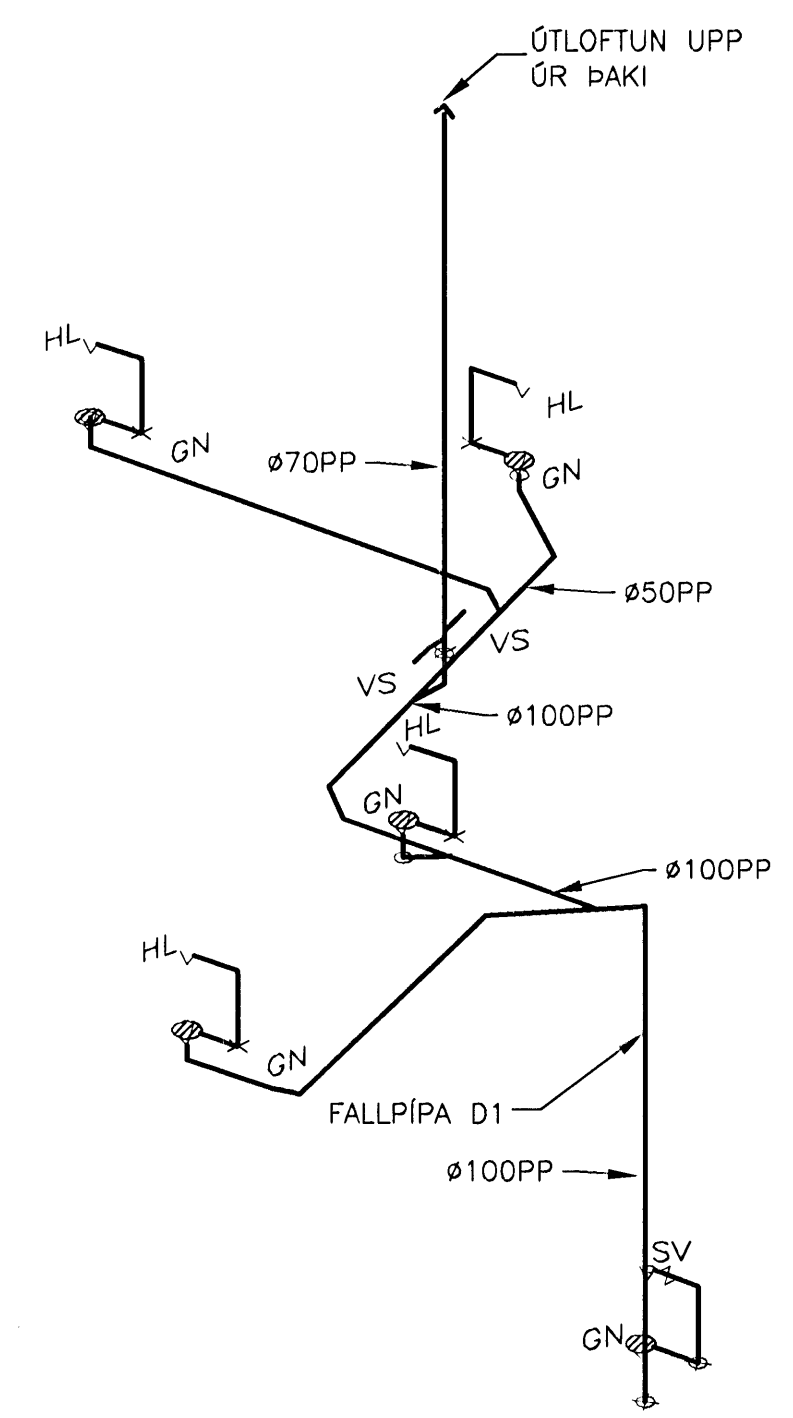

Fallþrpa D1

TENGIMYND
MKV. 1.


Samþykkt þann
25 MAR 2009
Byggingafrúnn (Hafnarfrú)
F.h. Hrólfur S. Gunnlaugsson

ÚTGÁFUFERILL

NÖMUR	DAGS	SKÝRINGAR	HANNAÐ
B1	10.10.2006	BYGGINGARTEIKNING	PB
B2	18.02.2008	FALLPIPA E5, FMSAR LAGFERINGAR	PB
R1	30.08.2008	REYNDARTEIKNING	PB

DAGS. UNDRISKRIFAR: NAFN OG KT. SAMREINGARHÖNNUNAR
UNDRISKRIF SAMREINGARHÖNNUNAR:

ALMENNAR SKÝRINGAR SJÁ TEIKN. P2-201

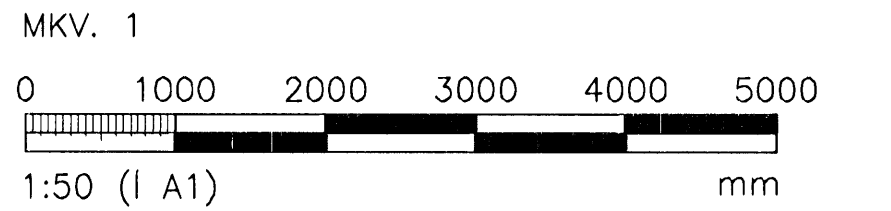

ÖLL AFNOT OG AFRITUN TEIKNINGAR, AD HLUTA EDA HEILD, ER HÁÐ SKRIFLEGU LEYFI HÖFNUNAR.

VGK HÖNNUN
GRENÁSVEGI 1 · 108 REYKJAVÍK · Sími: 422 3000 · Fax: 422 3001
VEFFANG: www.vgkhonnun.is · NETFANG: vgkhonnun@vgkhonnun.is

HEITI VERKS:
HRAUNVALLASKÓLI 2. ÁF.
DREKAVELLIR 9, HAFNARFIRDI

HEITI TEIKNINGAR:
FRÁVEITULÖGN:
TENGMIMYND

MILT:	TEIKNAD:	GEYMSLUNGNER	VNR:
	LS		3.151.218
THANNAÐ:	YFRIFARÐ:	MKV:	NR. TEIKNINGAR:
PB		1:50	P2-251
DAGS. UNDRISKRIFAR:	NAFNI OG KT. HÖNNUNAR:	ÚTGÁFA:	
31.12.2008	LÁRUS ÁRS/ELSSON	R1	