


Samþykkt bann
26 MAR 2009
 Byggingafulltrúinn í Hafnarfirði
 E.h. Hrólfur S. Gunnlaugsson


ÓTGÁFUFRILL

NÚMÉR:	DAGS:	SKRINGAR:	HAUNAD:
B1	10.10.2008	BYGGINGARTEIKNING	PB
B2	29.02.2008	SPÜLSLÖNGUR	PB
R1	30.08.2008	REYNDARTEIKNING	PB

DAGS, UNDIRSKRIFTAR: NAFN OG KT. SAMRÆMINGARHÖNNUÐAR: *[Signature]*
 UNDIRSKRIFT SAMRÆMINGARHÖNNUÐAR: *[Signature]*

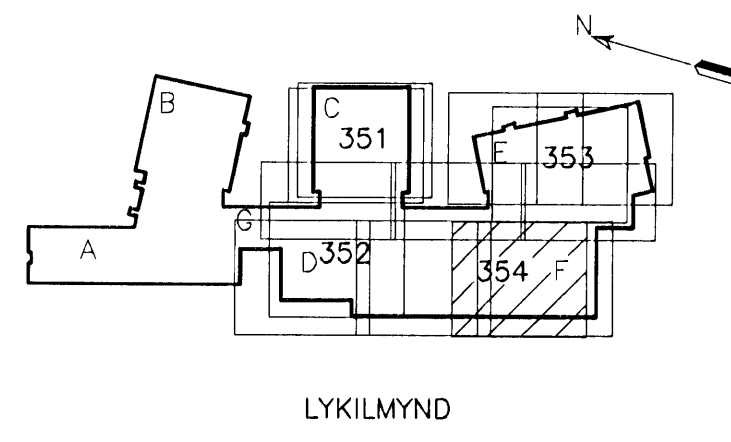

ALMENNAR SKÝRINGAR SJÁ TEIKN. P2-361.

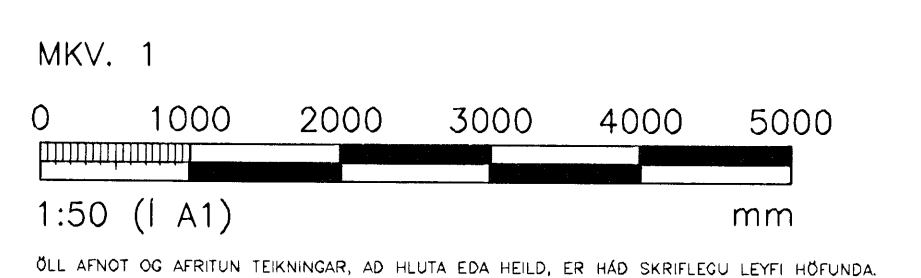

VGK HÖNNUN
 GRENASÁVEGI 1 · 108 REYKJAVÍK · Sími: 422 3000 · Fax: 422 3001
 VEFFANG: www.vgkhonnun.is · NETFANG: vgkhonnun@vgkhonnun.is

HRAUNVALLASKÓLI 2. AF.
DREKAVELLIR 9, HAFNARFIRÐI

HEITI TEIKNINGAR:
VATNSLÖGN:
 TENGIMYND

MÁLT:	TEKNAÐ:	GEYMSLUNUMER:	VNR:
HAUNAD:	YRIFARÐ:	MKV:	NR. TEIKNINGAR:
DAGS, UNDIRSKRIFTAR:	NAFN OG KT. HÖNNUÐAR:	P2-354	
UNDIRSKRIFT HÖNNUÐAR:	ÓTGÁFA:	R1	

TENGIMYND
 MKV. 1.