
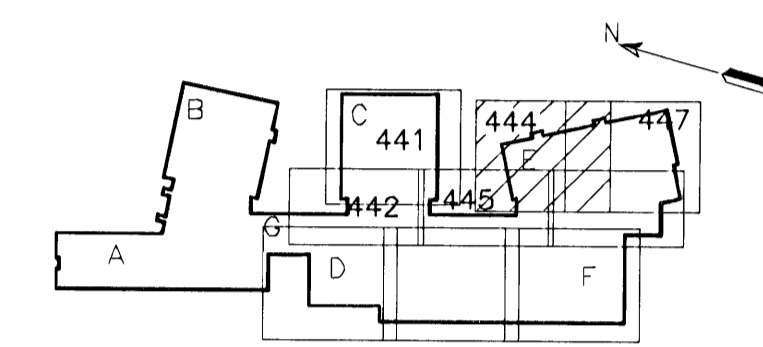



ÚTGÁFUERILL

| NÚMÉR | DAGS | SKRIFINGAR | HANNAÐ |
|-------|------------|-------------------|--------|
| B1 | 10.10.2006 | BYGGINGARTEIKNING | PB |
| B2 | 18.02.2008 | NÆR GRUNNUR | PB |
| R1 | 30.08.2008 | REYNDARTEIKNING | PB |

DAGS. UNDRISKRIFTAR: NAFN OG KT. SAMREYNDINGARHÖNNUNAR: 
 UNDRISKRIFT SAMREYNDINGARHÖNNUNAR:




LYKILMYND

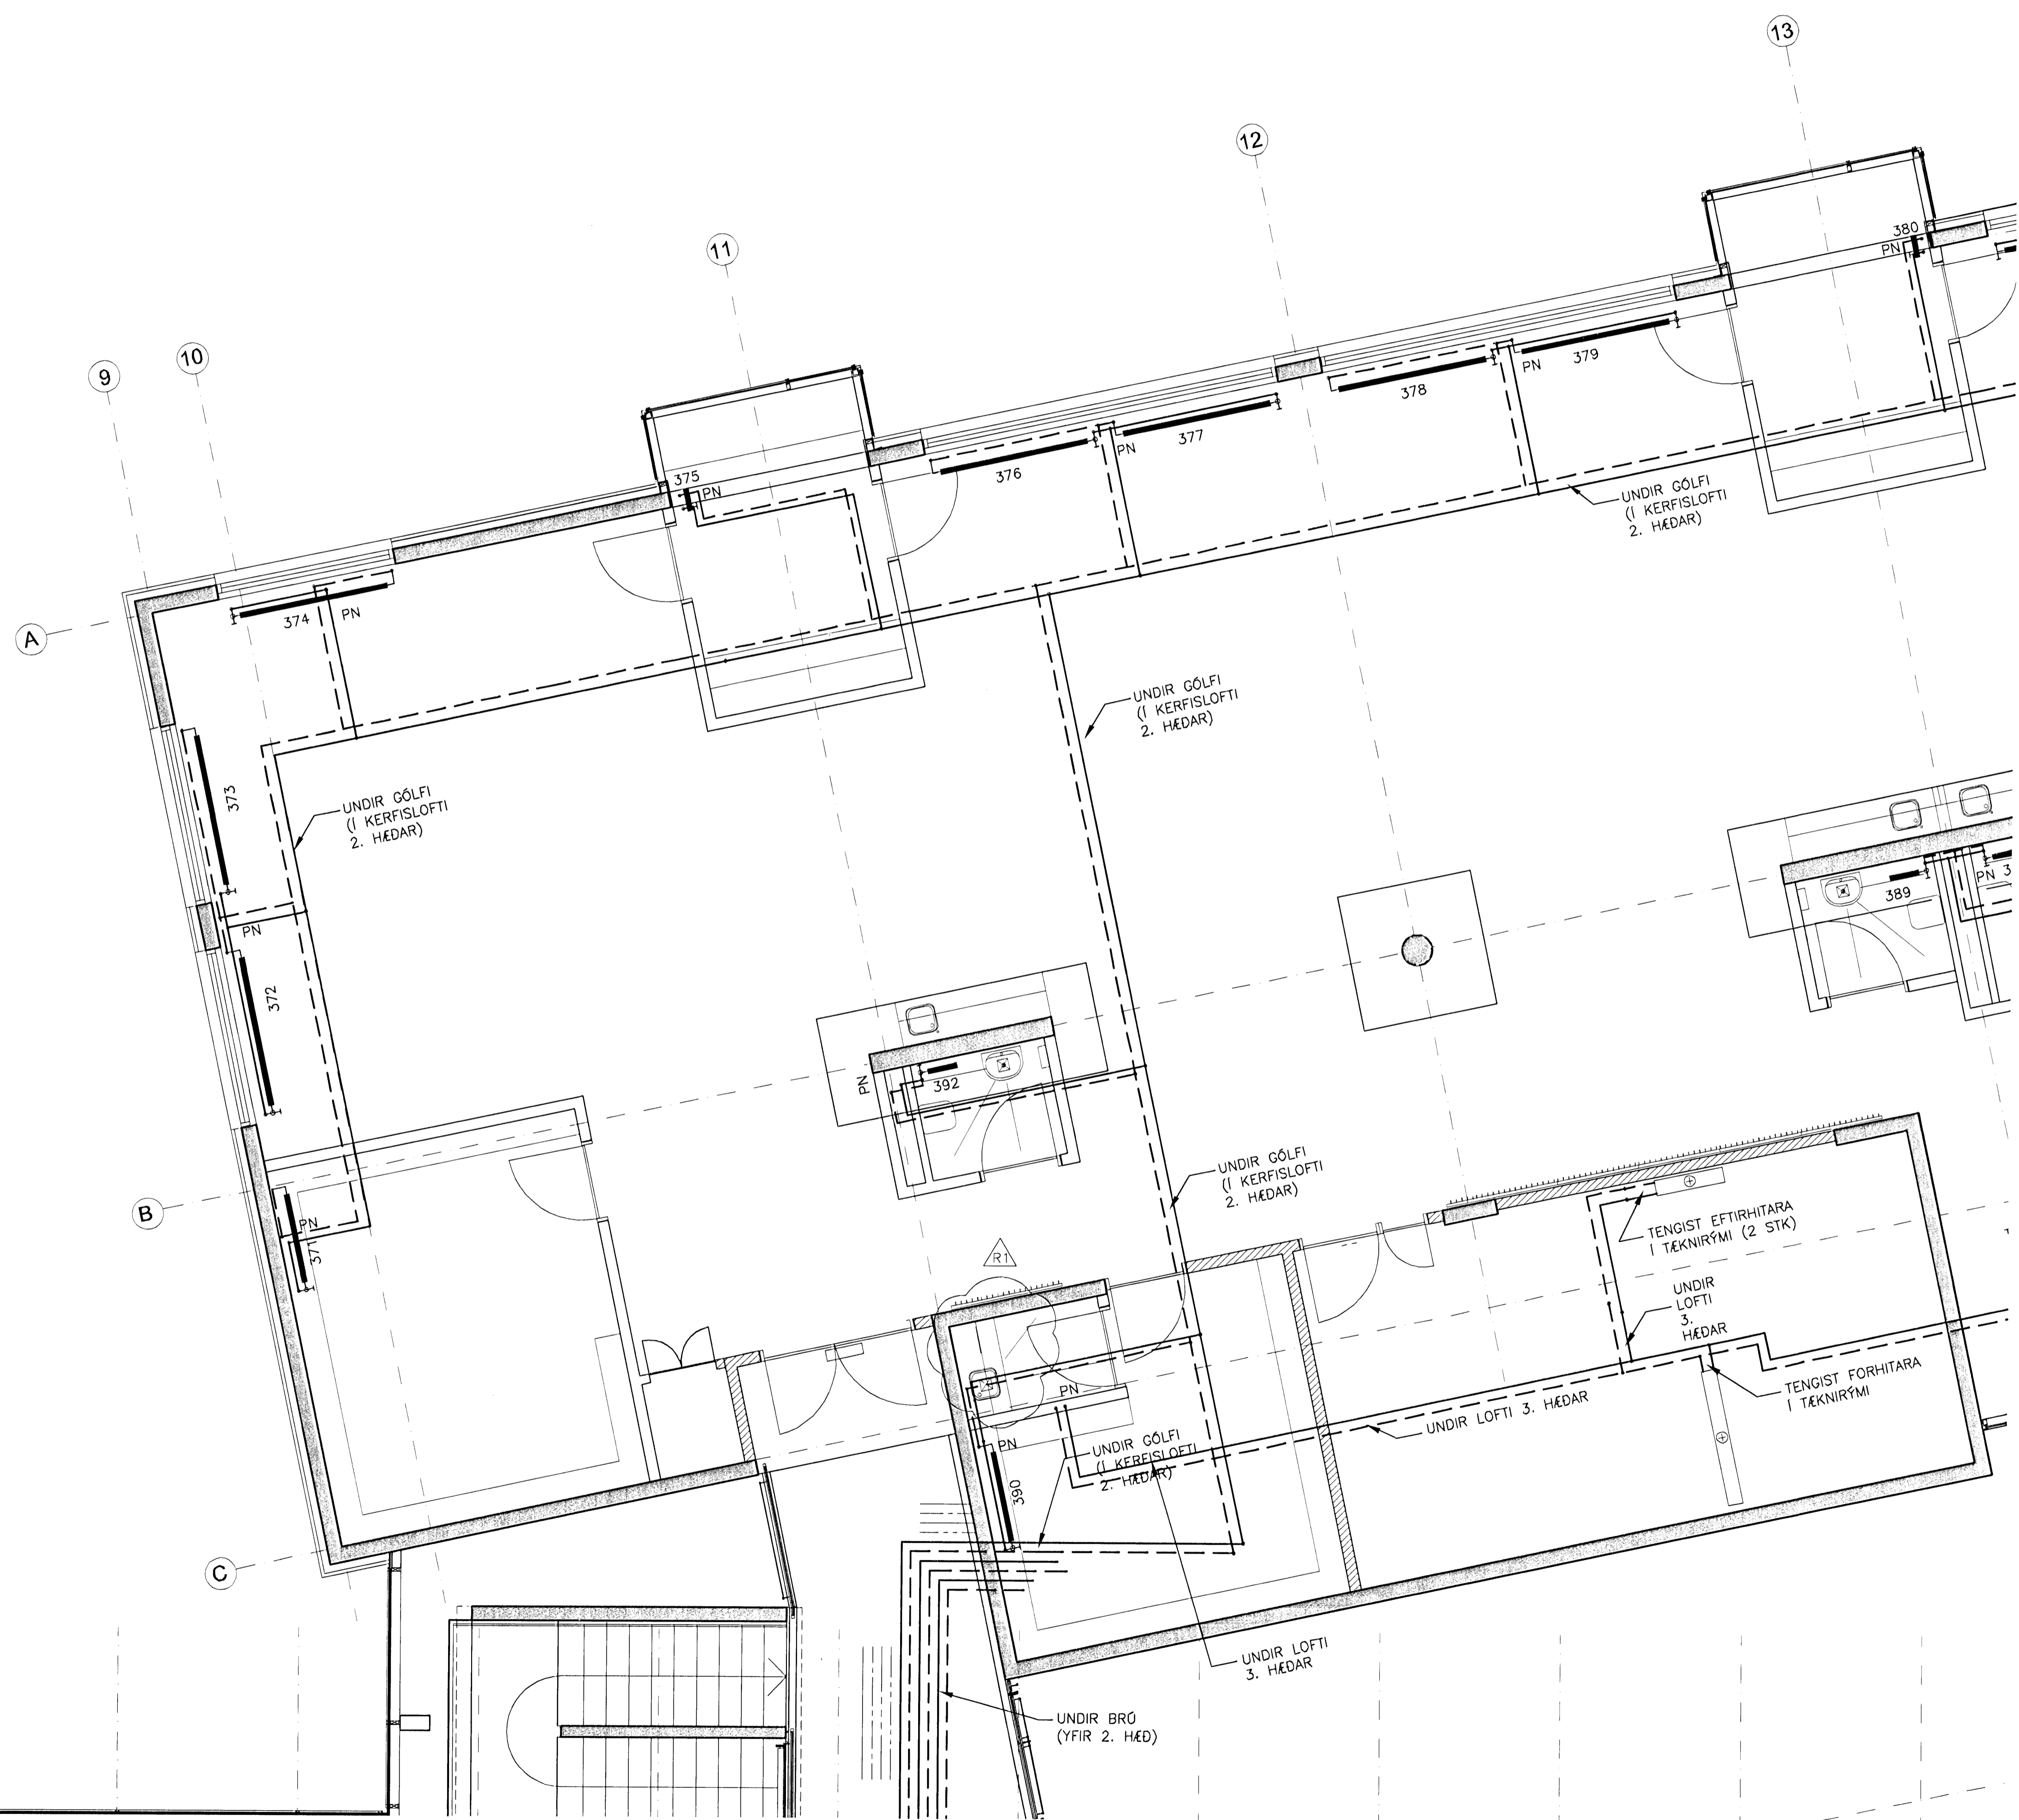

GRUNNMYND
 MKV. 1

ALMENNAR SKÝRINGAR SJÁ TEIKN. P2-461

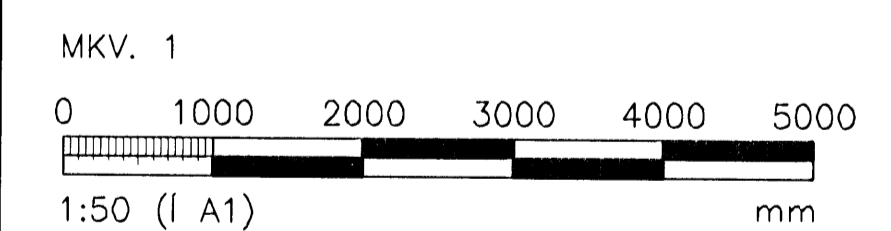

ÖLL AFNOT OG AFRITUN TEIKNINGAR, AD HLUFTA EDA HEILD, ER HÁÐ SKRIFLEGU LEYTI HÖFUNDA.



GRENSÁSVEGI 1 - 108 REYKJAVÍK - Sími: 422 3000 - Fax: 422 3001
 VEFANG: www.vgkhonnun.is - NETFANG: vgkhonnun@vgkhonnun.is

HRAUNVALLASKÓLI 2. ÁF.
 DREKAVELLIR 9, HAFNARFIRÐI

HITAKERFI
 3. HÆÐ, GRUNNMYND

| | | | | |
|-----------------------|----------------------------|---------------|---------------|-----------------|
| MELI: | TEIKNAR: | LS | GEYMSLUNOBER: | VNR: |
| HANNAÐ: | YFIRFARÐ: | MKV: | 1:50 | NR. TEIKNINGAR: |
| DAGS. UNDRISKRIFTAR: | NAFN OG KT. HÖNNUNAR: | P2-444 | | |
| UNDRISKRIFT HÖNNUNAR: | LÁRUS ÁRSÆLSSON 2008625119 | ÚTGÁFA: | R1 | |