
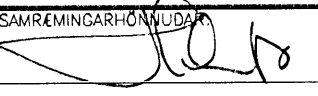


ÓTGÁFUFRILL

NÚMÉR	DAGS	SKRIFINGAR	HAUNAD
B1	10.10.2008	BYGGINGARTEIKNING	PB
R1	30.08.2008	REYNDARTEIKNING	PB

DAGS. UNDRSKRIFTAR: NAFN OG KT. SAMRÆMINGARHÖNNUNAR: 
 UNDRSKRIFT SAMRÆMINGARHÖNNUNAR:

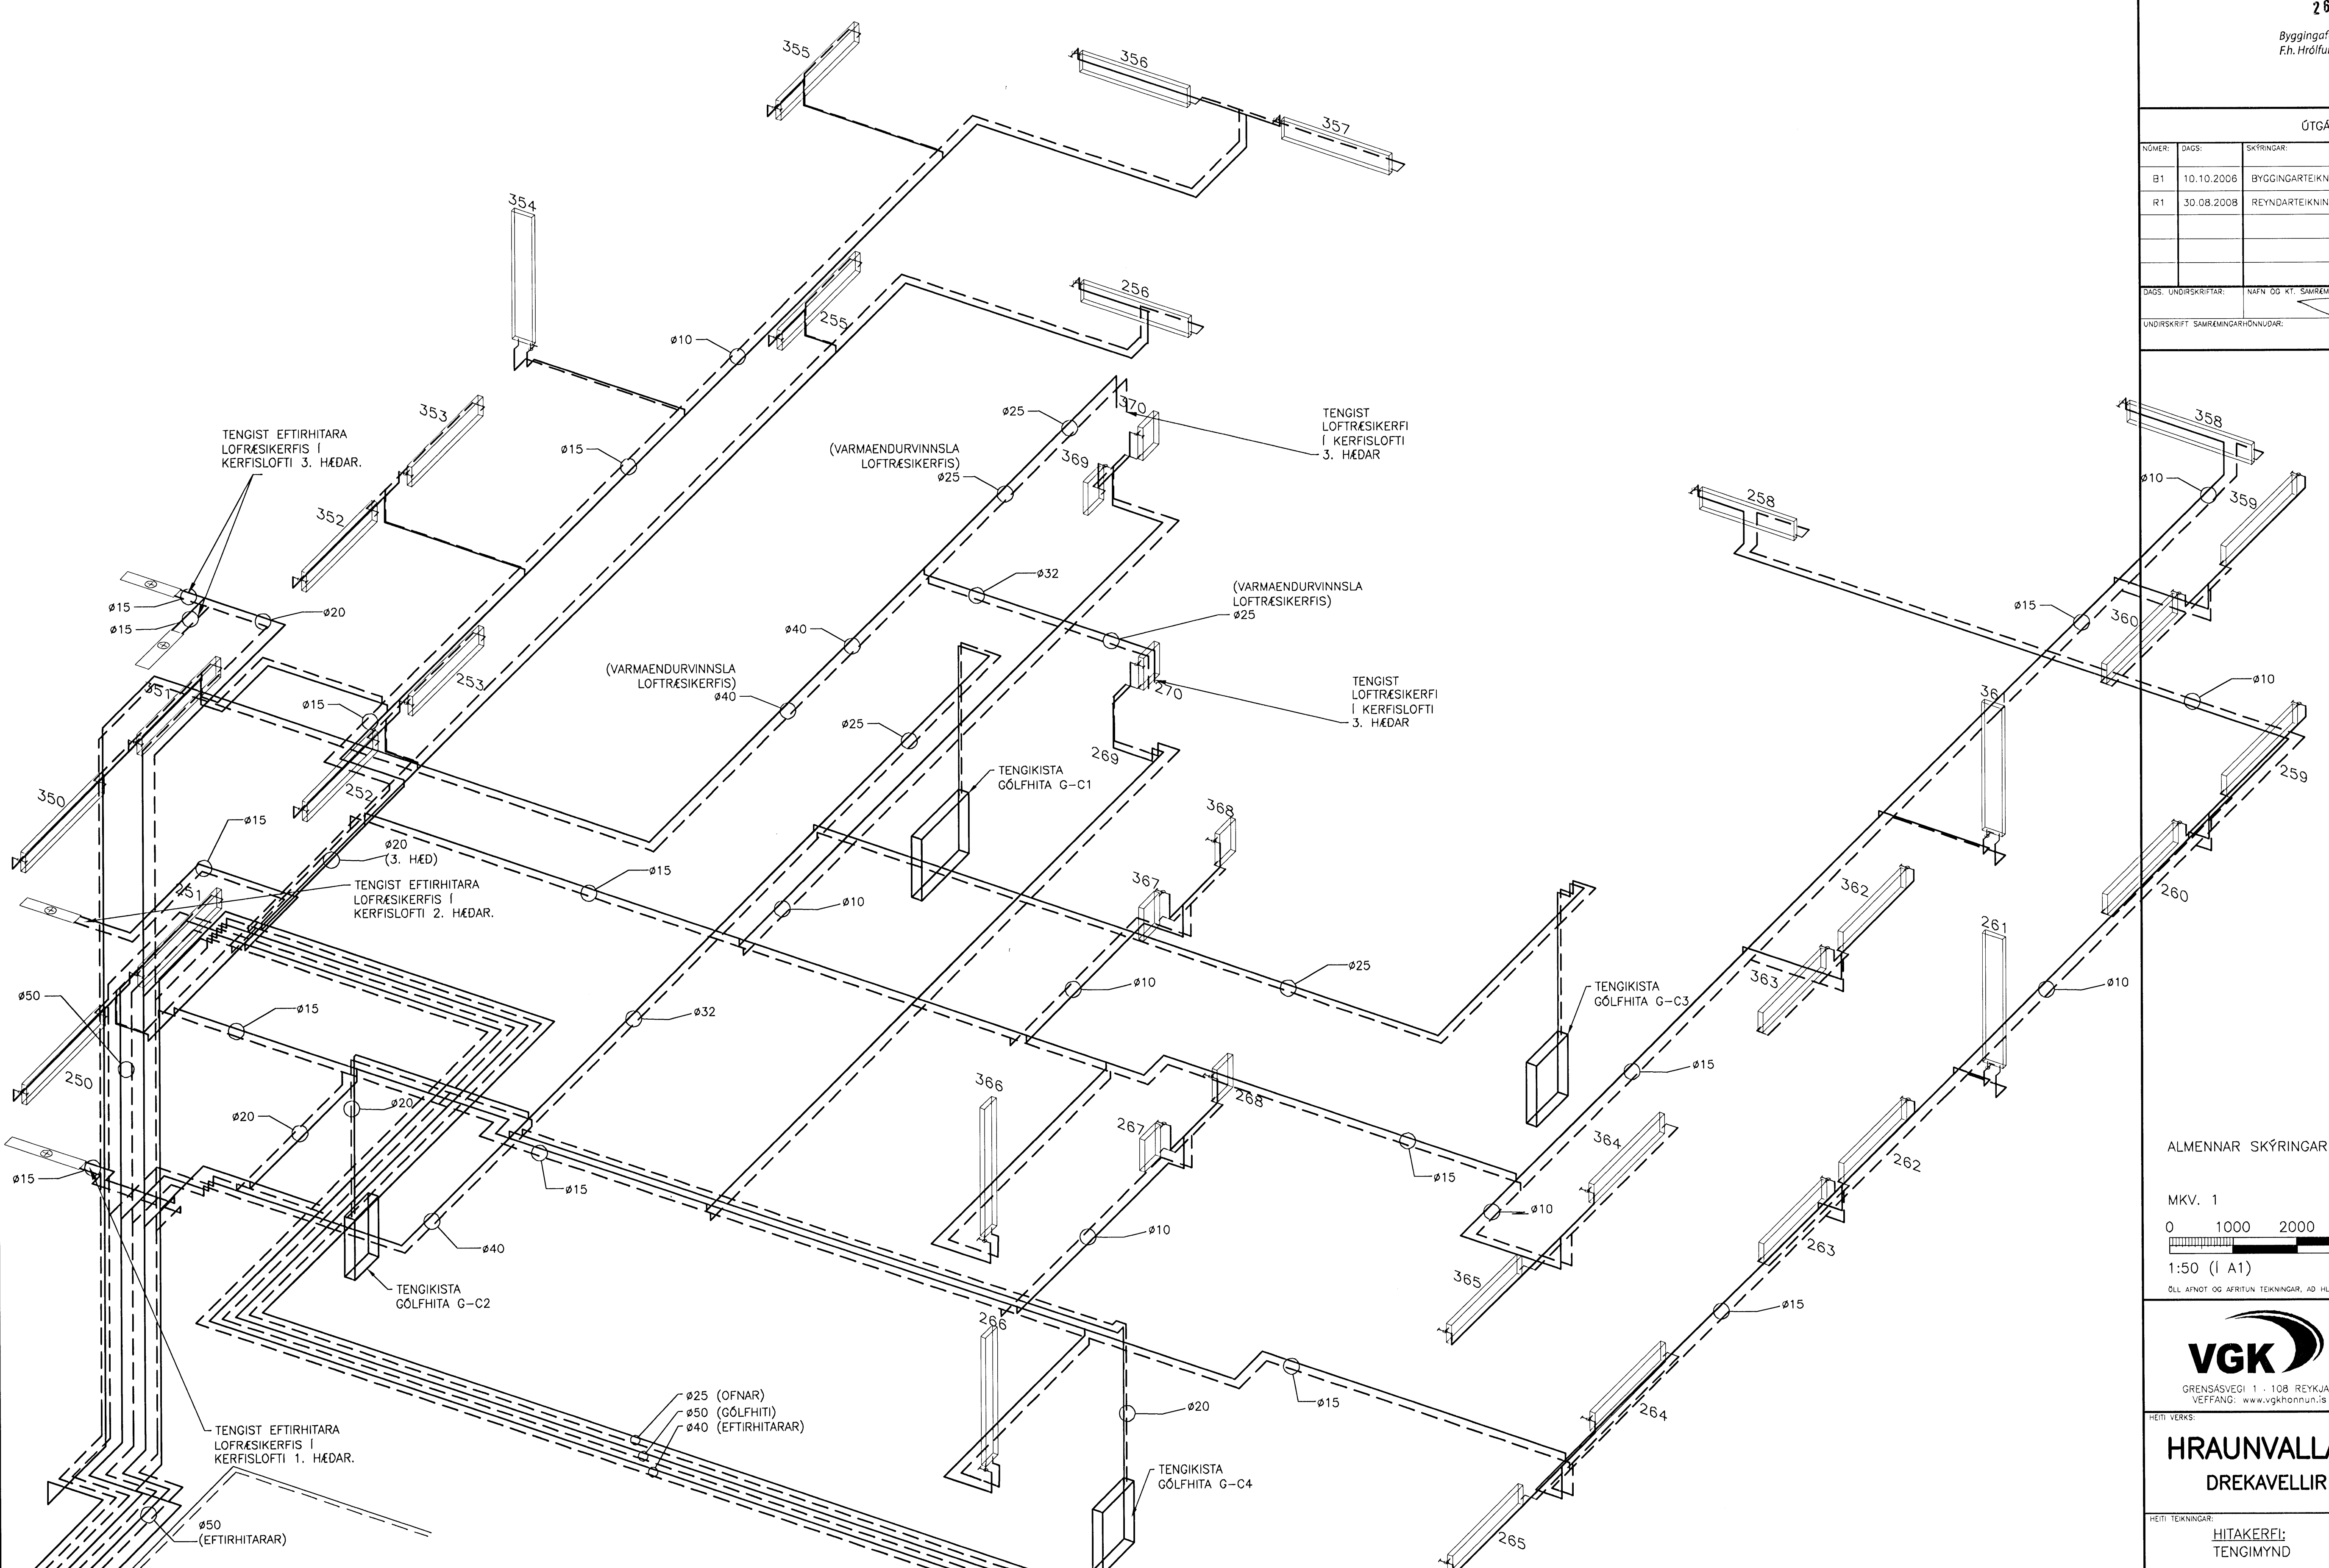

TENGIKISTA GÖLFHITA G-C1

TENGIKISTA GÖLFHITA G-C2

TENGIKISTA GÖLFHITA G-C3

TENGIKISTA GÖLFHITA G-C4














ALMENNAR SKÝRINGAR SJÁ TEIKN. P2-461.

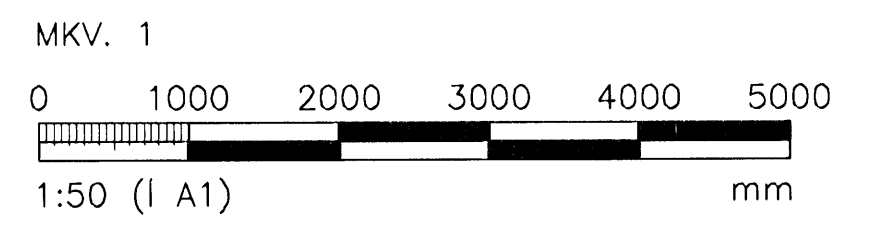

ÖLL AÞNOT OG AFRITUN TEIKNINGAR, AD HEUTA EÐA HEILD, ER HÁÐ SKRIFLEGU LEYFI HÖFUNDA.



GRENASVEGI 1 · 108 REYKJAVÍK · Sími: 422 3000 · Fax: 422 3001
 VEFANG: www.vgkhonnun.is · NETFANG: vgkhonnun@vgkhonnun.is

HÉTTI VERKS:
HRAUNVALLASKÓLI 2. ÁF.
 DREKAPELLIR 9, HAFNARFIRDI

HÉTTI TEIKNINGAR:
 HITAKERFI:
 TENGIKYND

MÆLT:	TEIKNAD:	LS	GEYMSLUNÚMÉR:	VNR:	3.151.218
HAUNAD:	YFIRFAR:	MKV:	1:50	NR. TEIKNINGAR:	
DAGS. UNDRSKRIFTAR:	NAFN OG KT. HÖNNUNAR:				P2-451
31.12.2008	LÁRUS ÁRSÆLSSON		430572-0169		
UNDRSKRIFT HÖNNUNAR:				ÓTGÁFA:	R1
LÁRUS ÁRSÆLSSON					

TENGIKYND
 MKV. 1.