



A SNID
MKV. 2

B SNID
MKV. 2


STADSETNING HJÓLAGEYMSLU, SJÁ TEIKN. LANDSLAGSARKITEKTS NR. L01

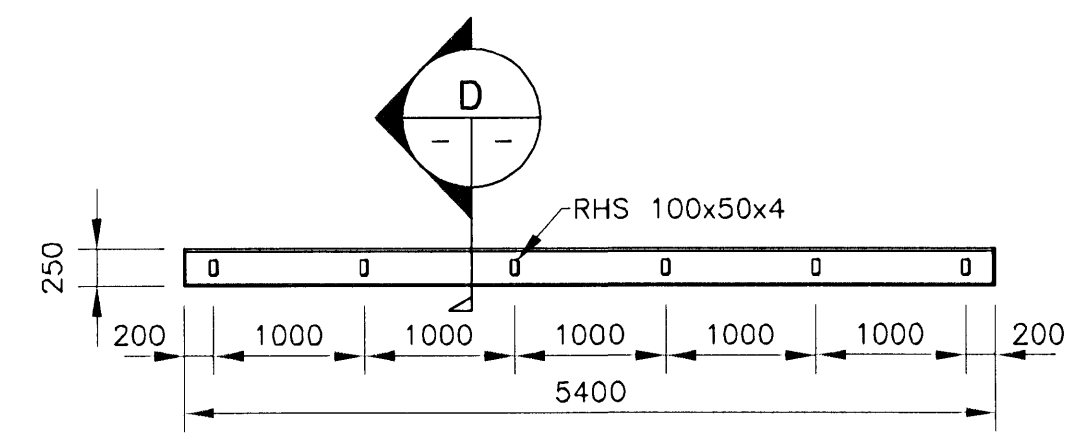


GRUNNMYND, UNDIRSTADA VID HJÓLAGEYMSLU MKV. 3

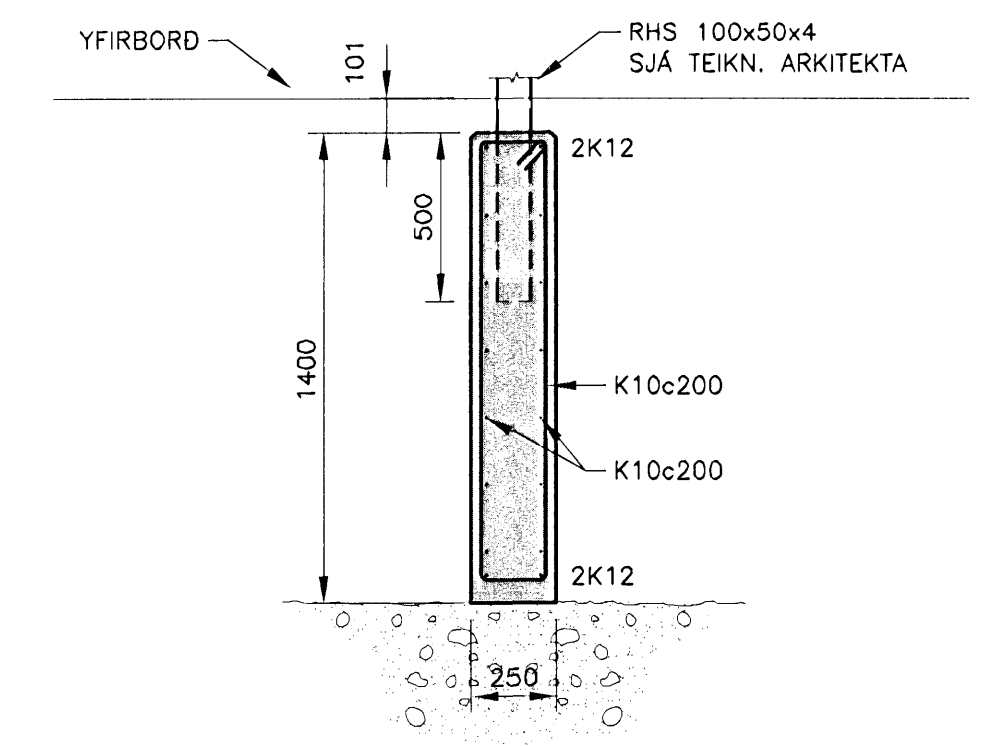

D SNID
MKV. 2

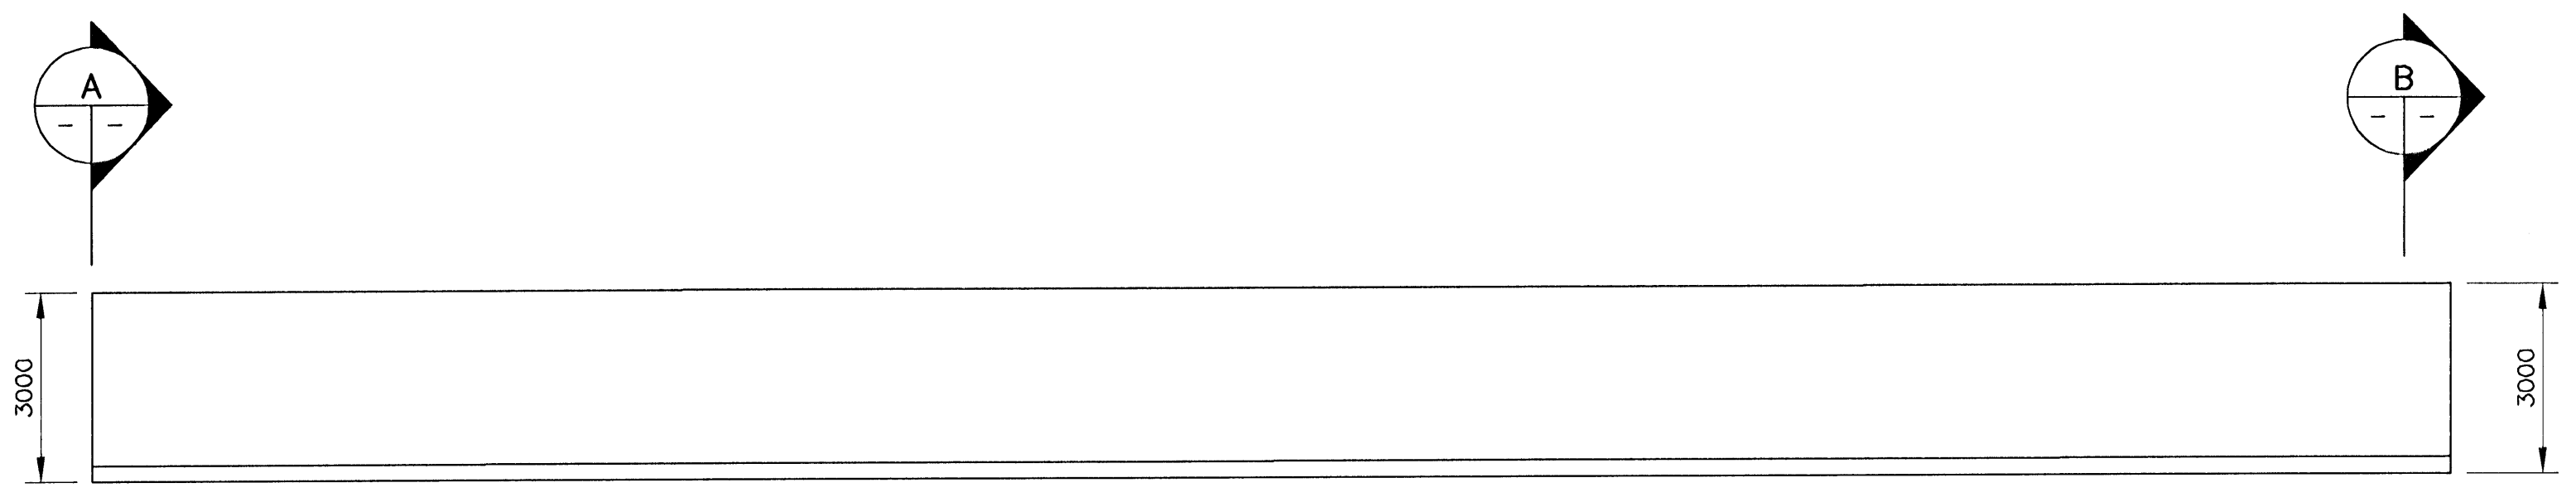

C HLIDARMYND
MKV. 1

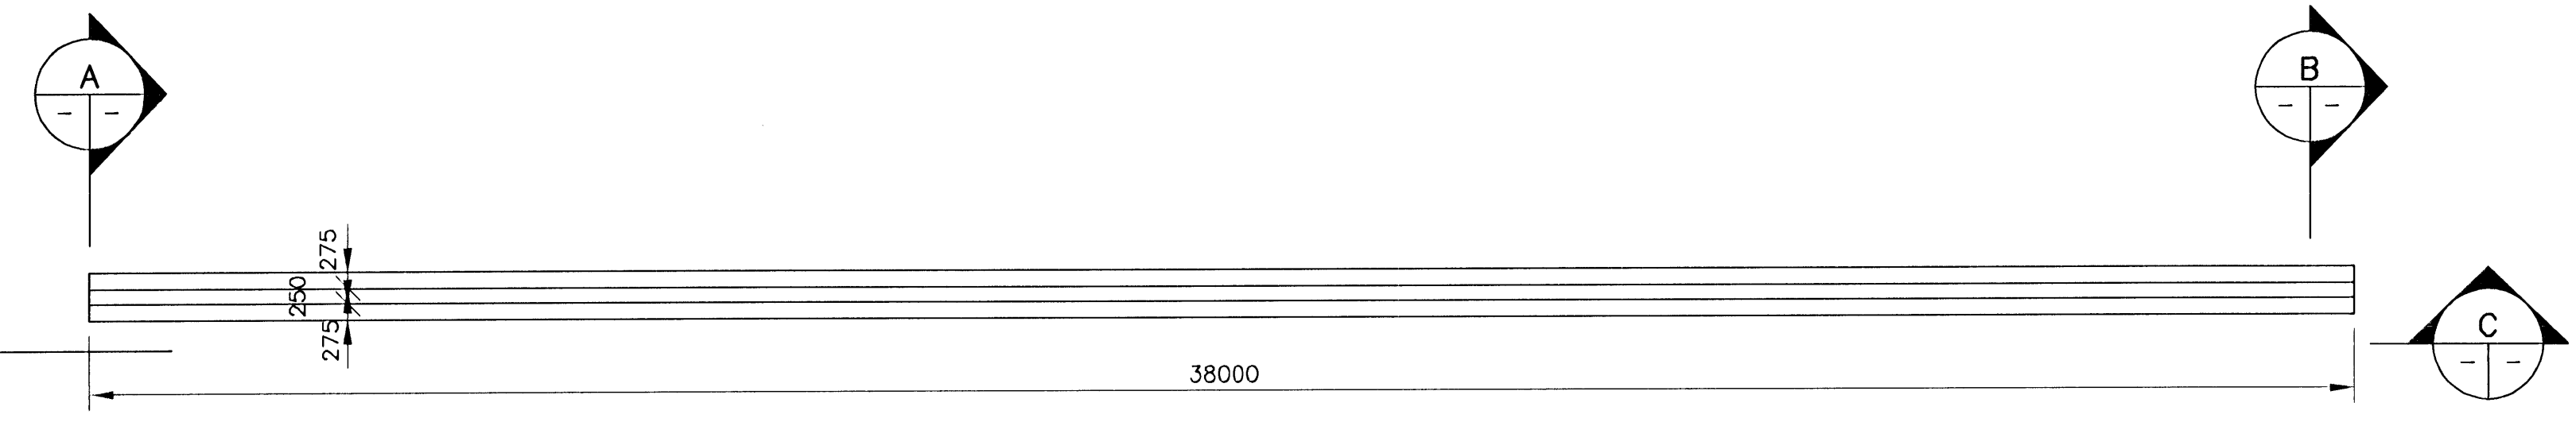


GRUNNMYND VEGGS
MKV. 1




Samþykkt þann
05 MAR 2009
Byggingafrúnni í Hafnarfirði
F.h. Hrólfur S. Gunnlaugsson

ÓTGÁFUFRILL			
NÚMÉR.	DAGS.	SKÝRINGAR.	HANNAÐ
B1	25.07.2007	BYGGINGARTEIKNING	LÁ
B2	08.10.2007	LÆRÆTTUR VEGGUR	LÁ
R1	19.08.2008	REYNDARTEIKNING	LÁ

DAGS. UNDIRSKRIFTAR: NAFN OG KT. SAMRÆMINGARHÖNNUNAR:
UNDIRSKRIFT SAMRÆMINGARHÖNNUNAR: *[Signature]*

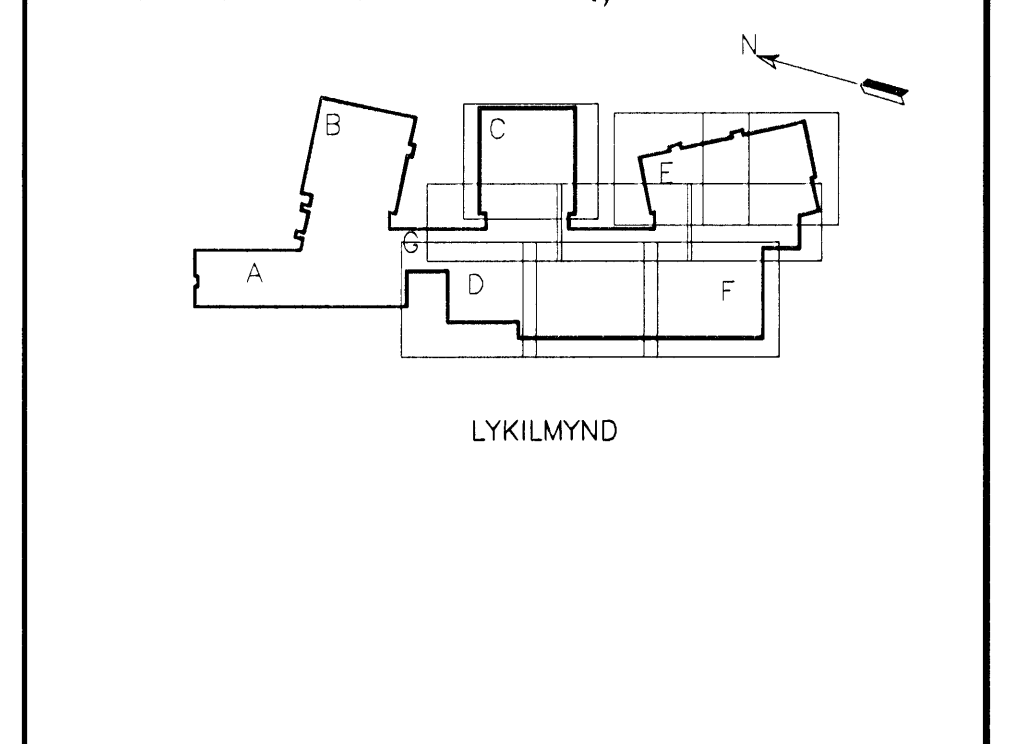

- ATHUGASEMDIR:**
- ALMENNAR SKÝRINGAR, DEILI OG SNID SJÁ TEIKN. B2-001 TIL B2-005
 - STADSETNING SAMKVÆMT LÓÐARHÖNNUDI
 - STEYPA SÉ FROSTPÓLIN ÚTISTEYPA
 - FYLLT SÉ UNDIR VEGG MED BURDARHÆFU FROSTFRÍU FYLINGAREFNI, SEM SÉ ÞJAPPAD SKV. VERKLÝSINGU.

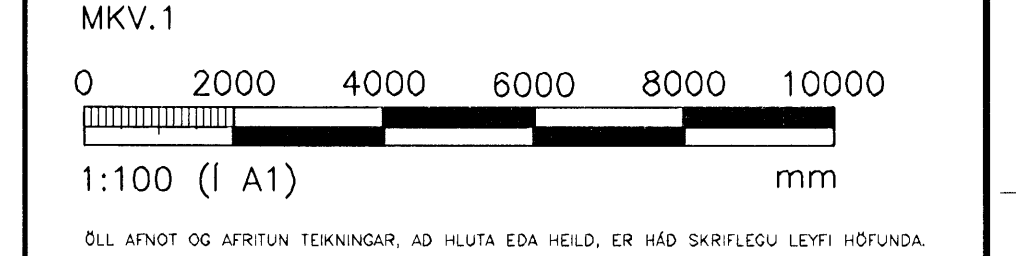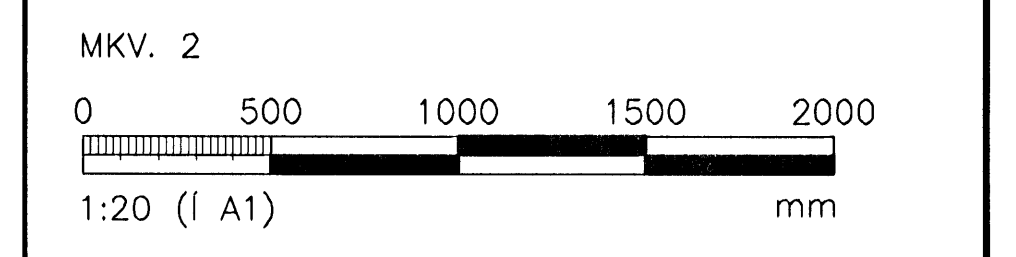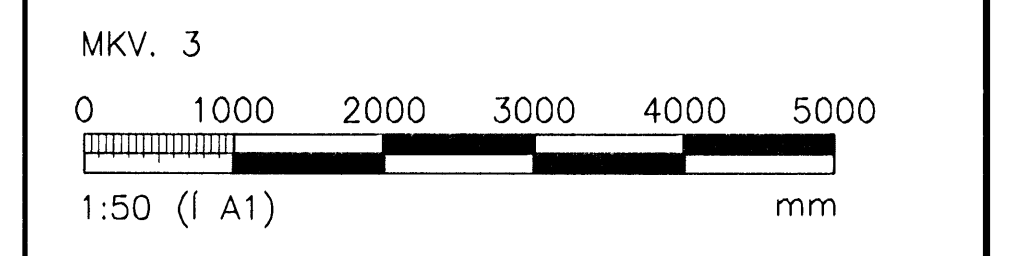

VGK HÖNNUN

GRENSÁSVEGI 1 · 108 REYKJAVÍK · Sími: 422 3000 · Fax: 422 3001
VEFFANG: www.vgkhonnun.is · NETFANG: vgkhonnun@vgkhonnun.is

HEITI TEIKNINGAR:
HRAUNVALLASKÓLI 2. ÁF.
DREKAVELLIR 9, HAFNARFIRÐI

HEITI TEIKNINGAR:
BURDARVIRKI:
STODVEGGIR VID BATAVÖLL, HJÓLAGEYMSLA
SÖKKLAR, VEGGUR

MELT:	TEIKNAD:	GEYMSLUNUMER:	VNR:
	AJK		3.151.218
HANNAÐ:	YFRFARÐ:	MKV:	NR. TEIKNINGAR:
LÁ		1:20, 100 A1	
DAGS. UNDIRSKRIFTAR:	NAFN OG KT. HÖNNUNAR:	430572-0169	B2-120
31.12.2008	VGK-HÖNNUN		
UNDIRSKRIFT HÖNNUNAR:	ÓTGÁFA:	200862-5119	R1
LÁRUS ÁRSÆLSSON			