


16.3.08

Hönnuður:
ARI, HAS
Yfirfarð:
Sambýkt: Davíð Skjason kt: 100356-3339

Breytingar:
B1: 25.02.2009 Reyndartekningar

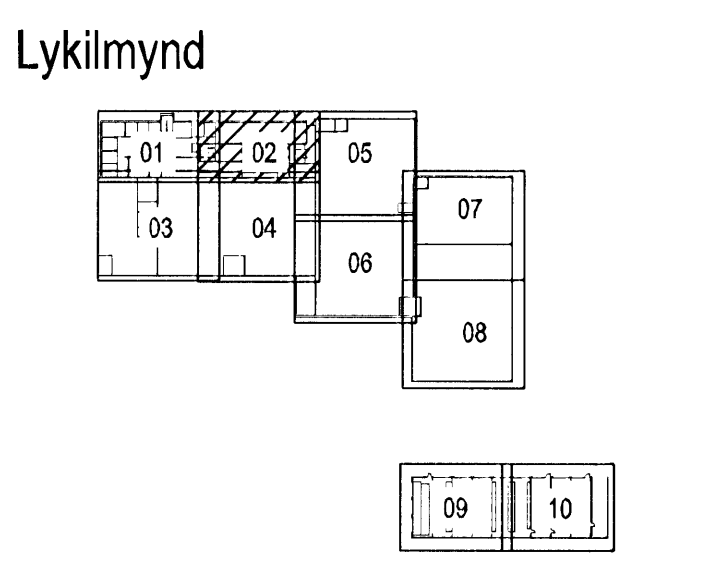

Aðalhönnuður:
25.02.2009
Davíð Skjason

Héðinn
Gjáhella 4
221 Hafnarfjörður

Öryggiskerfi
1. hæð
Mkv: 1:50

RTS
VERKFRÆÐISTOFA

Grensásvegur 3
108 Reykjavík
Sími 520 9900
Fax 520 9901
www.rts.is

Attak gæðvottun skv. BS EN ISO 9001:2000
FRV
FS 88744

32-2166-1-
03.04.2008
013202
B1