


Hönnuður:  
 ARI, HAS  
 Yfirfarð:  
 ---  
 Samþykkt: Davíð Sölvason kt: 100356-3339

Breytingar:  
 B1: 25.02.2009 Reyndarleiðningar  
 ---  
 ---  
 ---  
 ---  
 ---

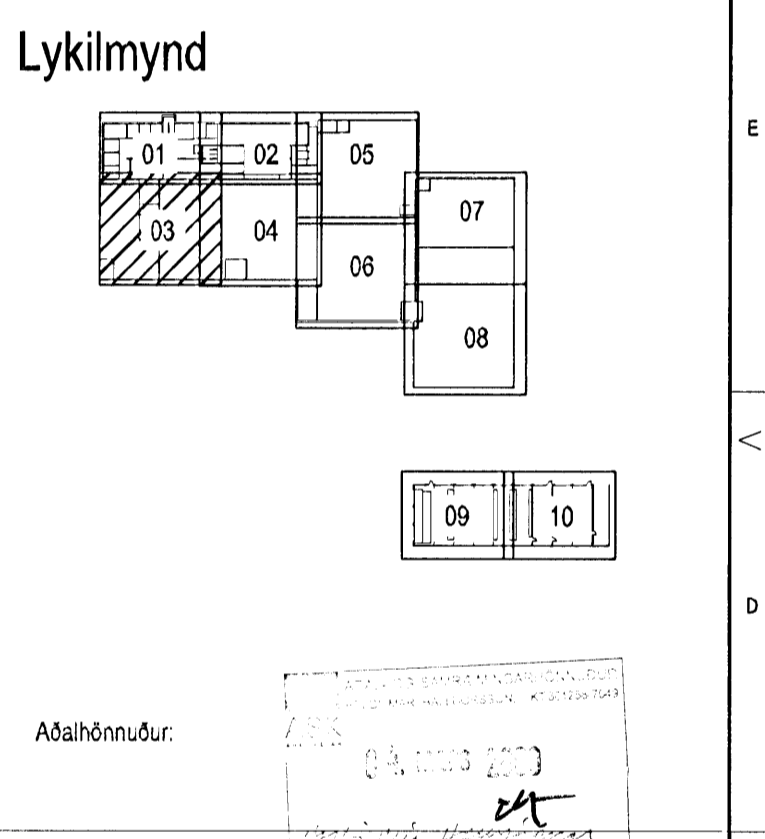

Héðinn  
 Gjáhella 4  
 221 Hafnarfjörður

Öryggiskerfi  
 1. hæð  
 Mkv: 1:50

**VERKFRÆÐISTOFA**

Grensásvegur 3  
 108 Reykjavík  
 Sími 520 9900  
 Fax 520 9901  
 www.rts.is

Atlix jafnvottun skv BS EN ISO 9001:2000

FS 88744

32-2166-1-  
 03.04.2008

013203 B1