


3-09

Hönnuður:
ARI, HAS
Yfirritöð:
Samblykt: *David Svansson* kt: 100356-3339

Breytingar:
B1: 25.02.2009 Reyndartekningar


Lykilmynd

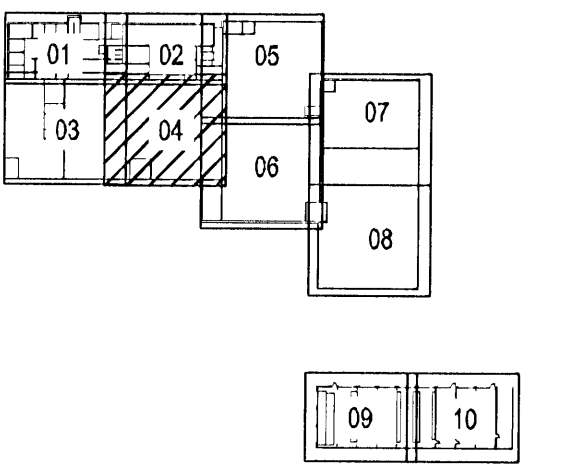

Aðalhönnuður:
ASK
[Signature]

Héðinn
Gjáhella 4
221 Hafnarfjörður

Öryggiskerfi
1. hæð
Mkv: 1:50

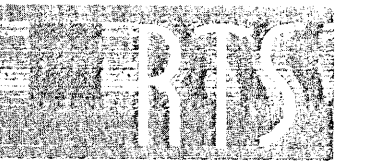

VERKFR/EDISTOFA
Grensásvegur 3
108 Reykjavík
Sími 520 9900
Fax 520 9901
www.rts.is



32-2166-1-
03.04.2008 013204 B1