


Hönnuður:
ARI, HAS

Yfirfarð:

Samþykkt: Davíð Svavash *[Signature]* kt: 100356-3339

Breytingar:
B1: 25.02.2009 Reyndartekningar

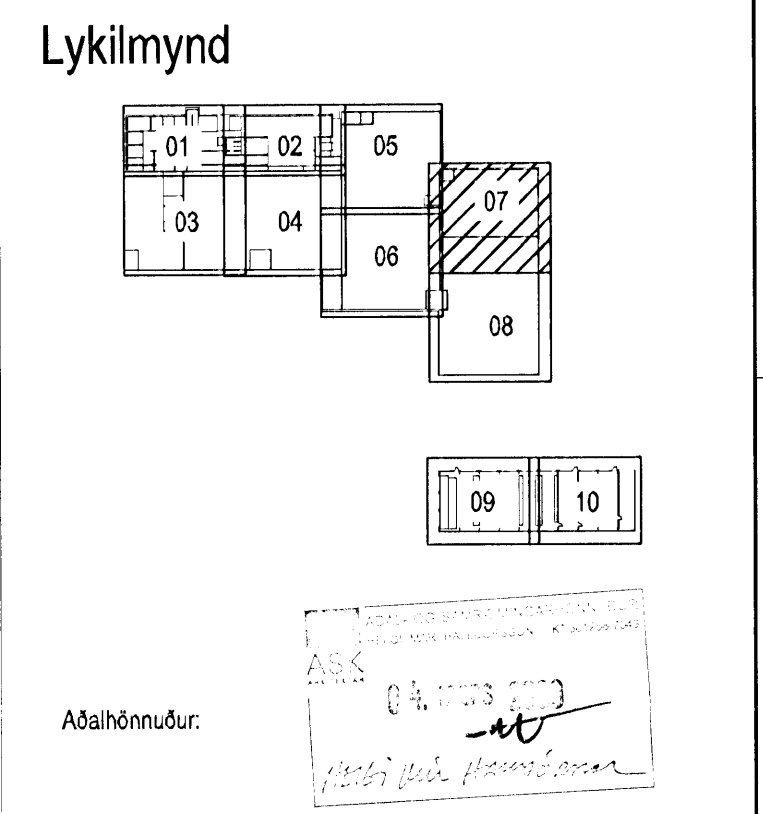

Héðinn
Gjáhella 4
221 Hafnarfjörður

Öryggiskerfi
1. hæð
Mkv: 1:50

RTS
VERKFRÆÐISTOFA

Grensásvegur 3
108 Reykjavík
Sími 520 9900
Fax 520 9901
www.rts.is

Atvika gæðavottur sýv
BS EN ISO 9001:2000

FS 88744

32-2166-1-
03.04.2008

013207

B1