


14/3/08

Hönnuður:
ARI, HAS
Yfirfarð:

Samþykkt: Davíð Svavarskiöld kt: 100356-3339

Breytingar:
B1: 25.02.2009 Reyndartekningar

Lykilmynd

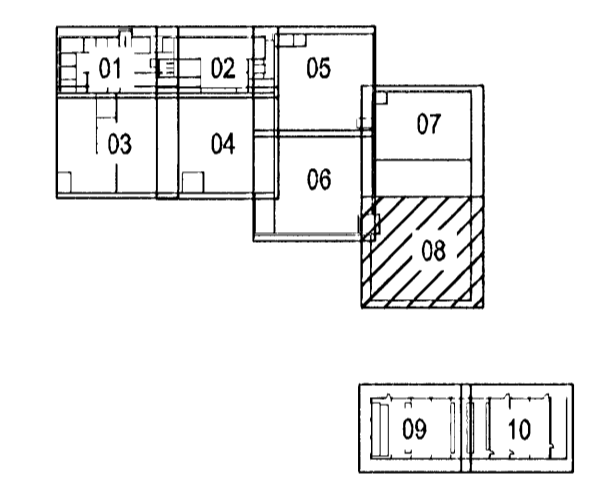

Aðalhönnuður:
[Signature]

Héðinn
Gjáhella 4
221 Hafnarfjörður

Öryggiskerfi
1. hæð
Mkv: 1:50



VERKFRÆDISTOFA
Grensásvegur 3
108 Reykjavík
Sími 520 9900
Fax 520 9901
www.rts.is



32-2166-1-
03.04.2008 013208 B1