


14320

Hönnuður:
ARI, HAS
Yfirfarir:

Samþykkt: Davíð Spörvasón kt: 100356-3339

Breytingar:
B1: 25.02.2009 Reyndartekningar


Lykilmynd

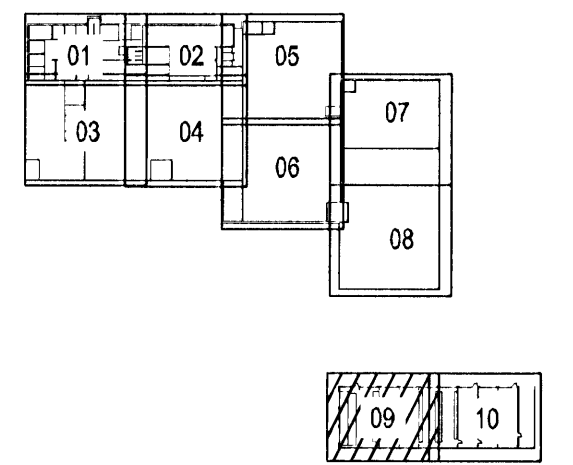

Aðalhönnuður:
ASK

Héðinn
Gjáhella 4
221 Hafnarfjörður

Öryggiskerfi
Siberia 1.Hæð
Mkv: 1:50

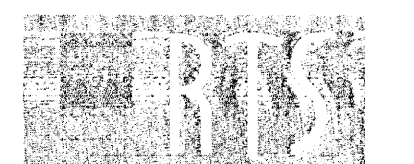

VERKFRÆDISTOFA
Grensásvegur 3
108 Reykjavík
Sími 520 9900
Fax 520 9901
www.rfs.is



32-2166-1-
03.04.2008

013209 B1

