


Hönnuður:
ARI, HAS
Yfirfarir:
Sambýkt: Davíð S. Jónsson kt: 100356-3339

Breytingar:
B1 12.02.2009 Reyndartekning

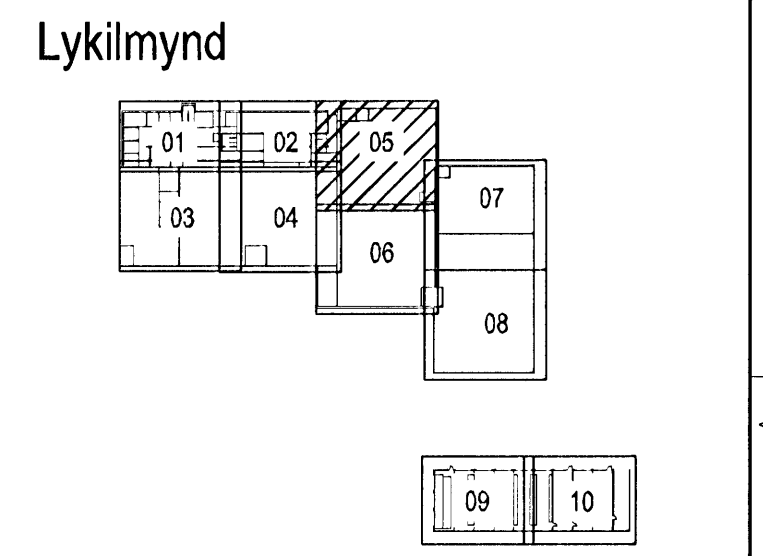

Aðalhönnuður:
[Signature]

Héðinn
Gjahella 4
221 Hafnarfjörður

Brunaviðvörunarkerfi
1. hæð
Mkv: 1:50

VERKFRÆÐISTOFA
Grensásvegur 3
108 Reykjavík
Sími 520 9900
Fax 520 9901
www.rts.is

FRV
FRV
FRV

Attek gæðvottan skv. BS EN ISO 9001:2000
FS 88744

32-2166-1-
03.04.2008
013405
B1