
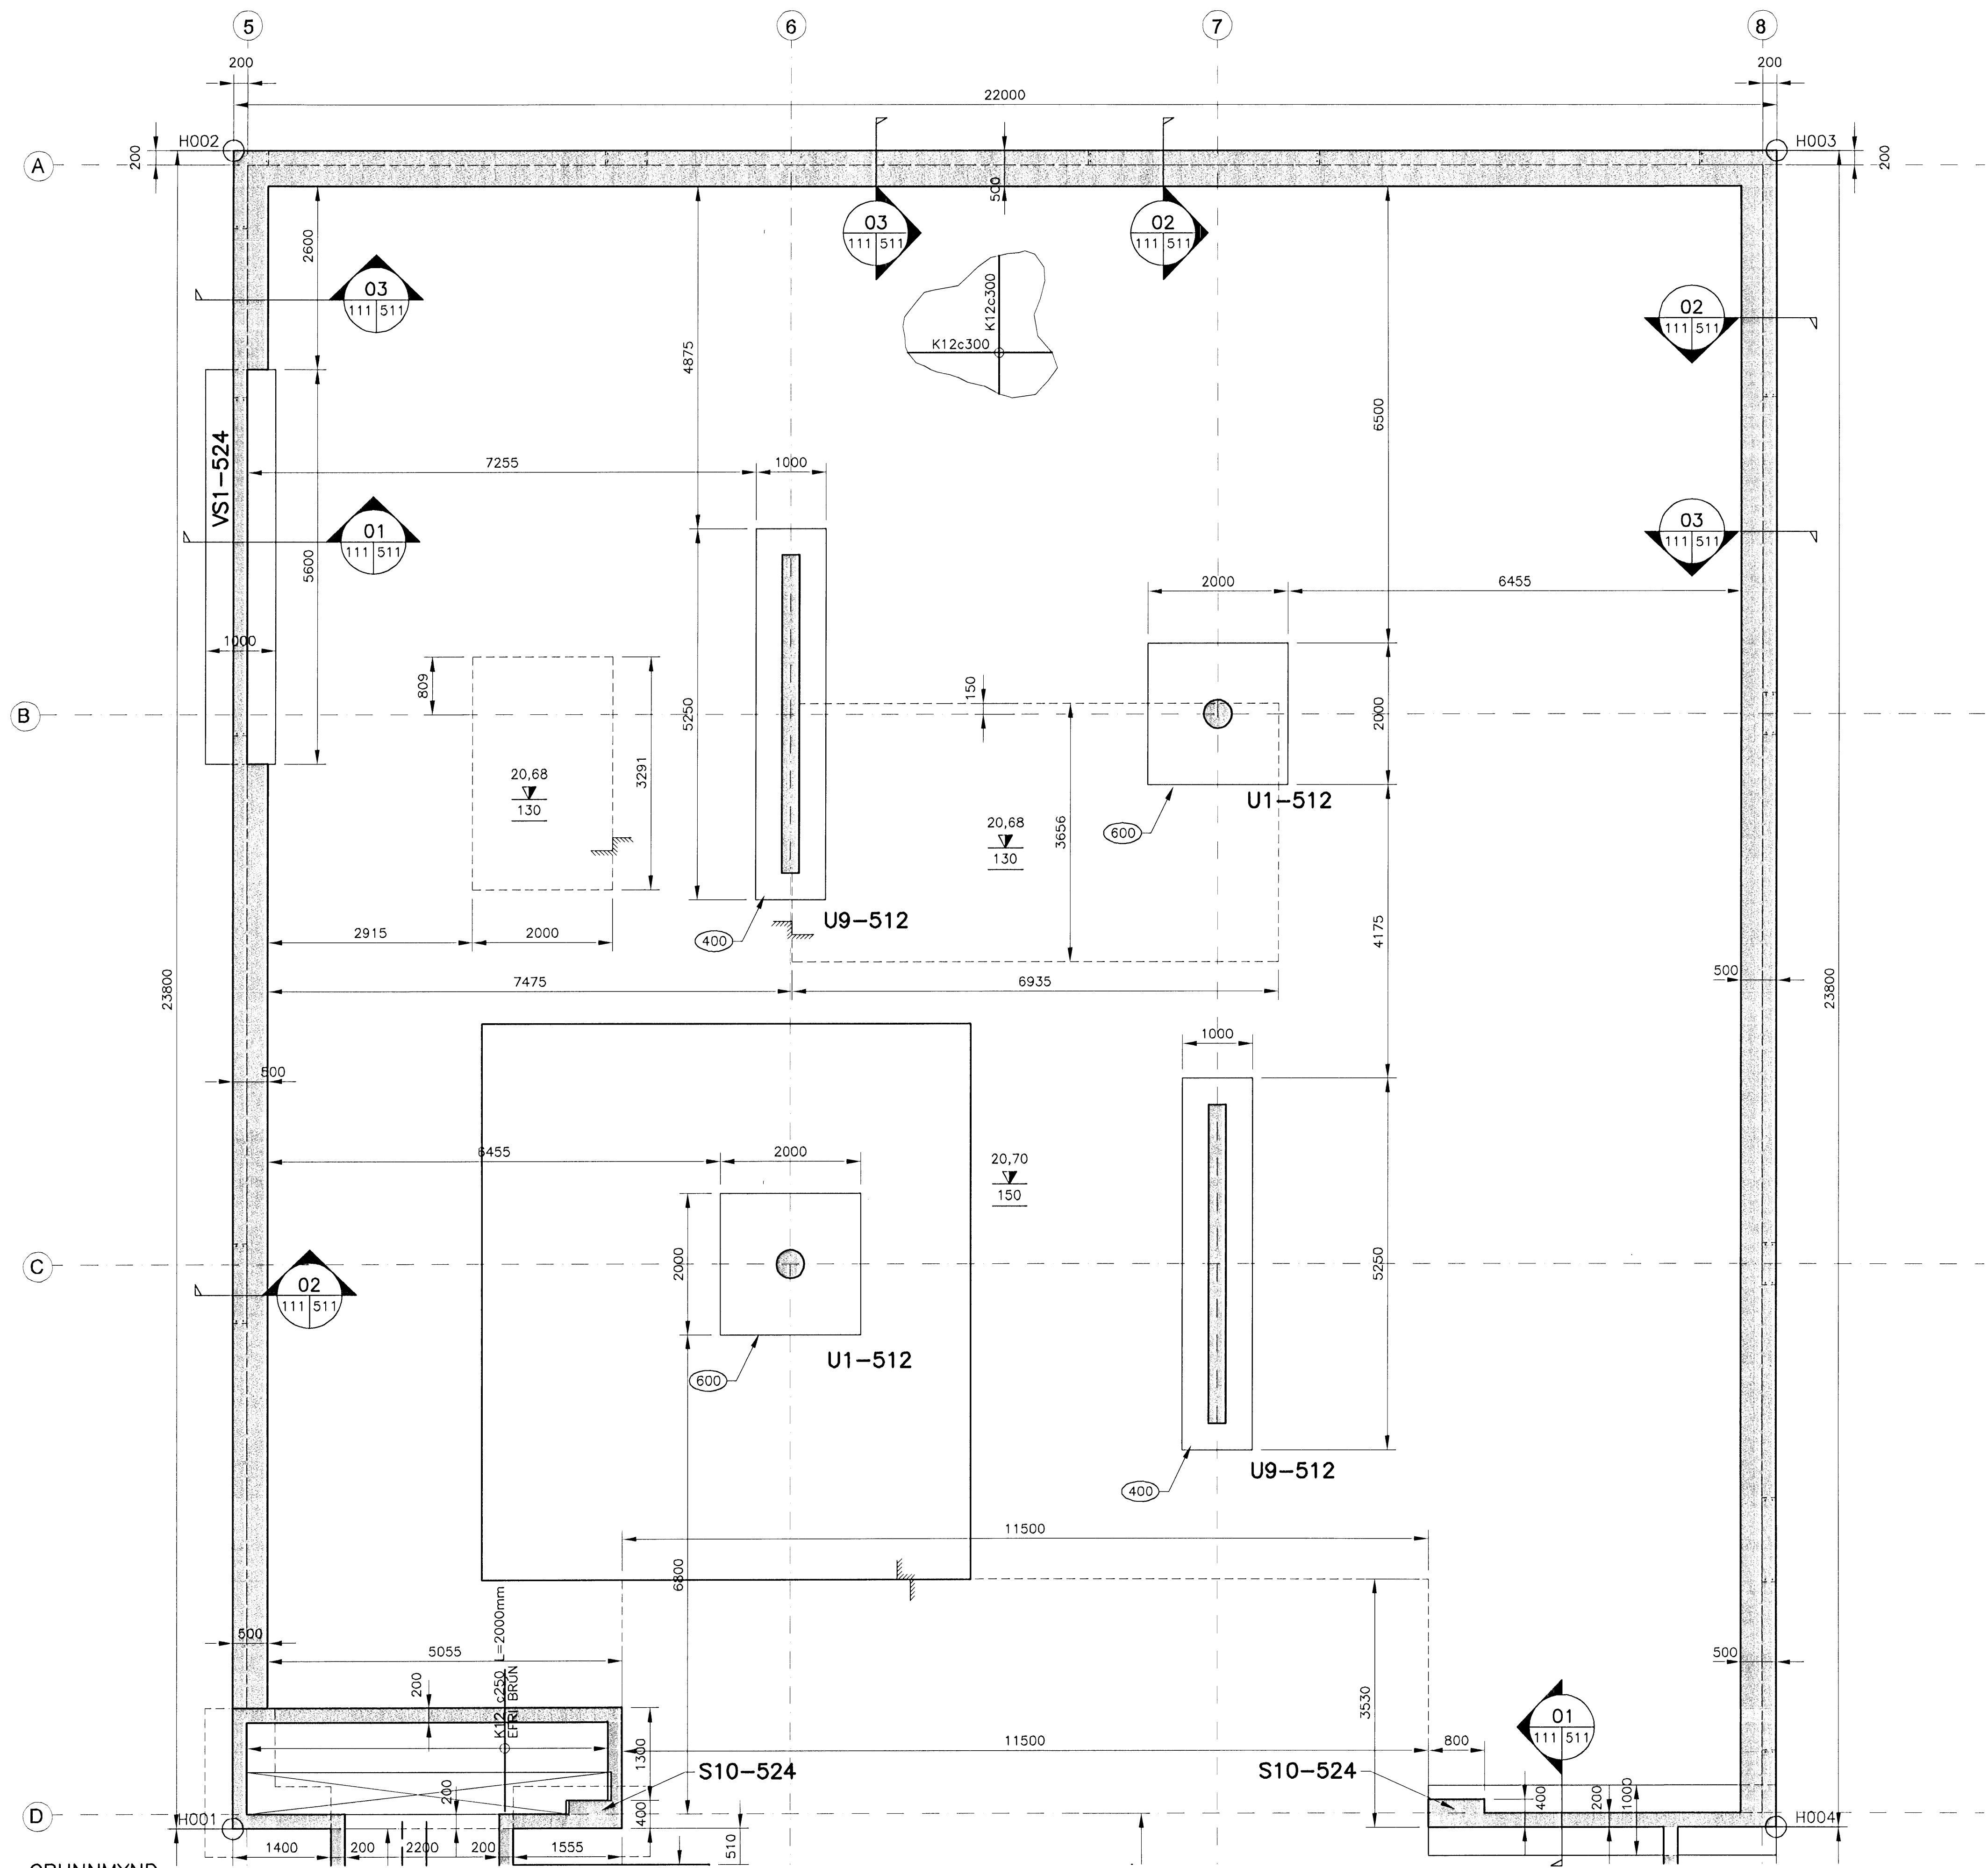



HNITASKRÁ		
PKT.	X-HNIT	Y-HNIT
H001	354528,7051	397100,3190
H002	354551,7358	397106,3214
H003	354557,2842	397085,0326
H004	354534,2536	397079,0302
H005	354538,5617	397062,5741
H006	354550,1878	397068,3907
H007	354567,5483	397033,6912
H008	354555,2958	397028,9030
H008B	354555,8328	397027,8298
H009	354548,6779	397025,5920
H010	354539,3063	397027,3876
H011	354537,2767	397035,1750
H012	354518,0539	397030,1650
H013	354503,8296	397084,7418
H014	354539,4137	397053,4958
H015	354543,7958	397055,6883
H016	354549,7914	397043,7044
H017	354545,4093	397041,5120
H018	354528,3533	397069,9485

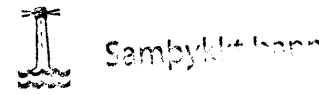


GRUNNMYND
MKV. 1



05 MAR 2009
 Byggingafrúnninn / Húsnáð: 3
 F.h. Hörfur S. Gunnlaugsson

ÓTGÁFUFRILL			
NÚMÉR:	DAGS:	SKÝRINGAR:	HANNAÐ:
B1	03.10.2006	BYGGINGARTEIKNING	HÓÓ
B2	10.10.2006	SÖKKLUM BREYTT	HÓÓ
B3	10.01.2007	VS1-524	HÓÓ
B4	29.08.2007	STÉKKUN HÚSS	LÁ
R1	19.08.2008	REYNDARTEIKNING	LÁ

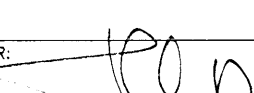DAGS. UNDRSKRIFAR: NAFN OG KT. SAMREINGARHÖNNUNAR:
 UNDRSKRIFT SAMREINGARHÖNNUNAR: 

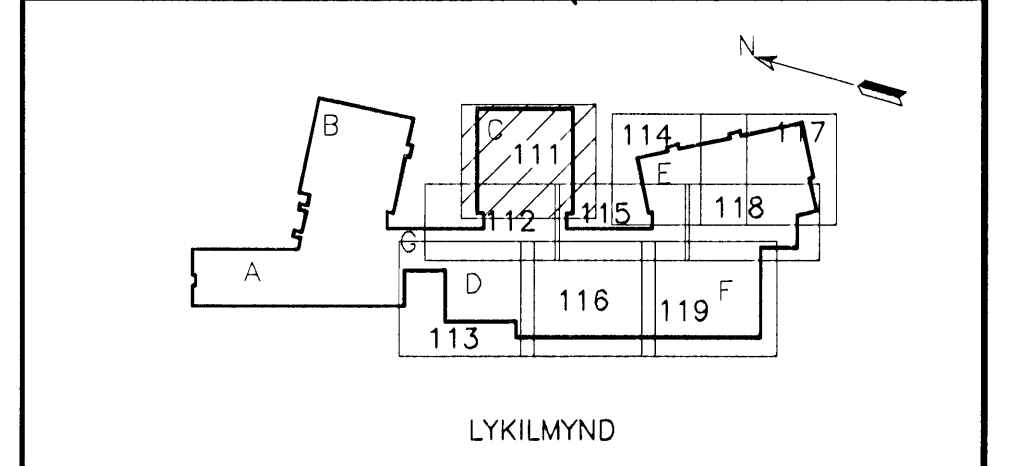

- ATHUGASEMDIR:**
- ALMENNAR SKÝRINGAR, DEILI OG SNID SJÁ TEIKN. B2-001 TIL B2-005
 - ALMENN JÁRNABENDING Í VEGGJUM NEMA ANNARS SÉ GETID Á SÉRMYNDUM.
 - K12c250 HH LÁRÉTT
 - K12c200 HH LÓDRÉTT
 - TVÖ LÓDRÉTT K16 JÁRN SKULU KOMA HVORU MEGIN VÍÐ GÓLFSÍÐ OP OG NÁ 700mm UPP ÚR PLÖTU
 - U- TÁKNAR UNDIRSTÖÐUNÚMÉR, SJÁ TEIKN. B2-512

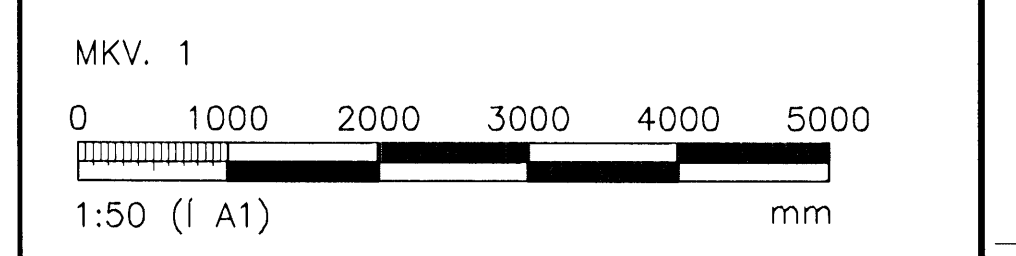

ÖLL AFNOT OG AFRITUN TEIKNINGAR, AD HLUTA EDA HEILD, ER HÁÐ SKRIFLEGU LEYFI HÖFUNDA.


 GREINSÁSGEVI 1 · 108 REYKJAVÍK · Sími: 422 3000 · Fax: 422 3001
 VEFANG: www.vgkhonnun.is · NETFANG: vgkhonnun@vgkhonnun.is

HEITI VERKS:
HRAUNVALLASKÓLI 2. ÁF.
DREKAVELLIR 9, HAFNARFIRÐI

HEITI TEIKNINGAR:
BURDARVIRKI:
UNDIRSTÖÐUR
SÖKKLAR, UNDIRSTÖÐUPLATTAR OG GRUNNPLATA

MELT:	TEIKNAD:	LS/BAR	GEYMSLUNÚMÉR:	VNR:	3.151.218
HANNAÐ:	HÓÓ	YRIFARÐ:	MKV:	1:50	NR. TEIKNINGAR:
DAGS. UNDRSKRIFAR:	31.12.2008	NAFN OG KT. HÖNNUNAR:	VGK-HÖNNUN	430572-0169	B2-111
UNDRSKRIFT HÖNNUNAR:	LÁRUS ÁRSELSSON	UNDRSKRIFT HÖNNUNAR:	200862-5119	ÓTGAFA:	R1