



11 JUN 2009

Byggingafulltrúgættuneyti
F.h. Hröfrur S. Gunnlaussur

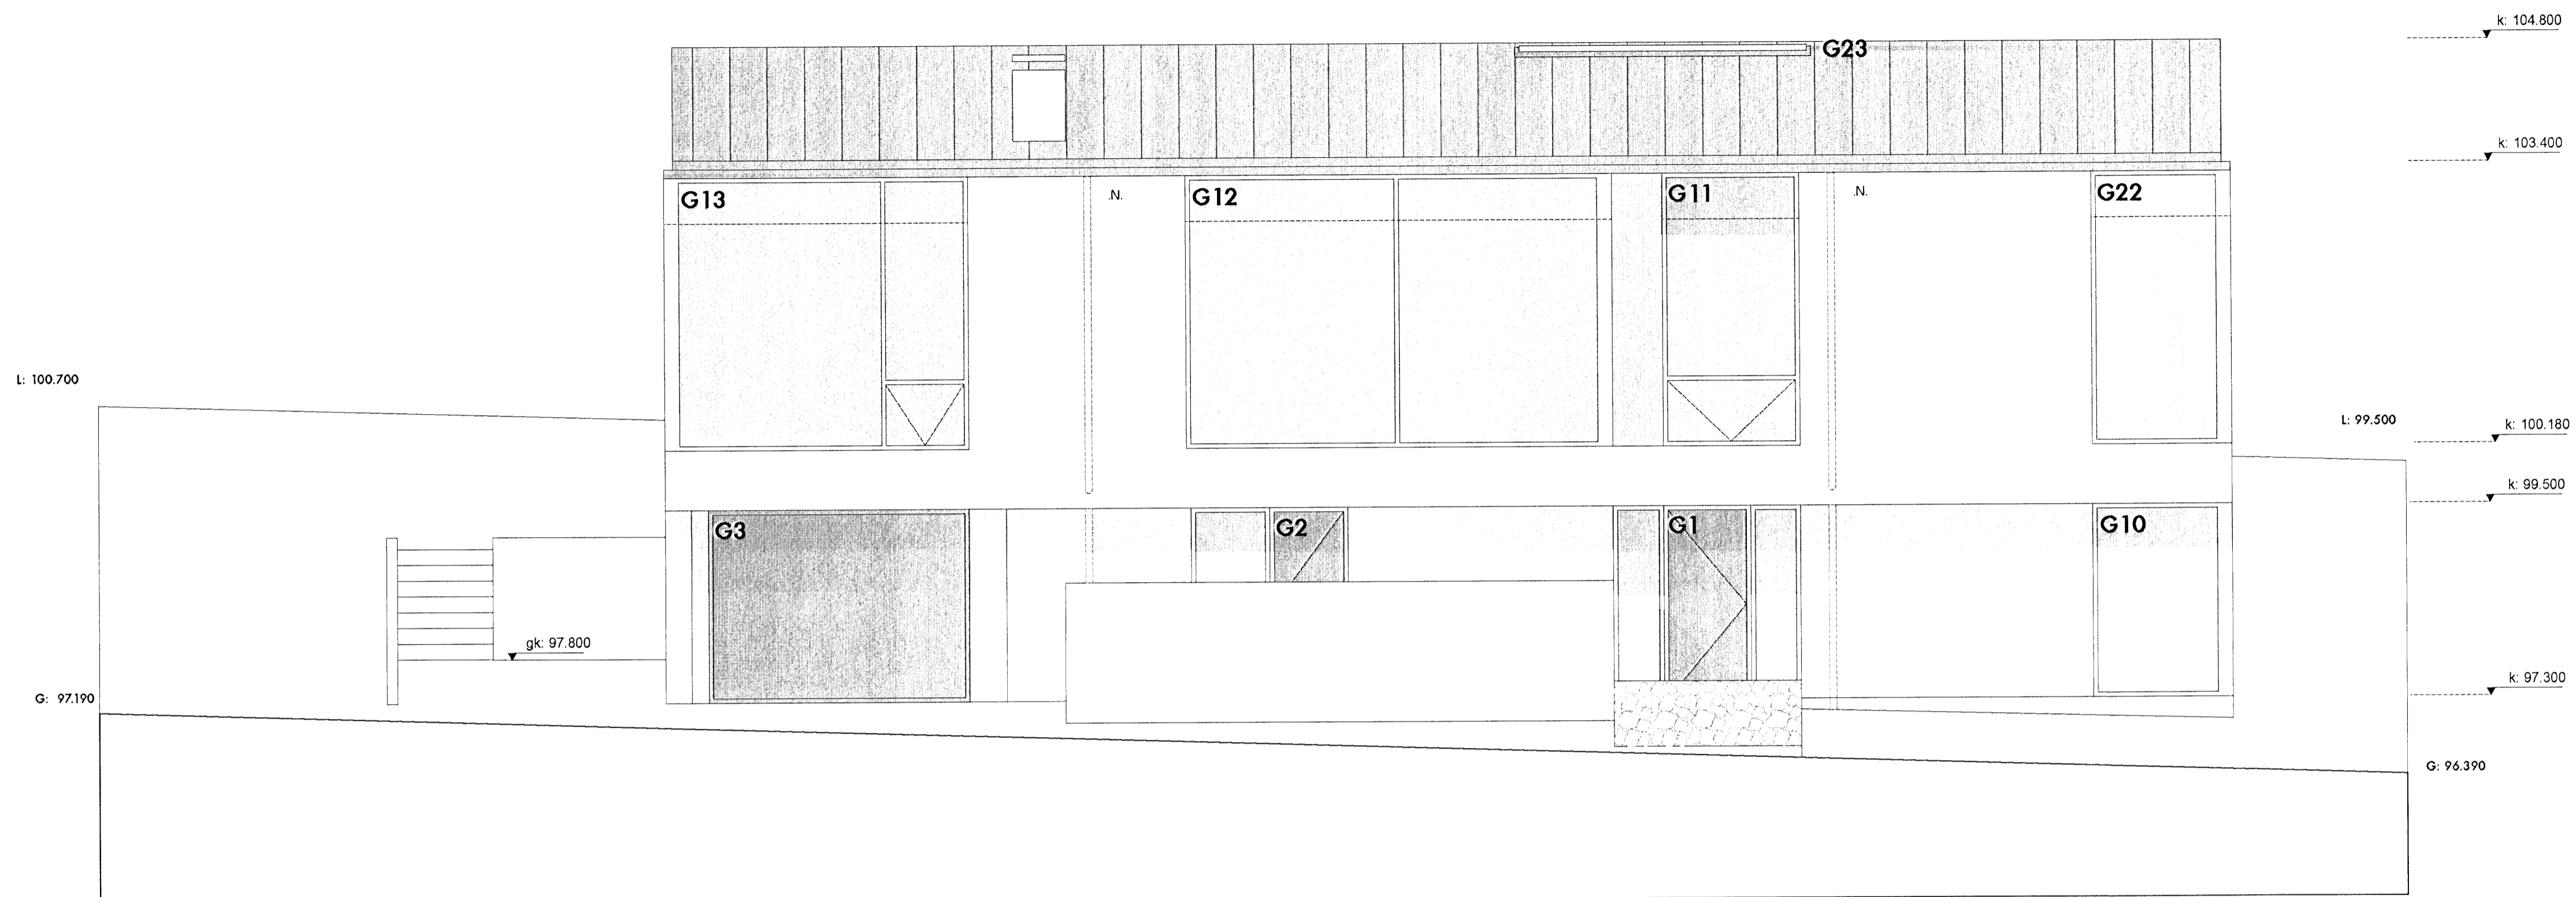

útlit austur
1:50

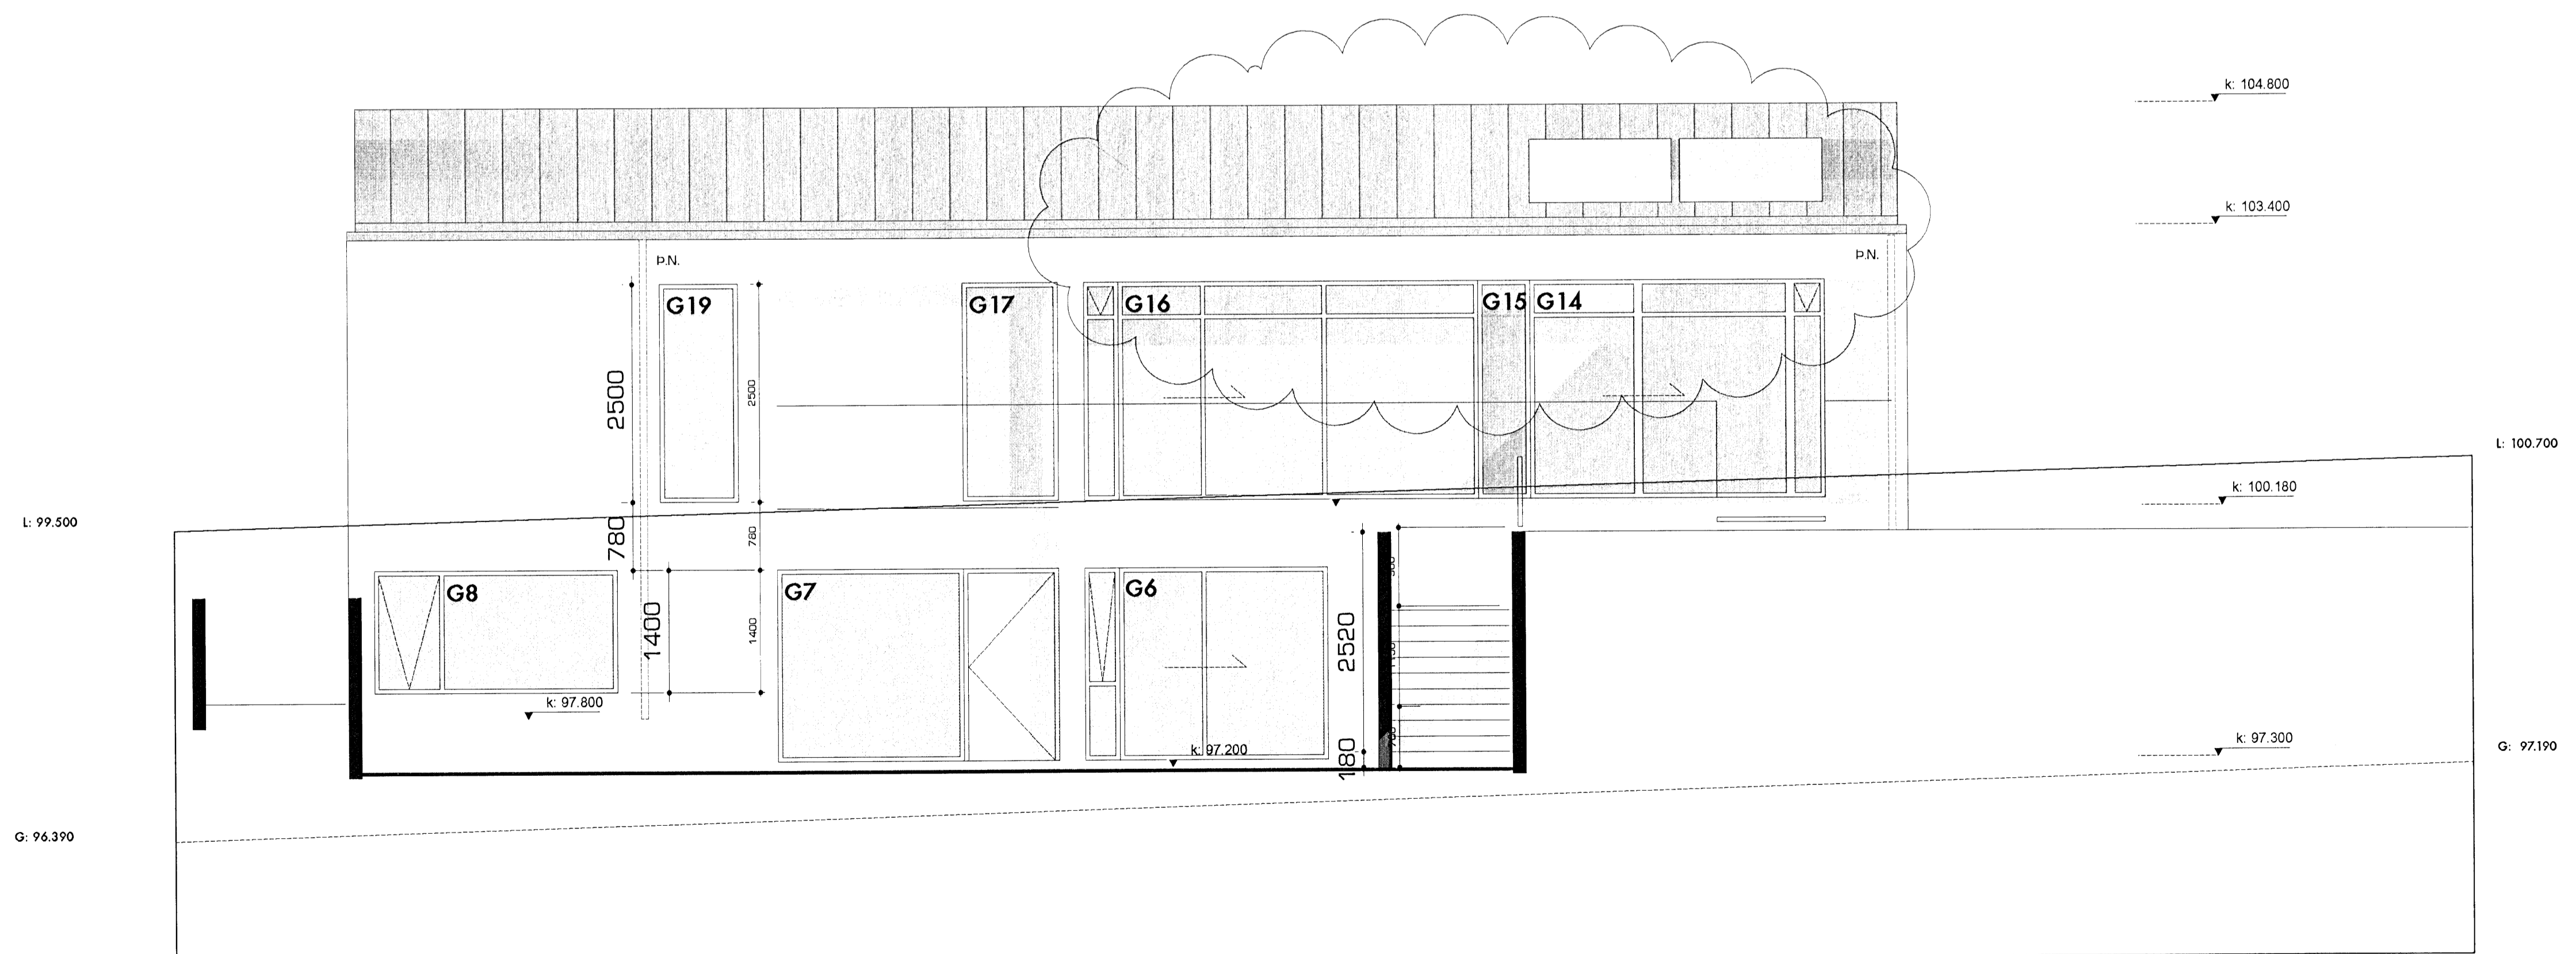

útlit vestur
1:100

08.05.2009: breytt gat í þak og glugga

Samh. M. M. M.
 Kristín Brynja Gunnarsdóttir
 k. 540766 2889
 arkitekt for
 k@einrum.com
 skrifstofa
 arkitekt for meira
 v@einrum.com

einrúm arkitektar
 k. 471201 2850
 gluhellinum 20 | 104 reykjavík
 sími 553 8989 | fax 568 8989

Skógarás "L", Hafnarfjörður
teikning 0648 203

efni útlit austur og útlit vestur
 dags. 16.01.2008
 breytt 08.05.2009
 mkv 1:50