


Hönnuður:
ARI, HAS
Yfirferð:
Sambýkkir: D. Solvason
kt: 100356-3339

Brátingar:
B1 25.02.2009 viðplotugeymsla

Lykilmynd

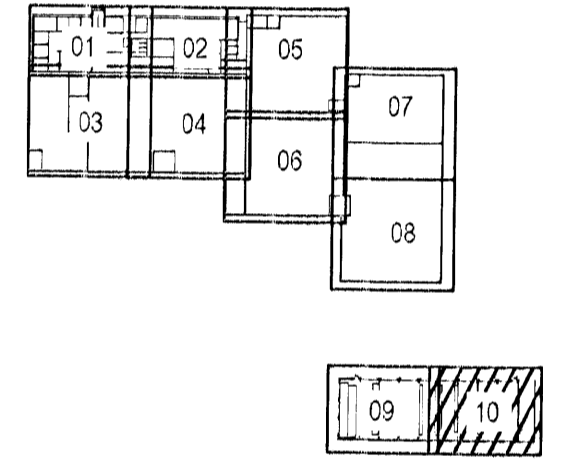


Aðalhönnuður: ASK
04.03.2009

Héðinn
Gjáhella 4
221 Hafnarfjörður

Raflagnir
Sibería 1.Hæð
Mkv: 1:50



VERKFRÆÐISTOFA
Grensásvegur 3
108 Reykjavík
Sími 520 9900
Fax 520 9901
www.rts.is

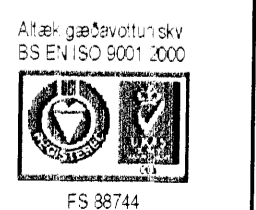

32-2166-1-
03.04.2008
011610
B1

