



16/3 05

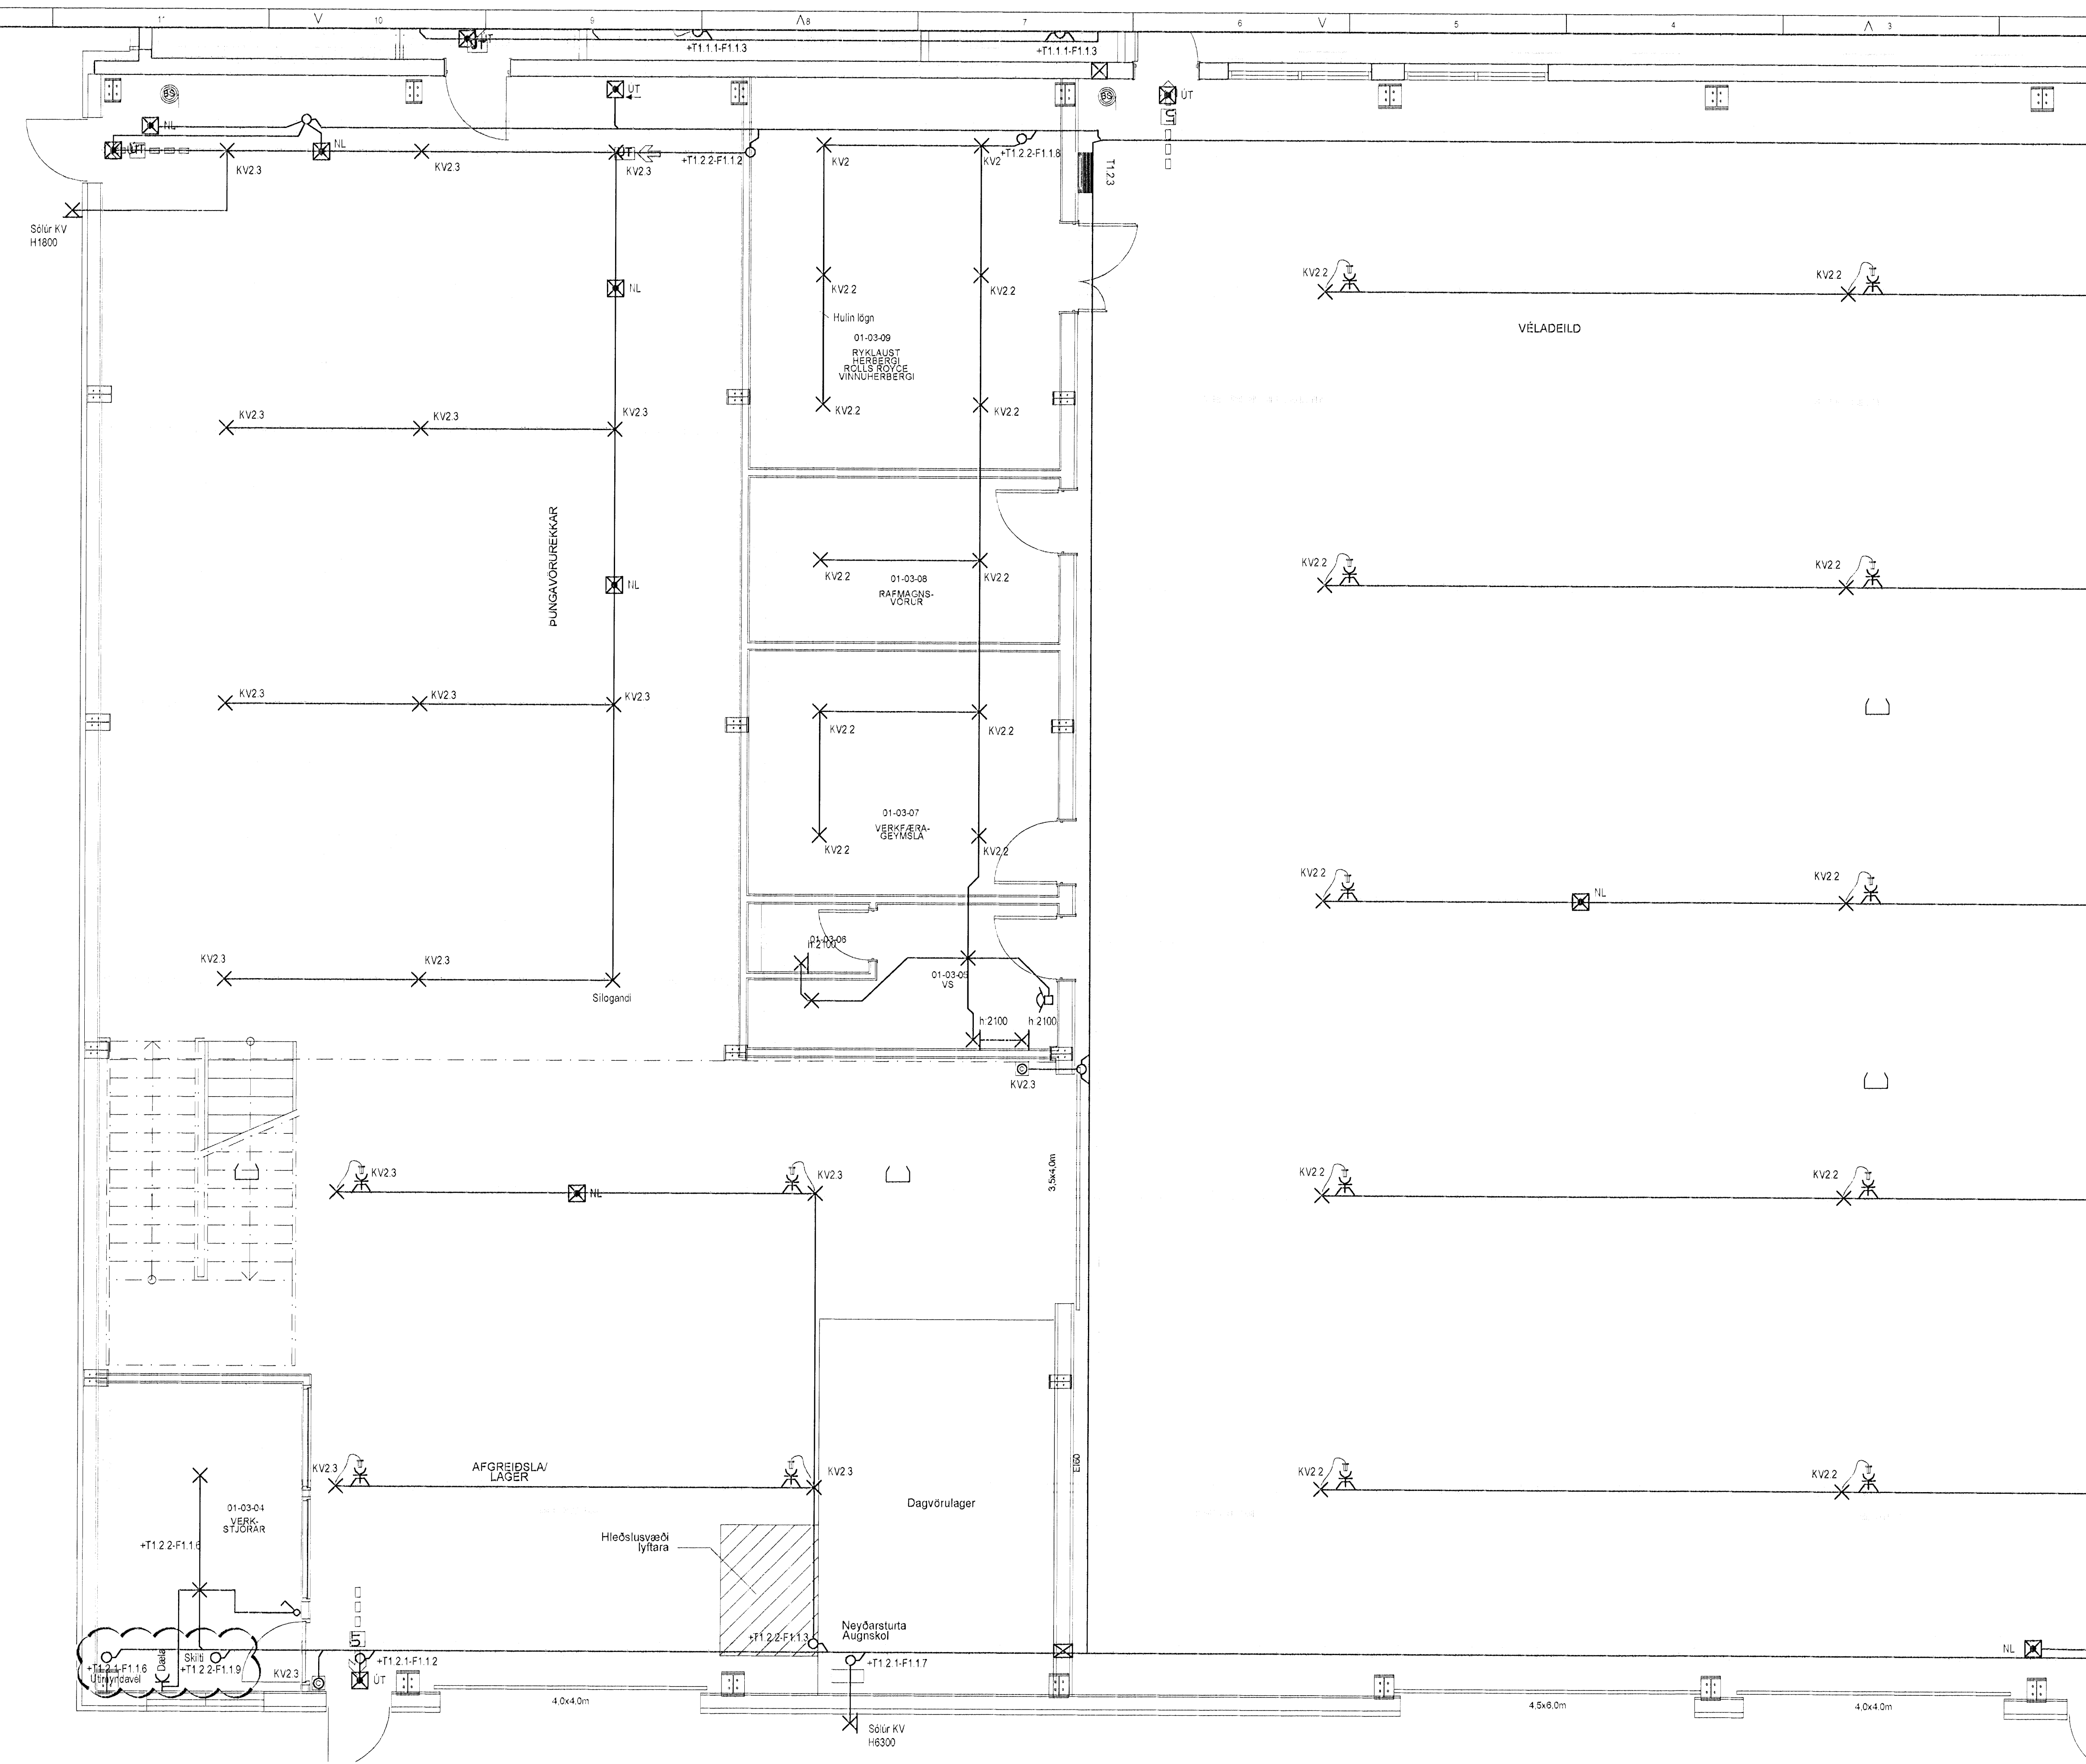

Hönnuður:
ARI HAS
Yfirfarð:
.....
Samþykkt: *[Signature]* kt. 100356-3359

Braytingar:
B1: 12.12.2008 Útmyndavél og skilti
B2: 12.02.2009 Ráunartekning
.....
.....
.....

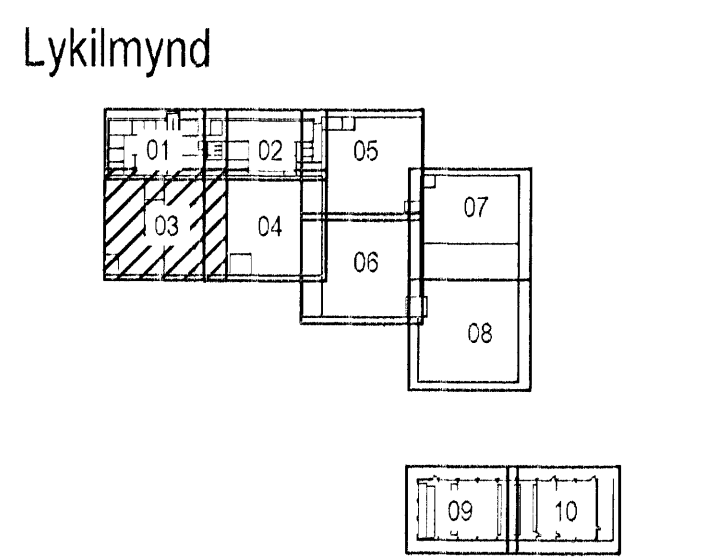

Aðalhönnuður: *[Signature]*
ASK 8. A. MARS 2009
[Signature]

Héðinn
Gjáhella 4
221 Hafnarfjörður

Raflagnir
1. hæð
Mkv: 1:50

VERKFRÆÐISTOFA
Grensásvegur 3
108 Reykjavík
Sími 520 9900
Fax 520 9901
www.rts.is

32-2166-1-
011603 B2
03.04.2008

