


Hönnuður:
ARI, HAS
Yfirfarð:

Samþykkt: Davíð Svavelski kt: 100356-3339

Breytingar:
B1: 02.09.2008 Bætt við greinum vegna lyftu

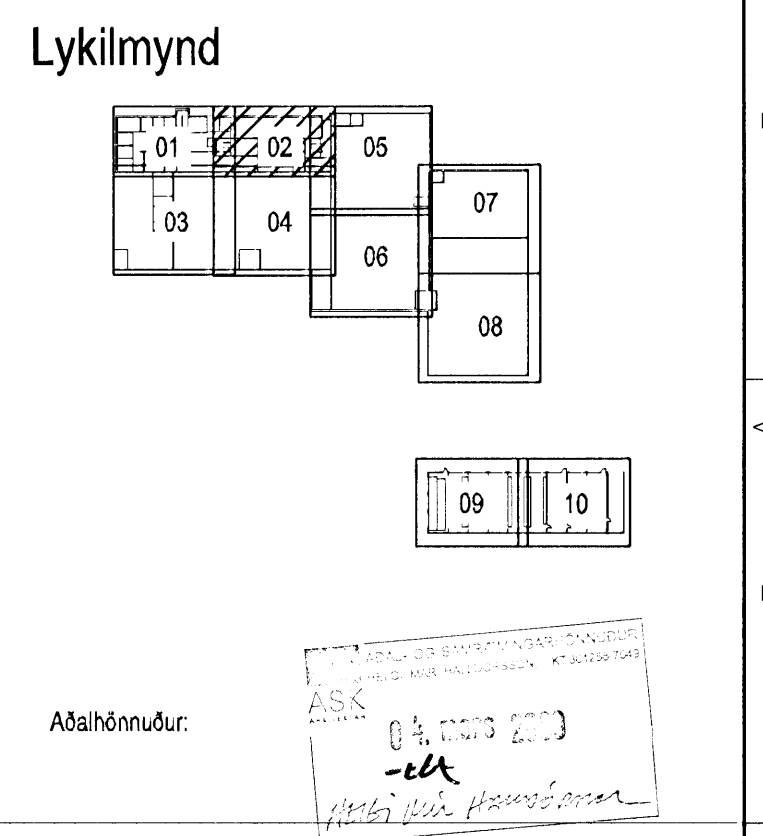

Héðinn
Gjáhella 4
221 Hafnarfjörður

Raflagnir í rennur, rafstiga og gólf
1. hæð
Mkv: 1:50

VERKFRÆDISTOFA

Grensásvegur 3
108 Reykjavík
Sími 520 9900
Fax 520 9901
www.rts.is

Altax gæðvottun skv. BS 241:03:2001:2000
FRV
FS 88744

32-2166-1-
03.04.2008
011702
B1