


1 Tenglastöð; 4x16A, 2x16A-3f., 1x32A-3f.

Hönnuður:
ARI, HAS
Yfirfarir:
Sambýkt: Davíð Svavars
kt: 100356-3339

Breytingar:
B1 12.02.2009 Reyndartekning

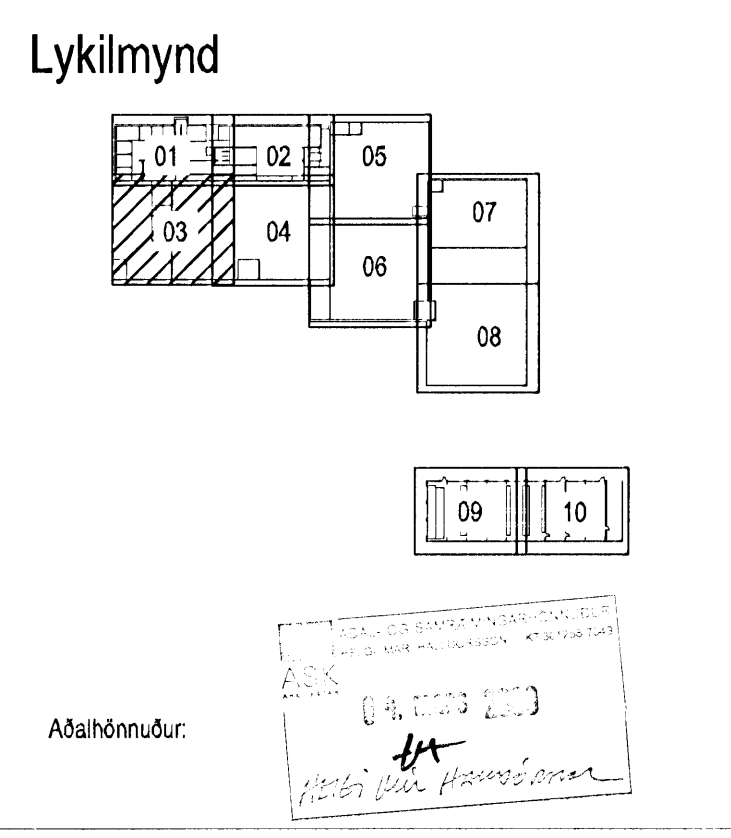

Héðinn
Gjáhella 4
221 Hafnarfjörður

Raflagnir í rennur, rafstiga og gólf
1. hæð
Mkv: 1:50

RIS
VERKFRÆÐISTOFA

Grensásvegur 3
108 Reykjavík
Sími 520 9900
Fax 520 9901
www.rts.is

Altax gæðhöfundur og
SS EN ISO 9001:2000

FRV
FRV
FRV

FS 88744

32-2166-1-
03.04.2008
011703
B1