


16/3/08

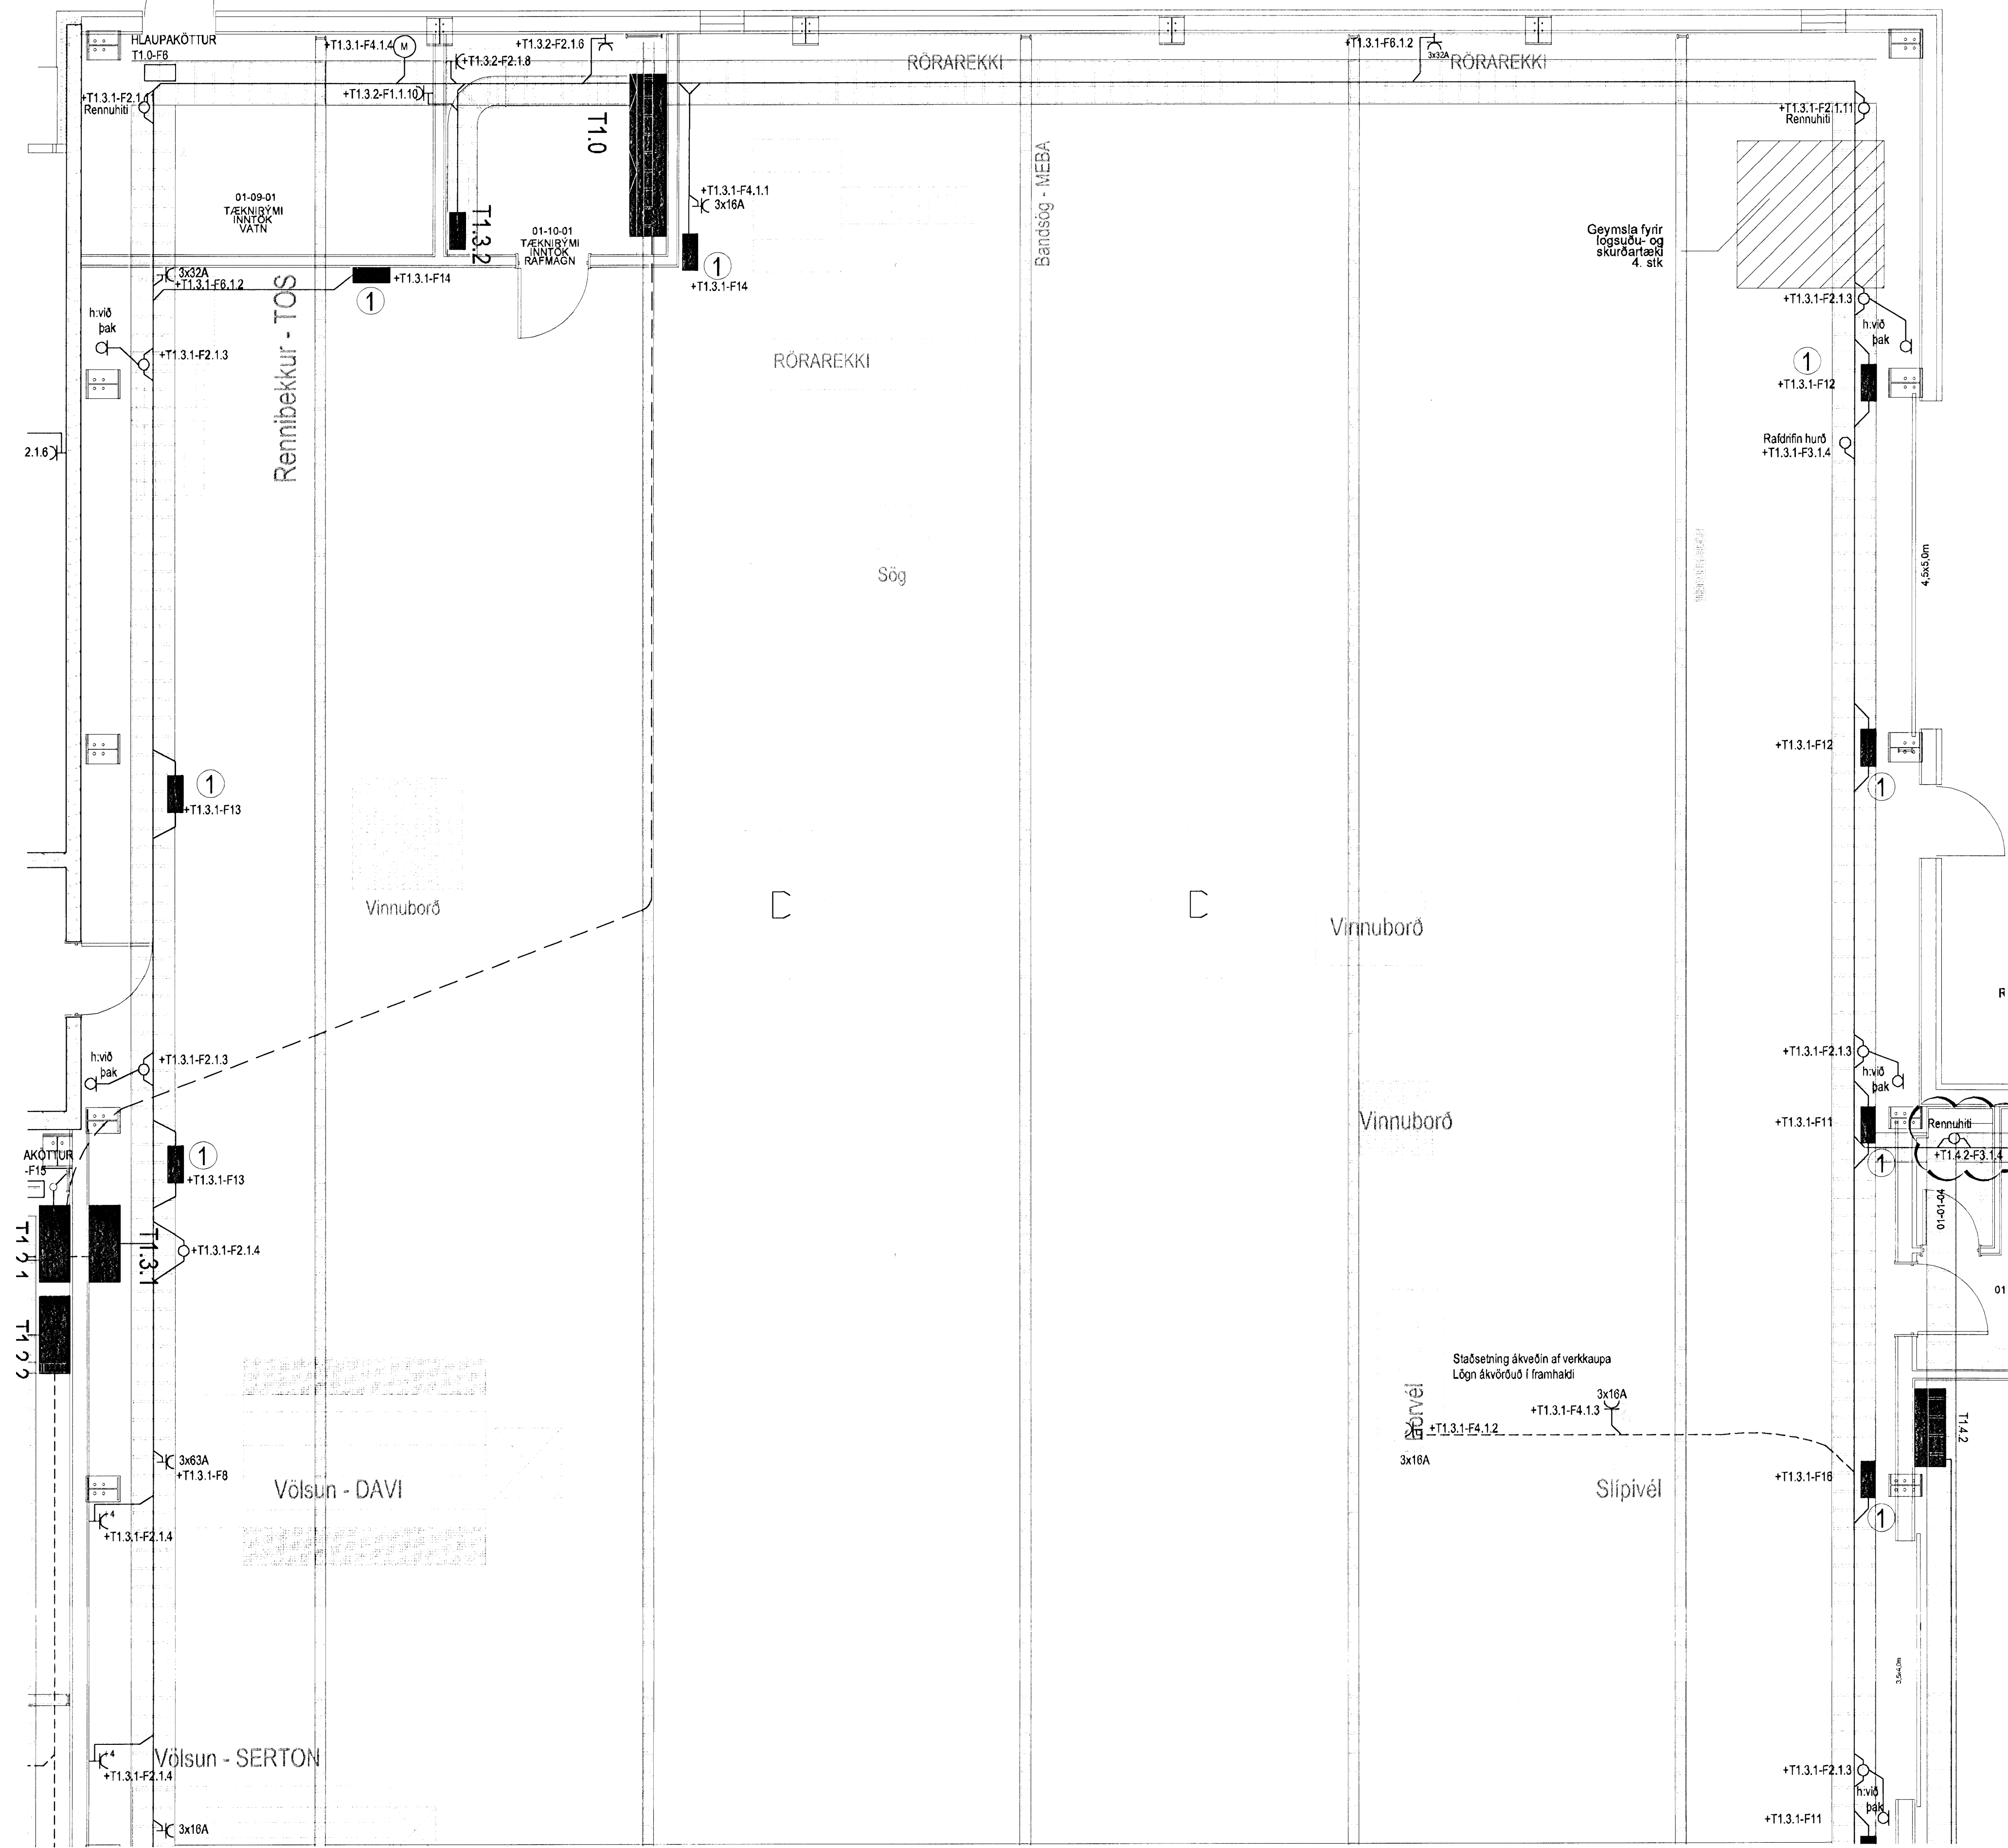


Hönnuður:
ARI, HAS

Yfirfarir:

Sambýkt: Davíð Sósason kt: 100356-3339

Breytingar:
B1: 12.12.2008 Rennuhiti
B2 12.02.2009 Reyndartekning

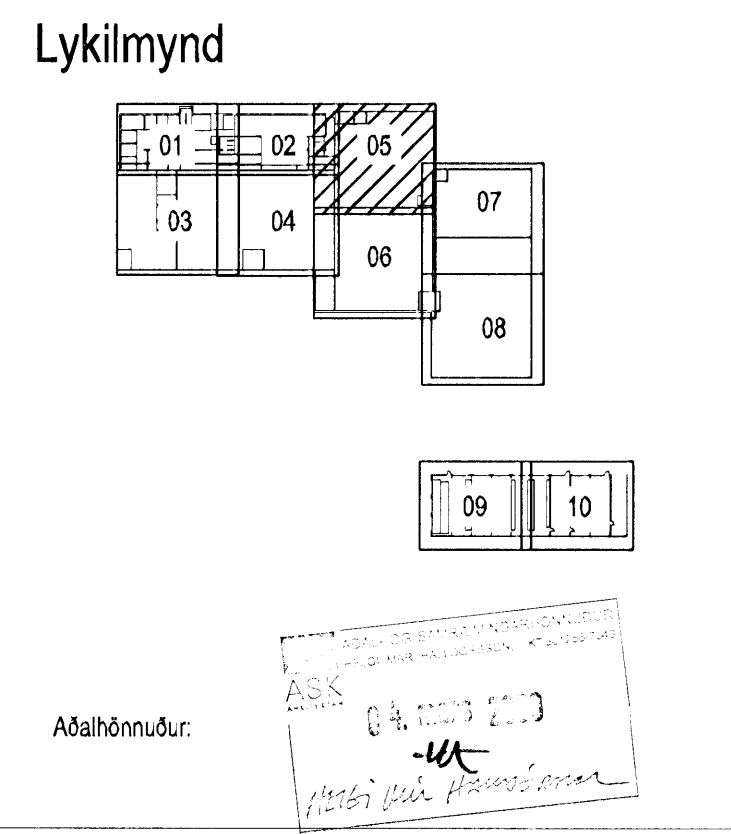

Héðinn
Gjáhella 4
221 Hafnarfjörður


Raflagnir í rennur, rafstiga og gólf
1. hæð
Mkv: 1:50

VERKFRÆÐISTOFA

Grensásvegur 3
108 Reykjavík
Sími 520 9900
Fax 520 9901
www.rfs.is

Altax gæðavottun skv
BS EN ISO 9001:2000

1 Tenglastöð; 4x16A, 2x16A-3f., 1x32A-3f.

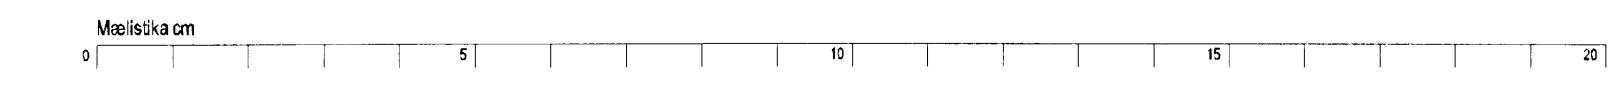

32-2166-1-
03.04.2008

011705 B2