


1 Tenglastöð; 4x16A, 2x16A-3f., 1x32A-3f.

16-3-20

Hönnuður:  
ARI, HAS  
Yfirfarð:  
Samþykkt: Davíð Svavsson kt: 100356-3339


Breytingar:  
B1 12.02.2009 Reyndartekning

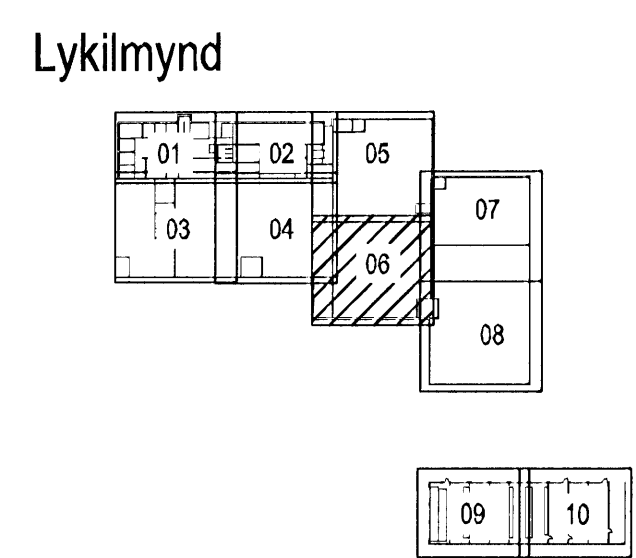

Aðalhönnuður:  
-44

Héðinn  
Gjáhella 4  
221 Hafnarfjörður

Rafagnir í rennur, rafstiga og gólf  
1. hæð  
Mkv: 1:50

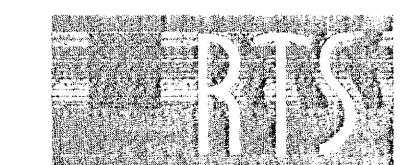

VERKFRÆDISTOFA  
Grensásvegur 3  
108 Reykjavík  
Sími 520 9900  
Fax 520 9901  
www.rts.is



32-2166-1-  
03.04.2008  
011706  
B1