


1 Tenglastöð; 4x16A, 2x16A-3f., 1x32A-3f.

16/3/09

Hönnuður:
ARI, HAS
Yfirfarir:
Sambýkkt: Davíð Svavason kt: 100356-3339

Breytingar:
B1: 12.12.2008 Rennuhiti
B2: 12.02.2009 Reyndartekning

Lykilmynd

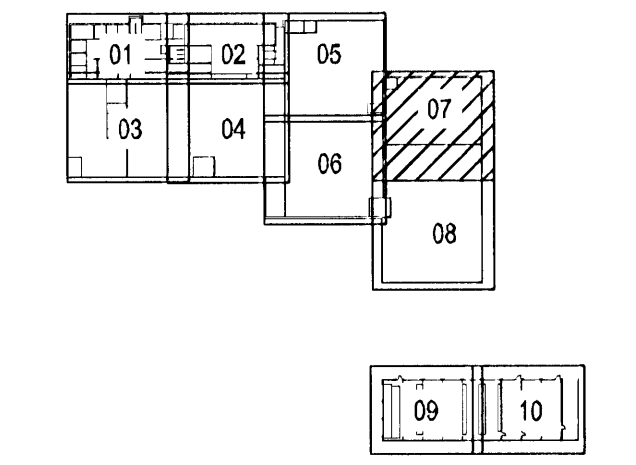

Aðalhönnuður:
ARI, HAS
16/3/09

Héðinn
Gjáhella 4
221 Hafnarfjörður

Raflagnir í rennur, rafstiga og gólf
1. hæð
Mkv: 1:50

RTS
VERKFRÆDISTOFA
Grensásvegur 3
108 Reykjavík
Sími 520 9900
Fax 520 9901
www.rts.is

Áttak gæðvottun sbr BS EN ISO 9001:2000
FRV
FS 88744

32-2166-1-
03.04.2008
011707
B2