


Hönnuður:
ARI, HAS
Yfirfarir:

Samþykkt: Davíð Sólvasar
Kt: 100356-3339

Breytingar:
B1 12.02.2009 Reyndartekning

H1100
+T1.5.1

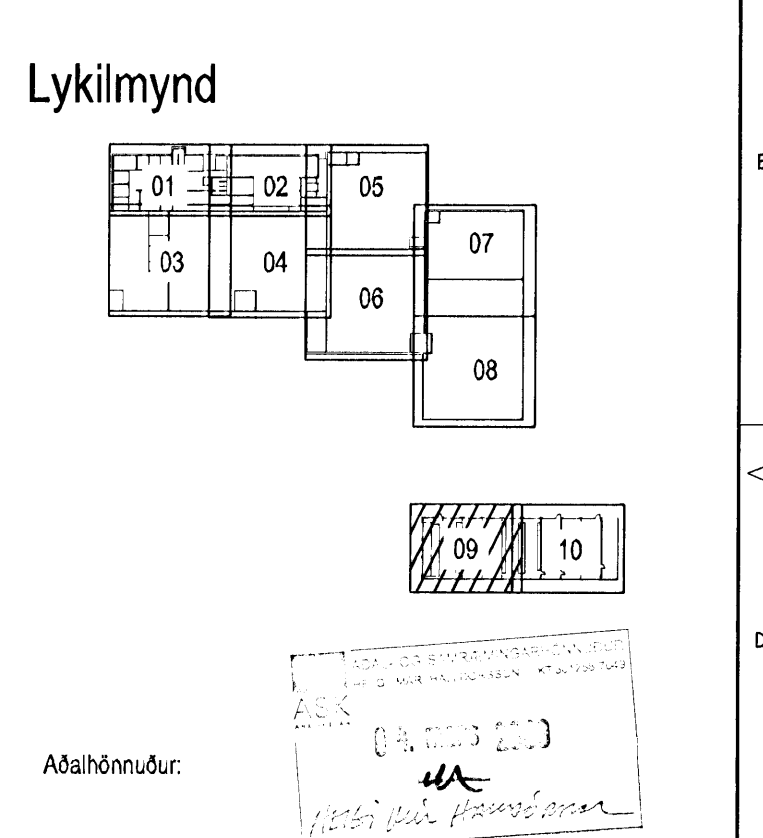

Héðinn
Gjáhella 4
221 Hafnarfjörður

Raflagnir í rennur, rafstiga og gólf
Siberia 1.Hæð
Mkv: 1:50


RTS
VERKFRÆDISTOFA

Grensásvegur 3
108 Reykjavík
Sími 520 9900
Fax 520 9901
www.rts.is

Atak gæðvottun sív
BS EN ISO 9001:2000

FRV
FS 8874

1 Tenglastöð; 4x16A, 2x16A-3f., 1x32A-3f.

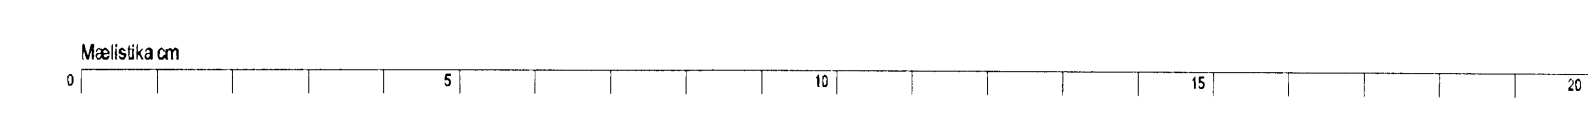

32-2166-1-
03.04.2008
011709
B1