



Mk. 16/3 '09 J

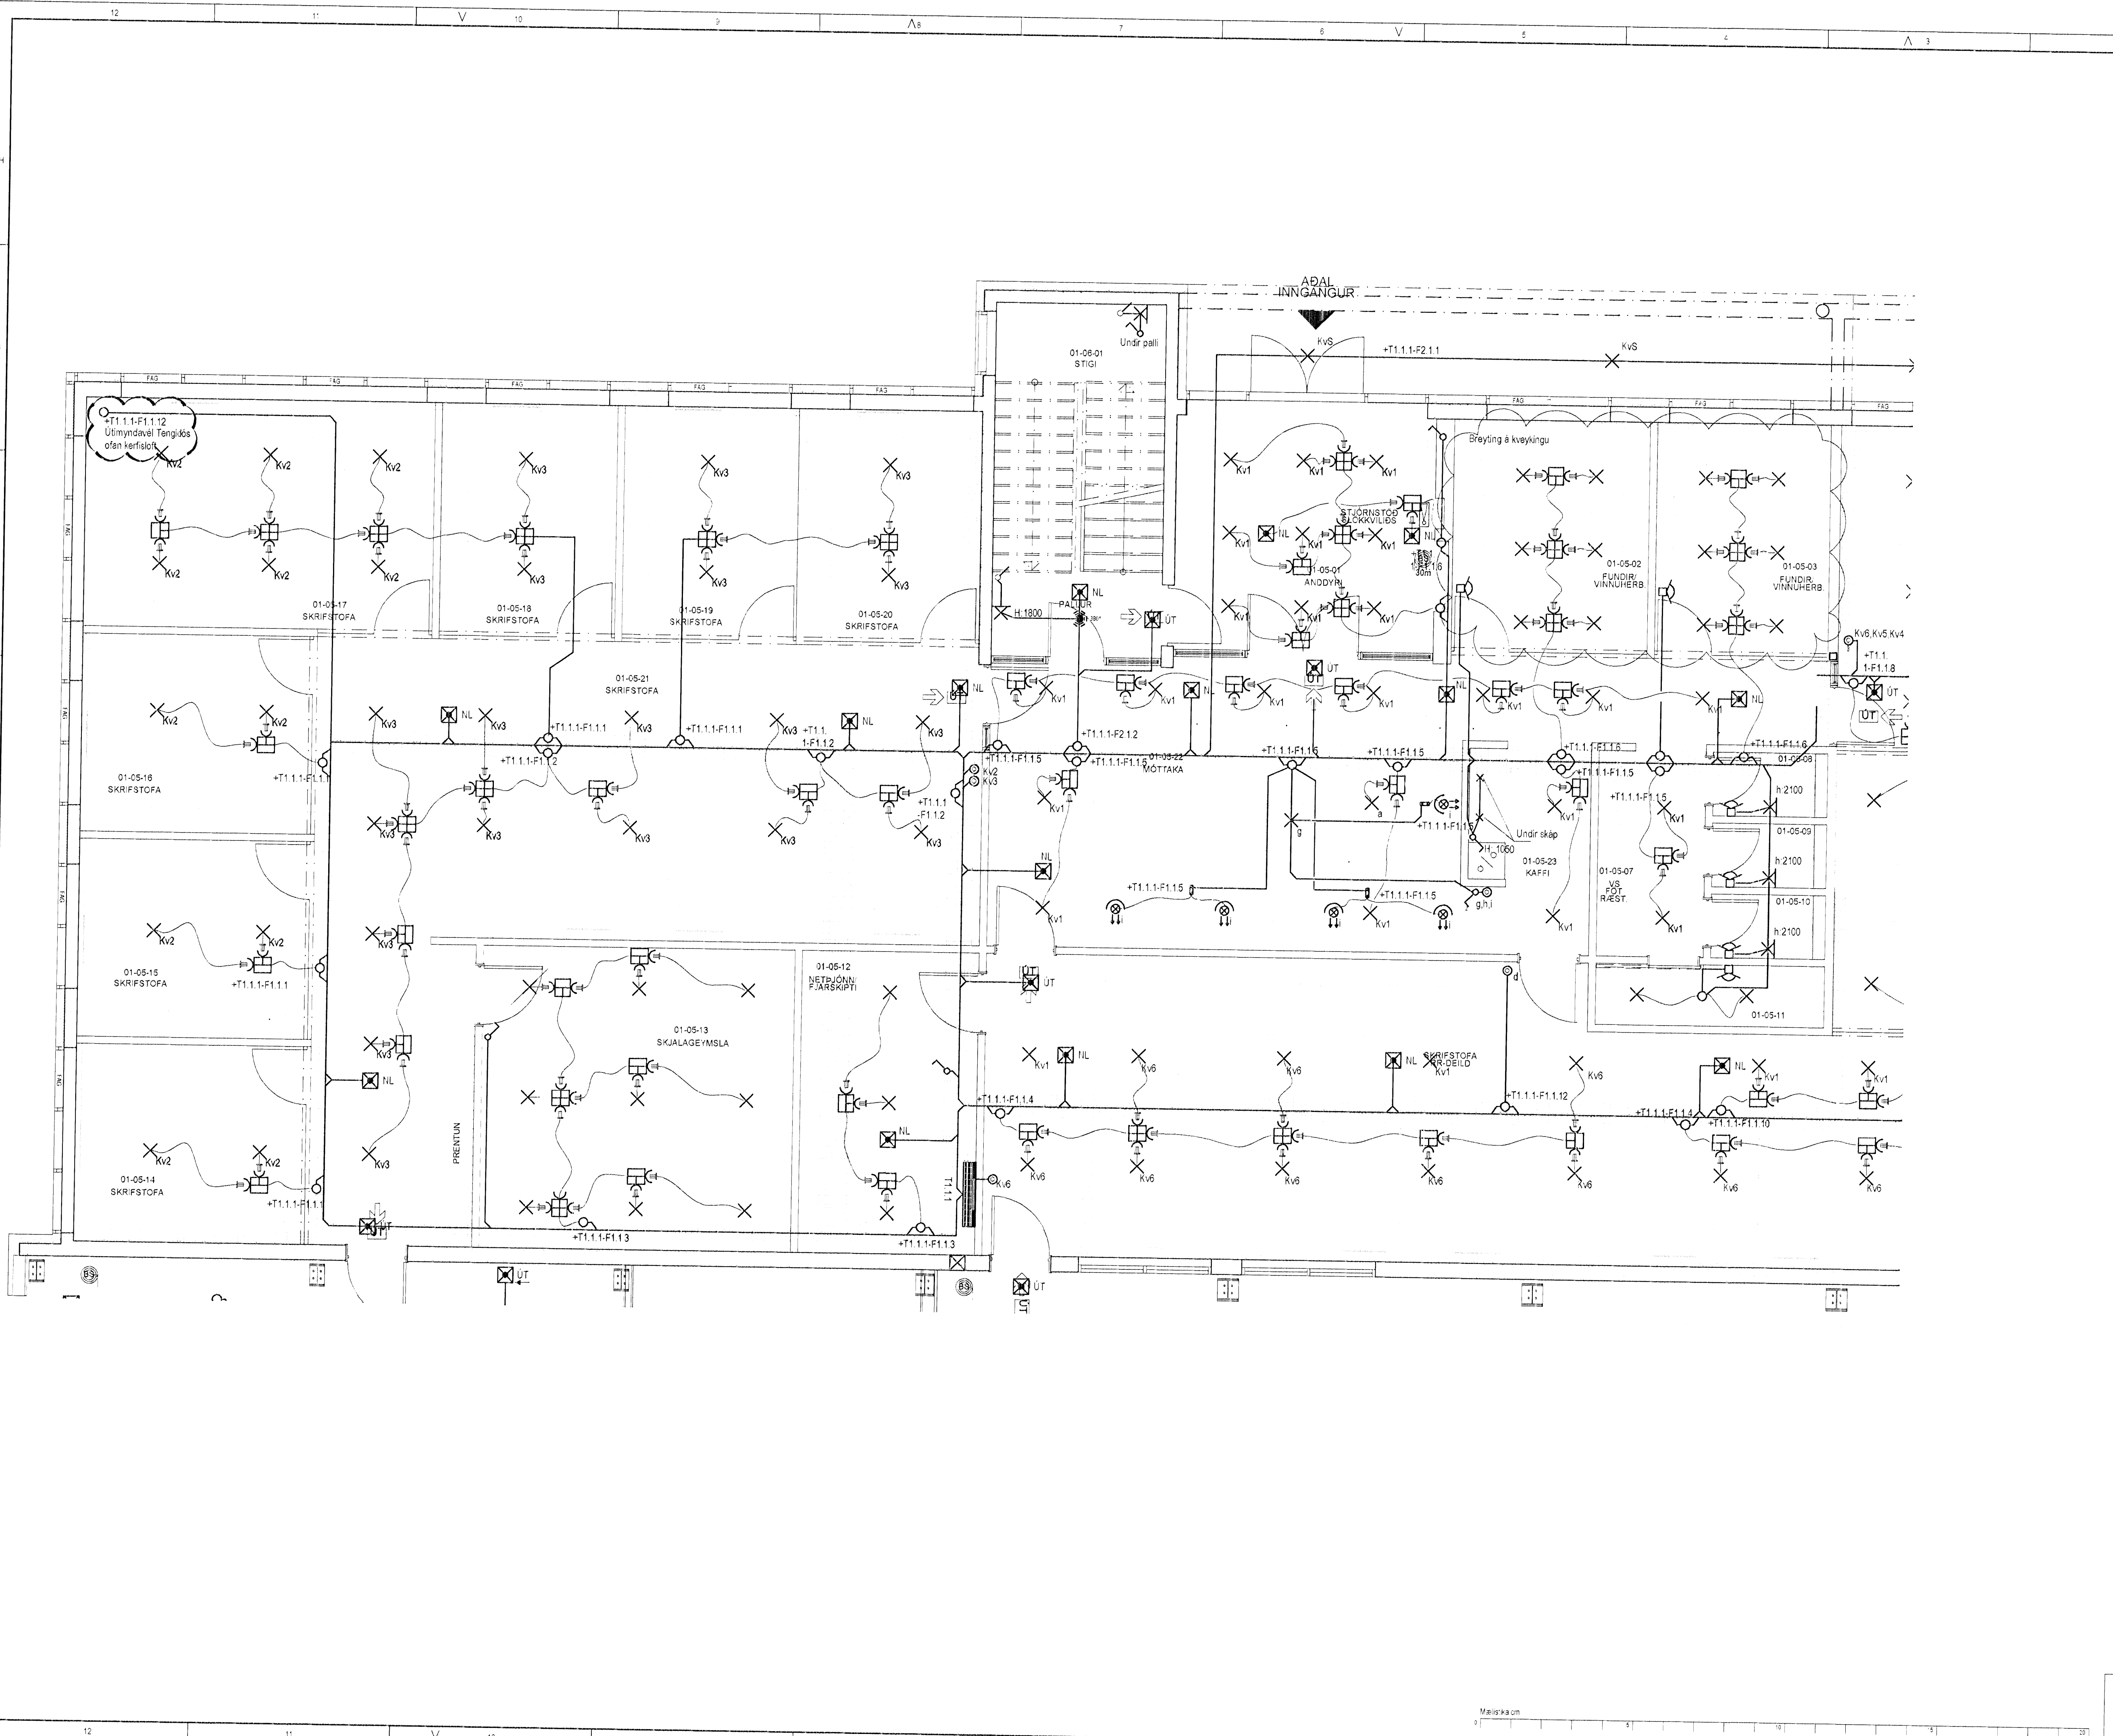

Hönnuður:
ARI, HAS
Yfirferð:
.....
Sambýkt: Davíð Jónsson kt. 100358-3339

Brýtingar:
B1: 12.12.2008 Útmyndavél
.....
.....
.....
.....
.....

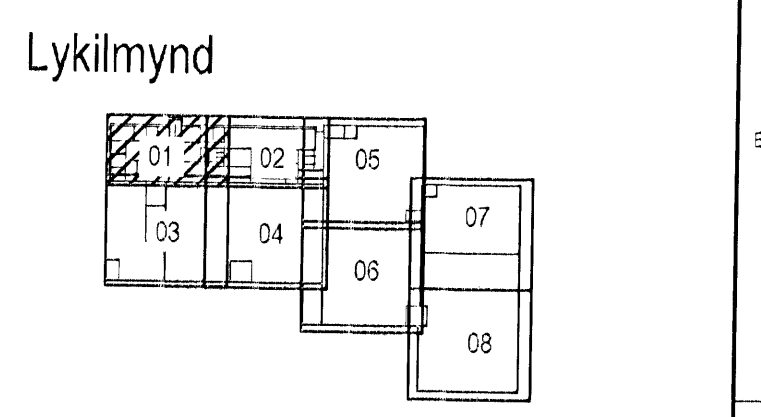

Aðalhönnuður:
04.09.2008
ut
Davíð Jónsson

Héðinn
Gjáhella 4
221 Hafnarfjörður

Raflagnir
1. hæð
Mkv: 1:50

VERKFRÆÐISTOFA
Grensásvegur 3
108 Reykjavík
Sími 520 9900
Fax 520 9901
www.rts.is

Alfríð gestvottur skv.
BS EN ISO 9001:2000

FS 8874

32-2166-1-
03.04.2008

011601

B1