


Úr Gildi

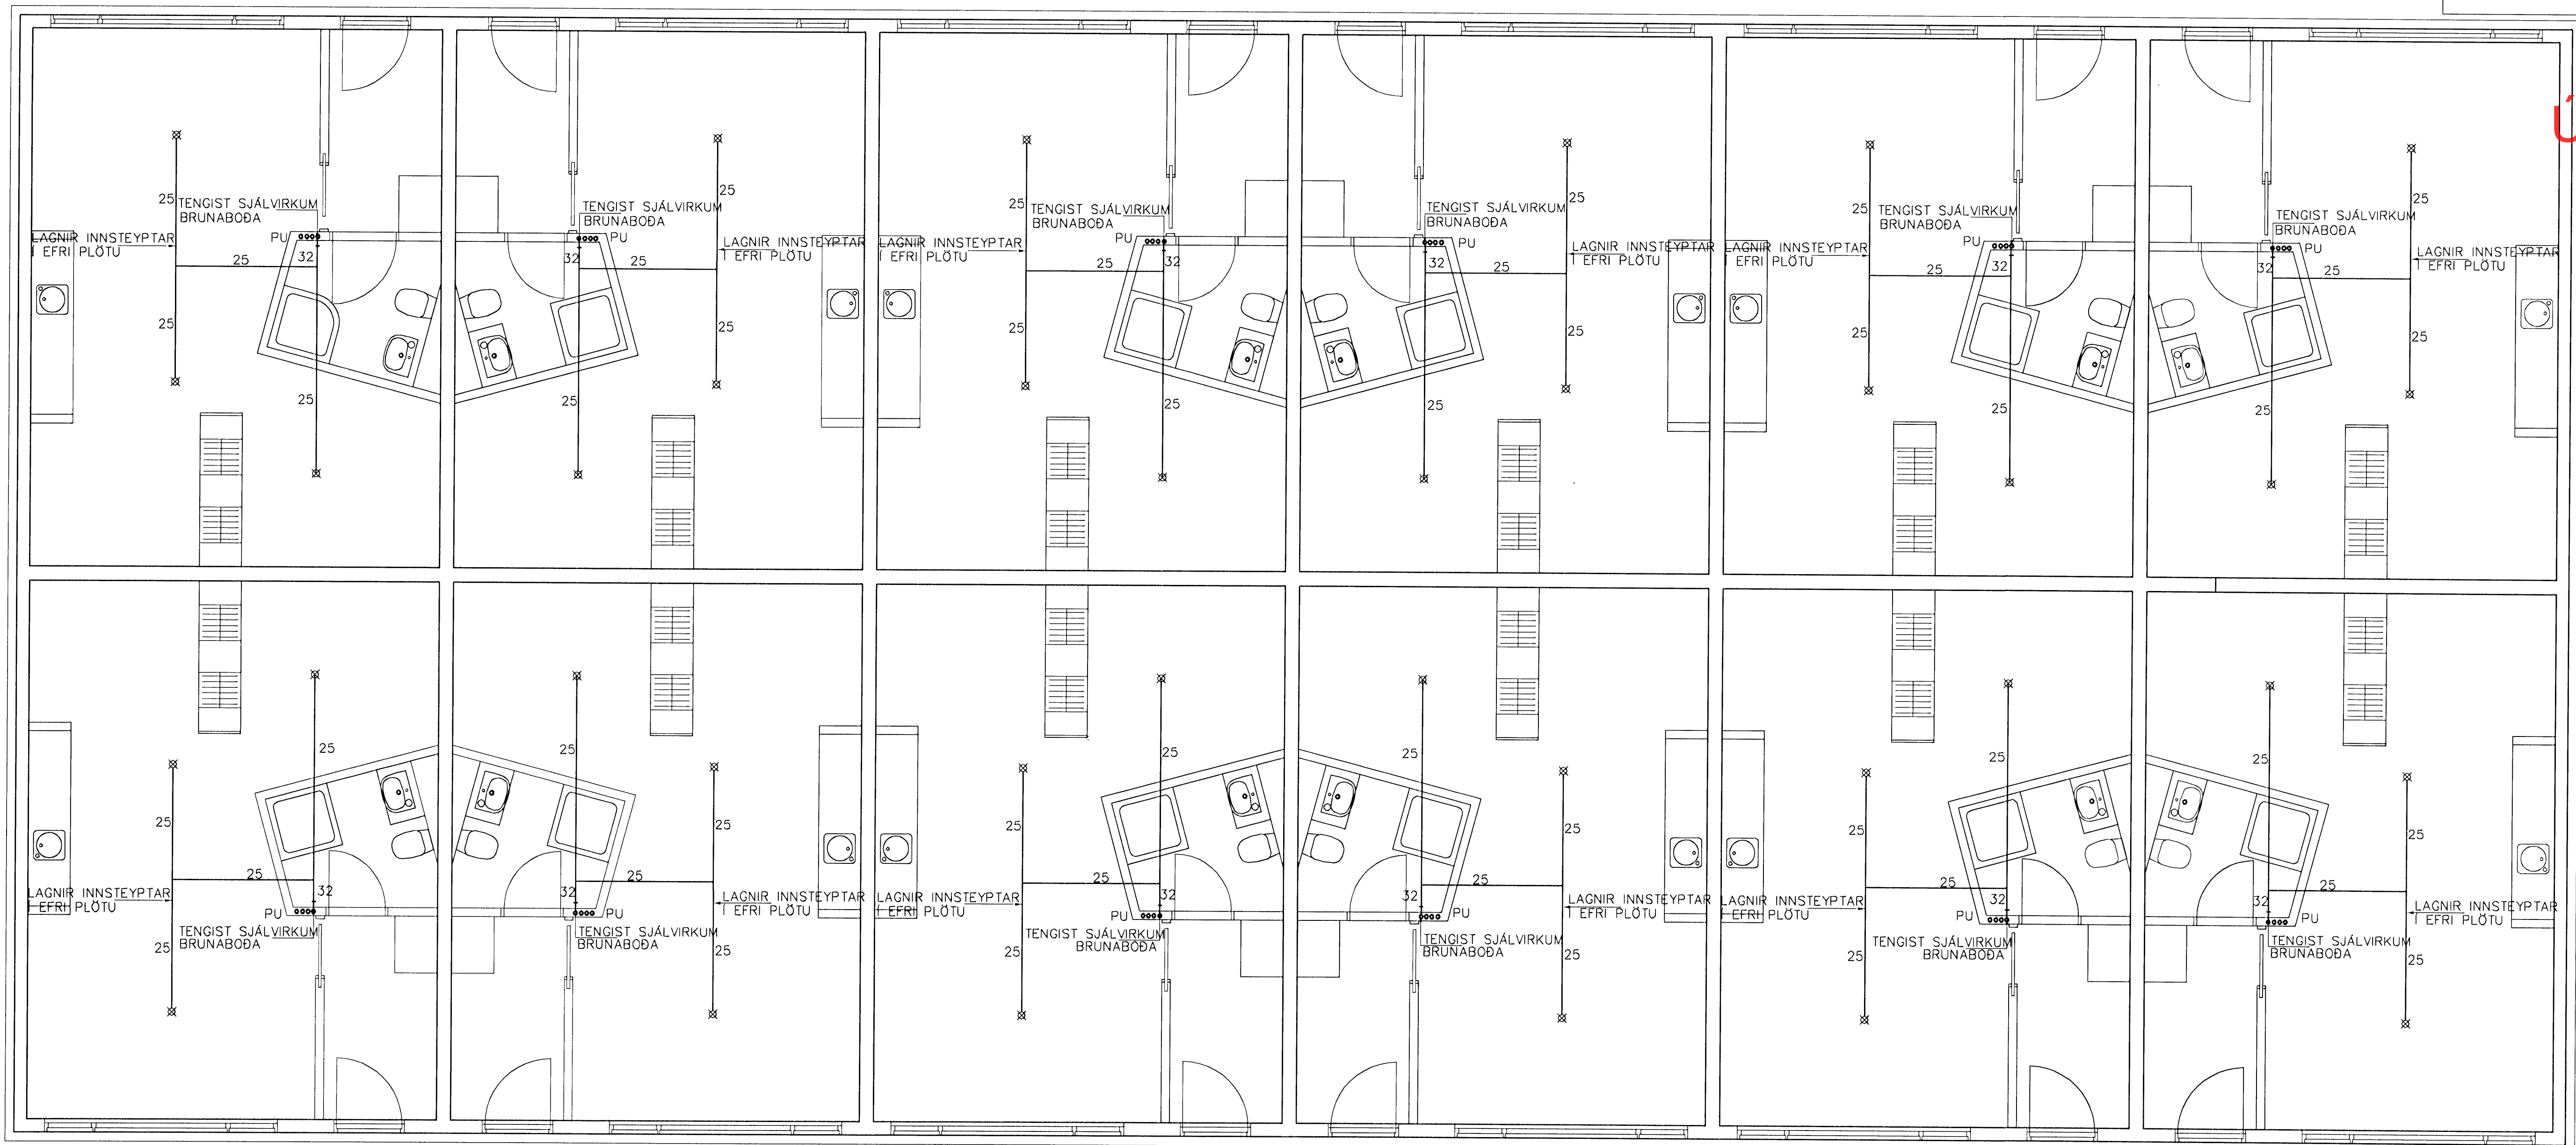

GRUNNMYND 1 HÆÐAR 1:50

Br.	Dags.	Eðli breytinga	Sign
BJARKAVELLIR 1A HAFNARFIRÐI ÚÐAKERFI 1 HÆÐAR			
MKV. 1:50 1:20			
DAGS. APRIL 2009			
VERK NR. 2808			
TEIKN. NR. 2-17			
HANNAD SIG. ÞORLEIFSS. KT. 241148-3009			
TEIKNAD G.H.			
YFIRFARIÐ			
TÆKNIPJÓNUSTA SIGURDAR ÞORLEIFSSONAR ehf STRANDGÖTU 11 220 HAFNARFIRÐI Sími 555-4255 FAX 565-2875 E-mail ts@simnet.is kt: 440693-2539			

Handwritten signature