



16-4-09

AC

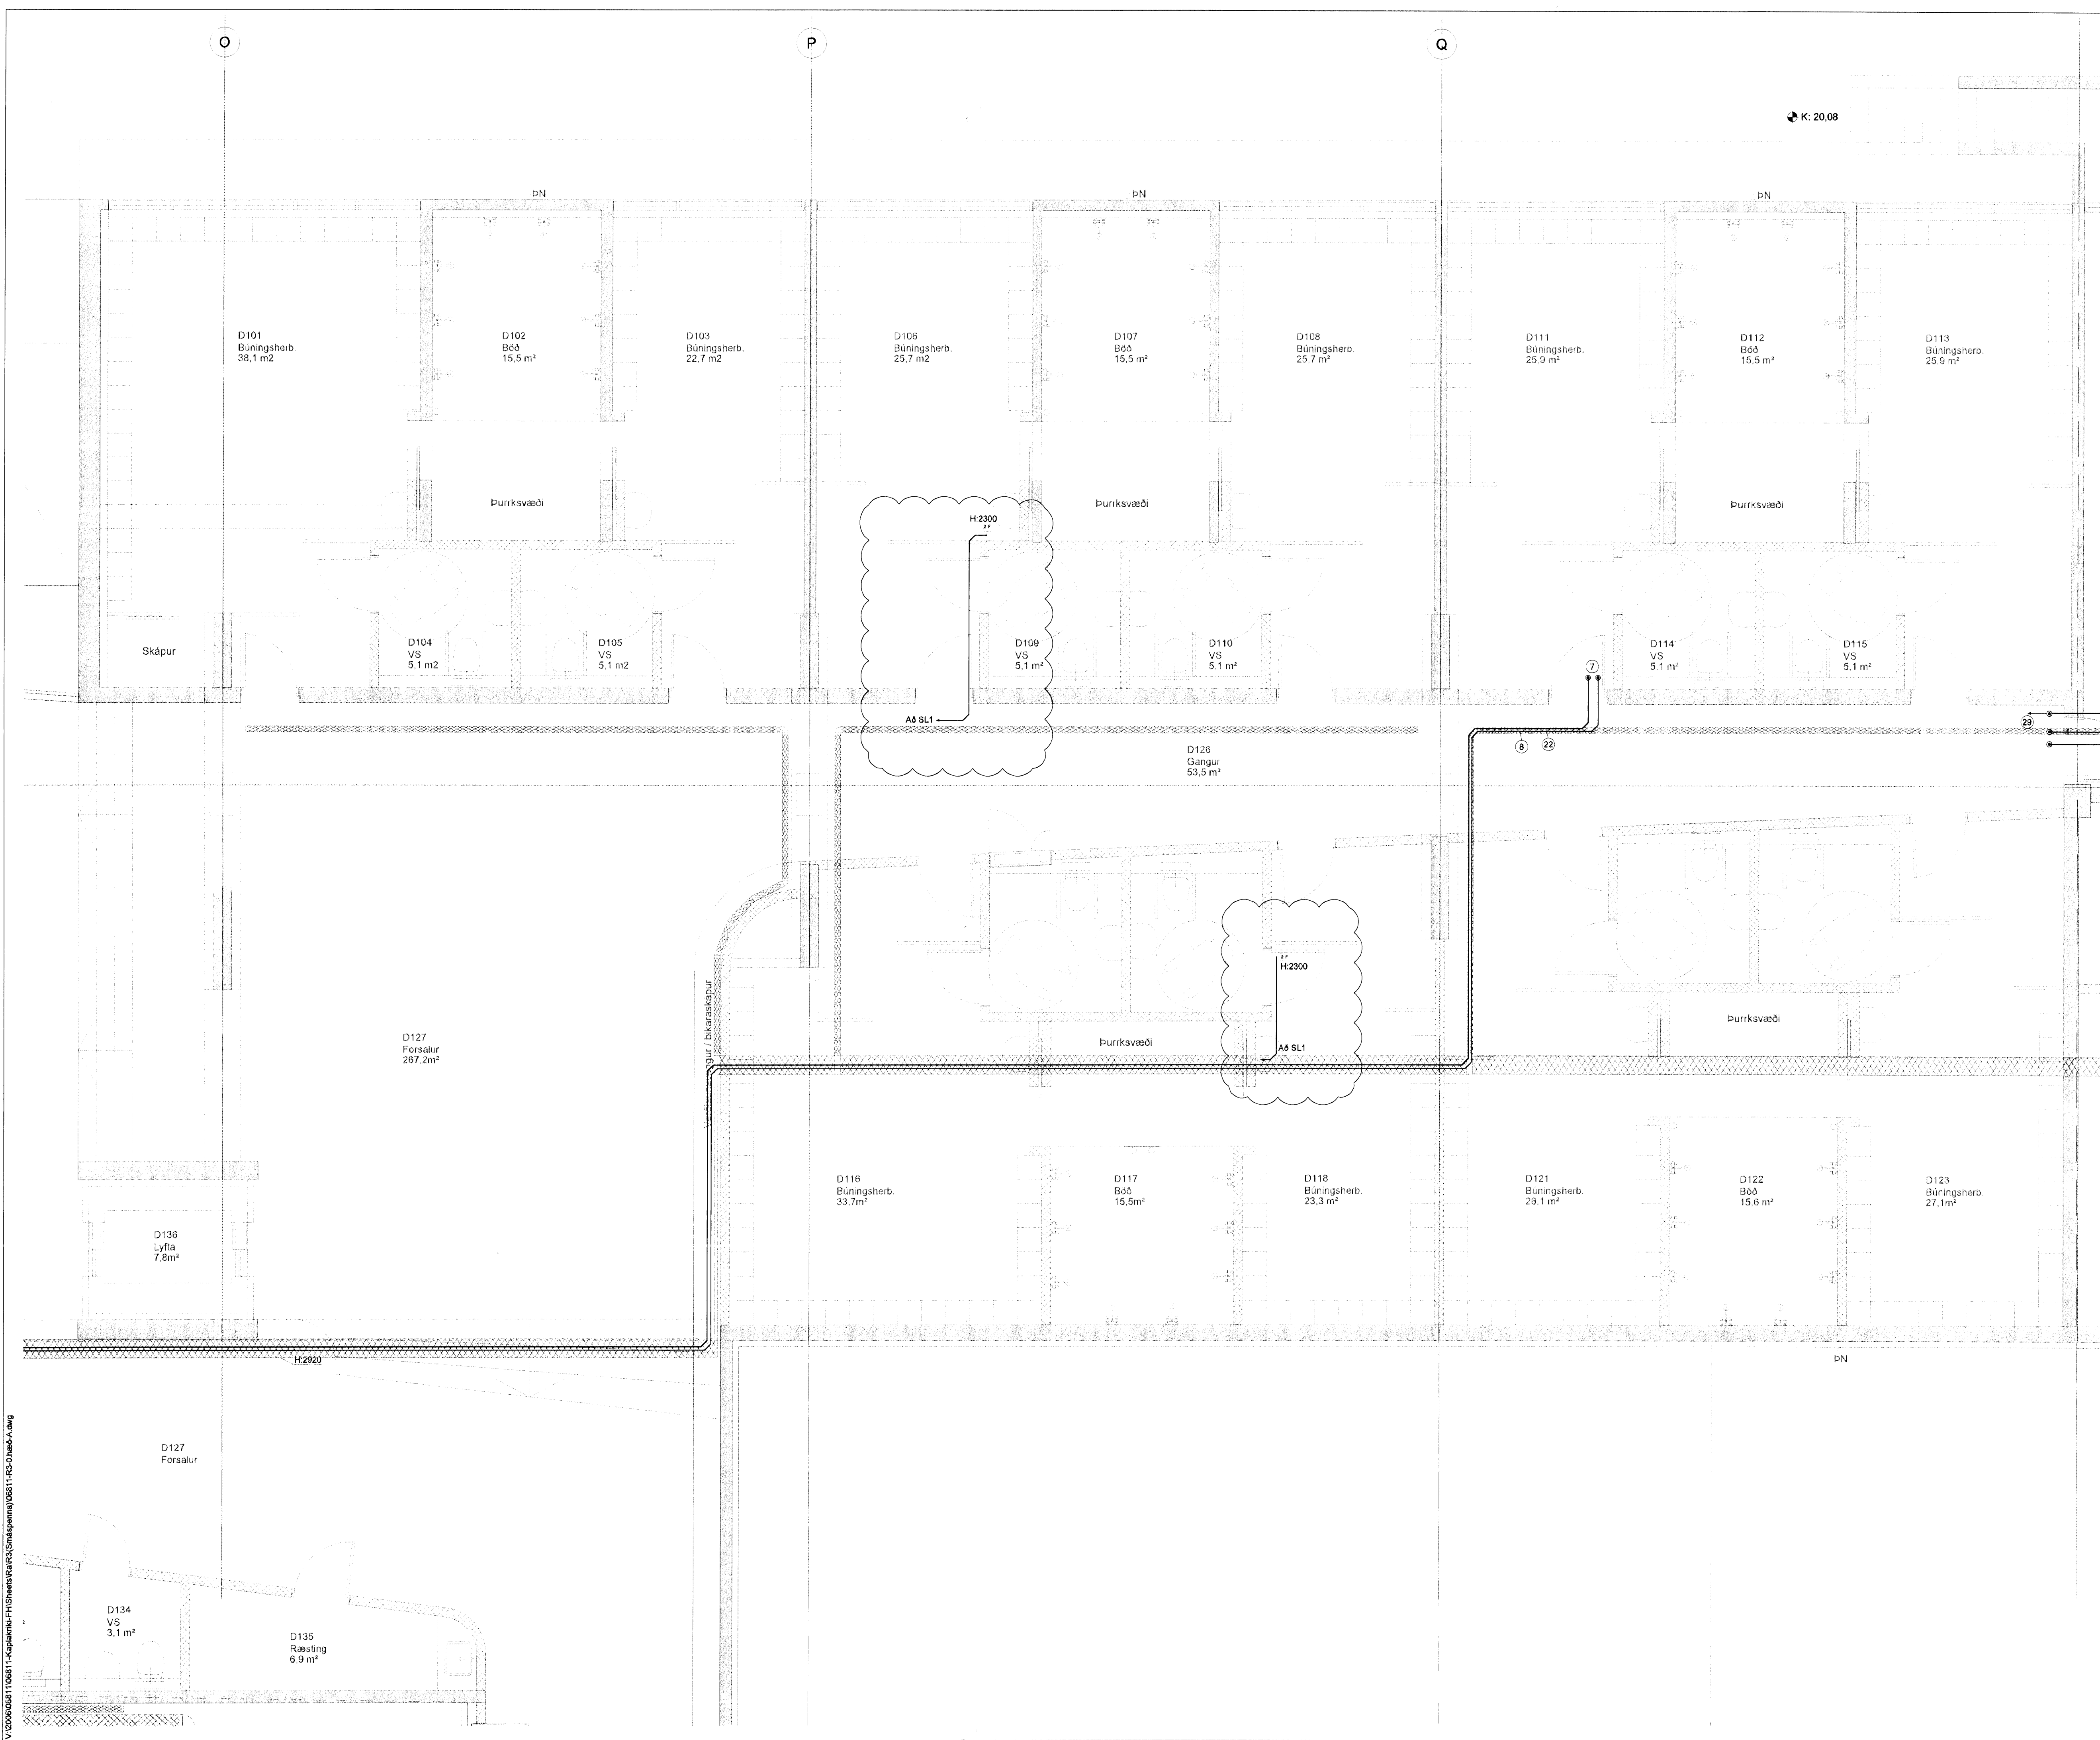

[Signature]
Kt. 110457-2789

KAPLAKRIKI

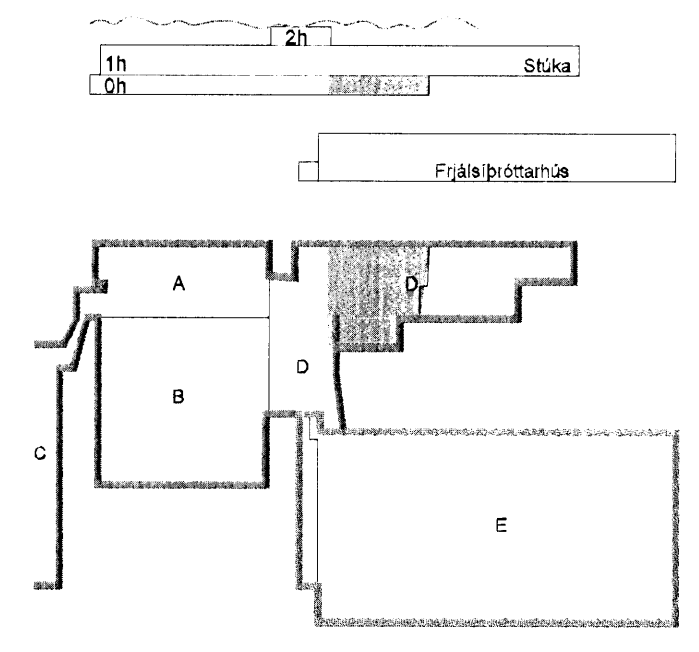

D	08.04.09	Bætt við tenglum	SF/OG
C	29.07.08	Stigum breytt	SF/OG
B	25.02.08	Tæknijými færlist á teikningu A R304	BSO/OG
A	27.11.07	Verkefning	RVK/HJ
Útg.	Dags.	Skýring	Hannas/Yfirfarir



VERKFRÆÐISTOFA

BÆJARHRAUN 20 · 220 HAFNARFJÖRDUR · KENNIT. 710796-2899
vsb@vsb.is · Sími 585 8600 · Fax 585 8610 · www.vsb.is

Áritun sérhönnuðar
Örn Guðmundsson Kt: 220961 2739

**KAPLAKRIKI
HAFNARFIRÐI**

Verkhúsi
Rafkerfi
Smáspenna 0.hæð
Grunnmynd

Hannas	Teiknas	Yfirfarir	Kvali	Síða
RVK/HJ	RVK/HJ	RVK	1:50	/ A1
Dags:	Verkefni	Teikning	Útgáfa	
30.04.2007	06811	A R303	D	

V:\0306\0811\0811-Kaplakriki-FH\Sheets\RaR3\Smáspenna\0811-R3-0.hæð-A.dwg